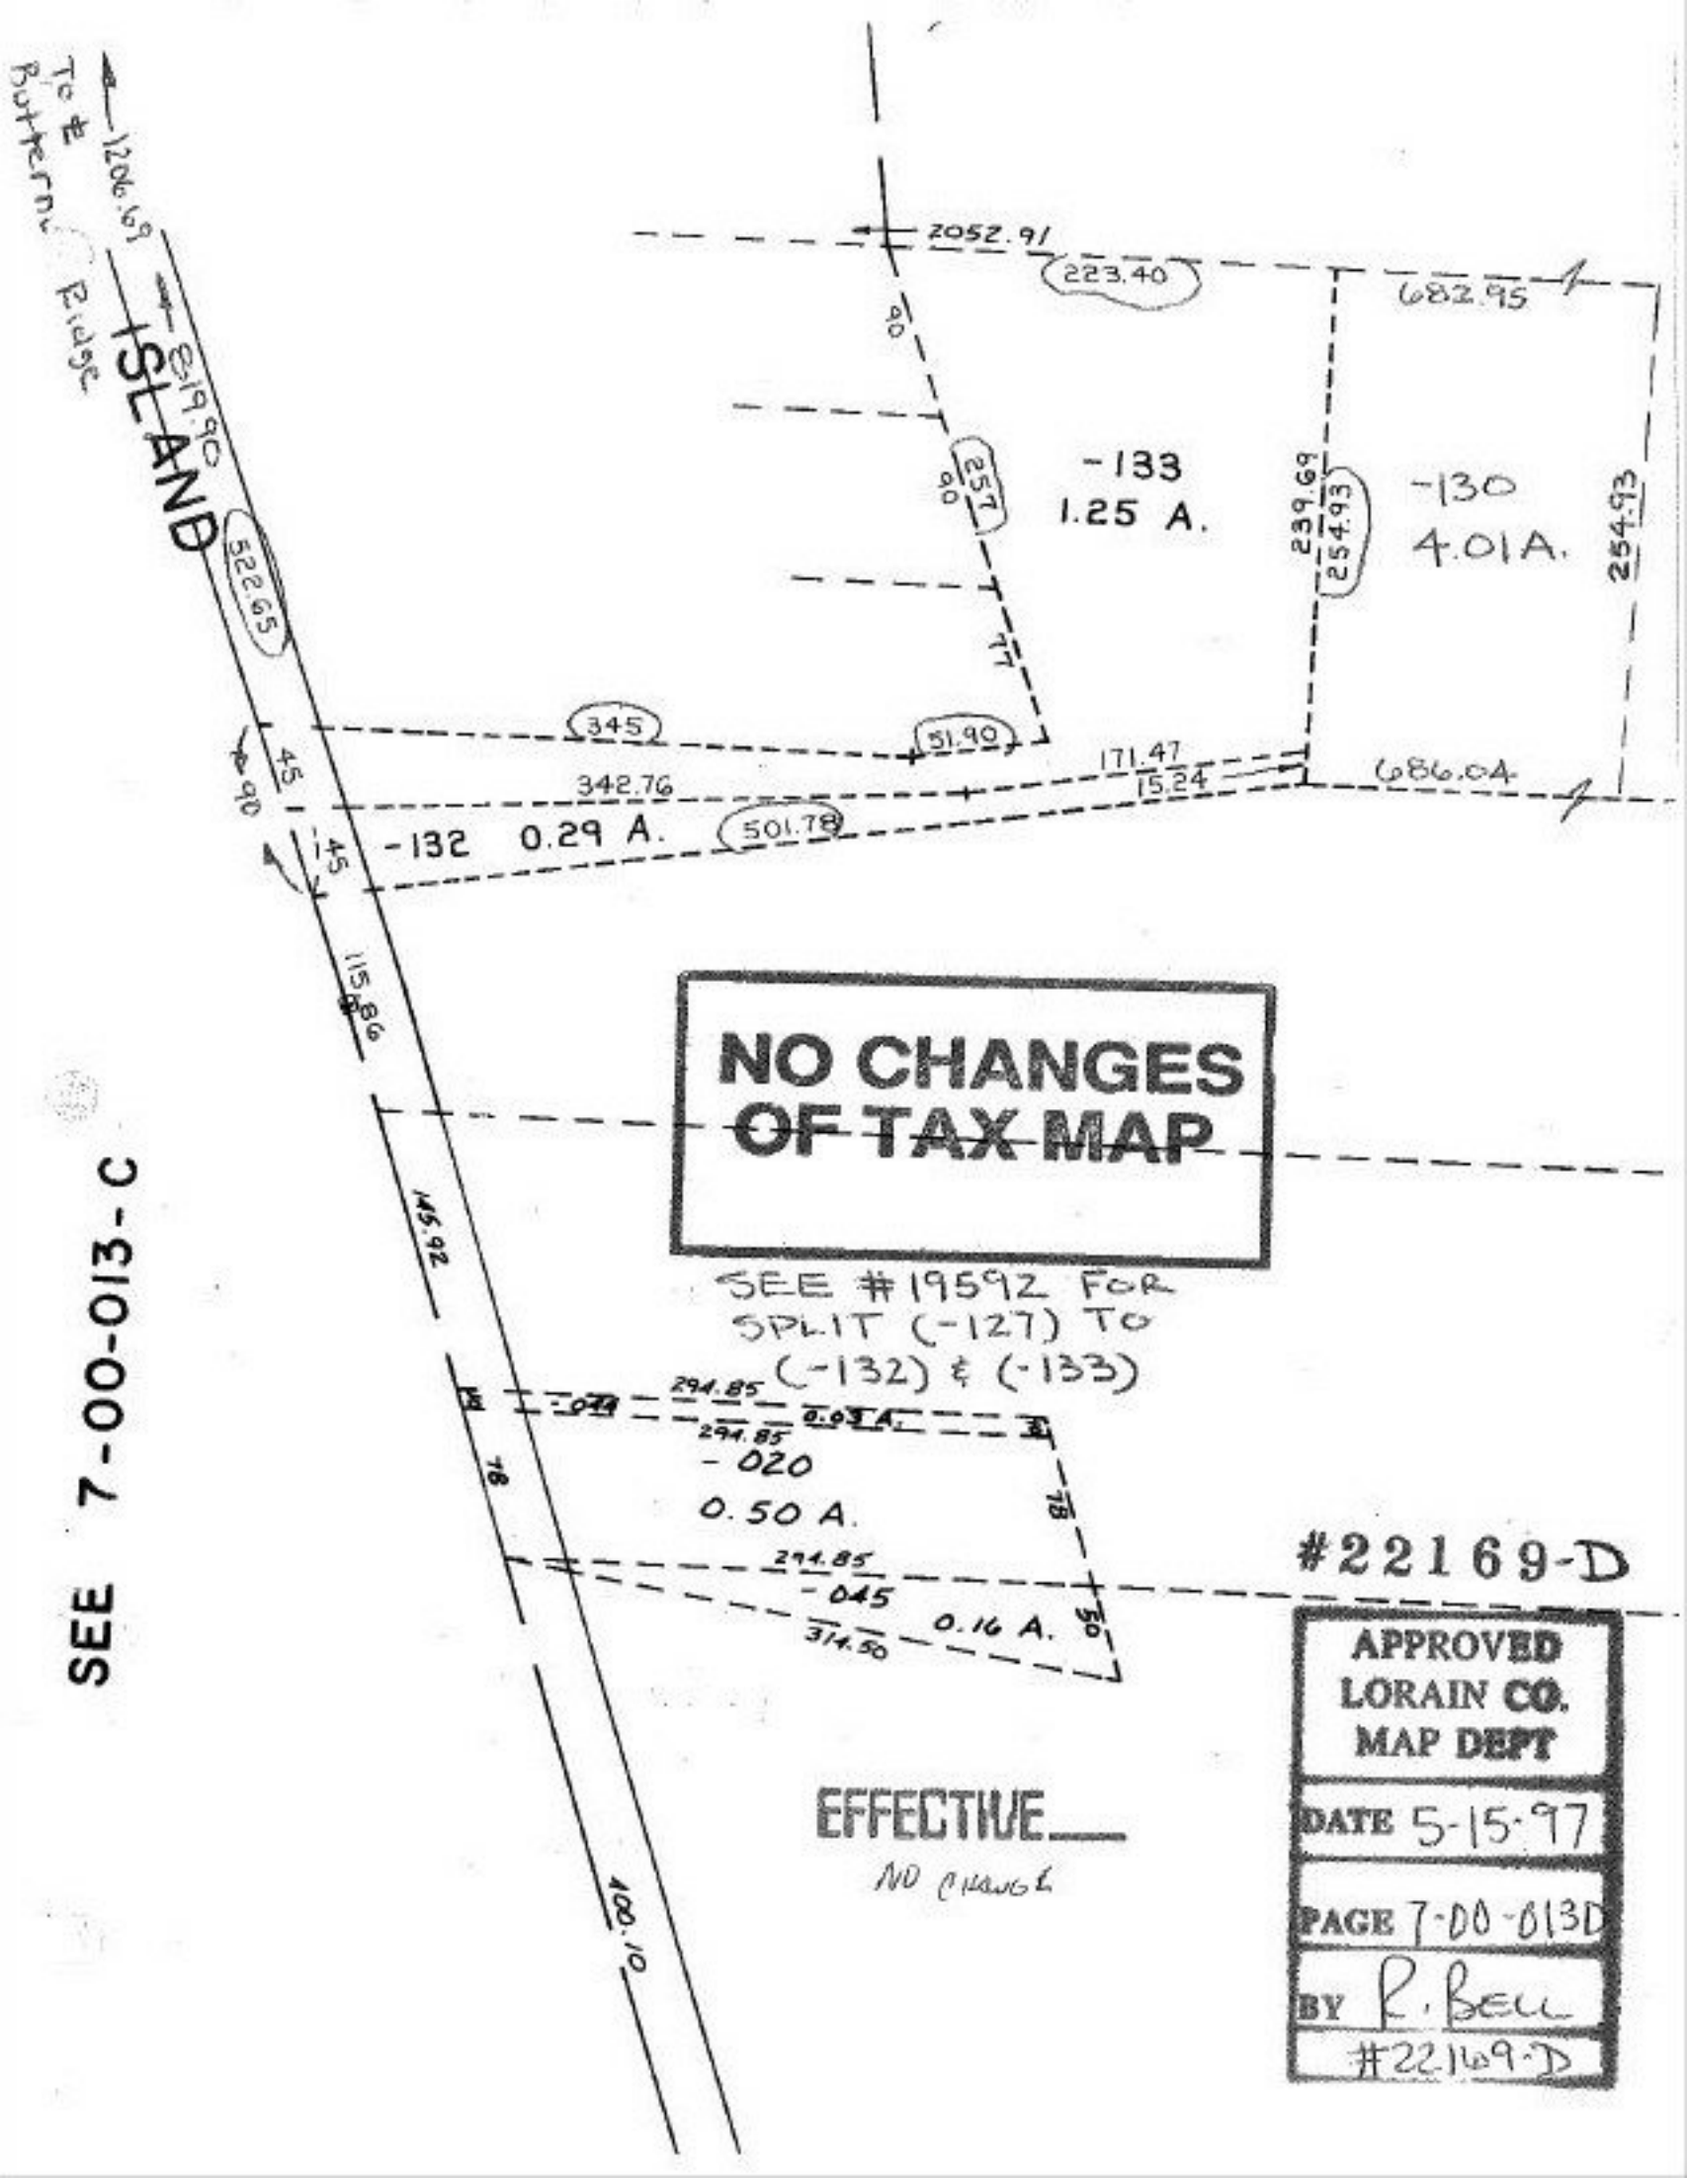
1206.69
To #
Butternut
Ridge
ISLAND
819.90
522.65
2052.91
223.40
682.95
90
257
90
-133
1.25 A.
239.69
254.93
-130
4.01A.
254.93
345
51.90
45
90
342.76
171.47
15.24
686.04
-132 0.29 A.
501.78
45
115.86
145.92
NO CHANGES
OF TAX MAP
SEE #19592 FOR
SPLIT (-127) TO
(-132) & (-133)
294.85
-020
0.50 A.
294.85
-045
0.16 A.
314.50
#22169-D
APPROVED
LORAIN CO.
MAP DEPT
DATE 5-15-97
PAGE 7-00-013D
BY R. Bell
#22169-D
EFFECTIVE
NO CHANGE
100.10
SEE 7-00-013-C