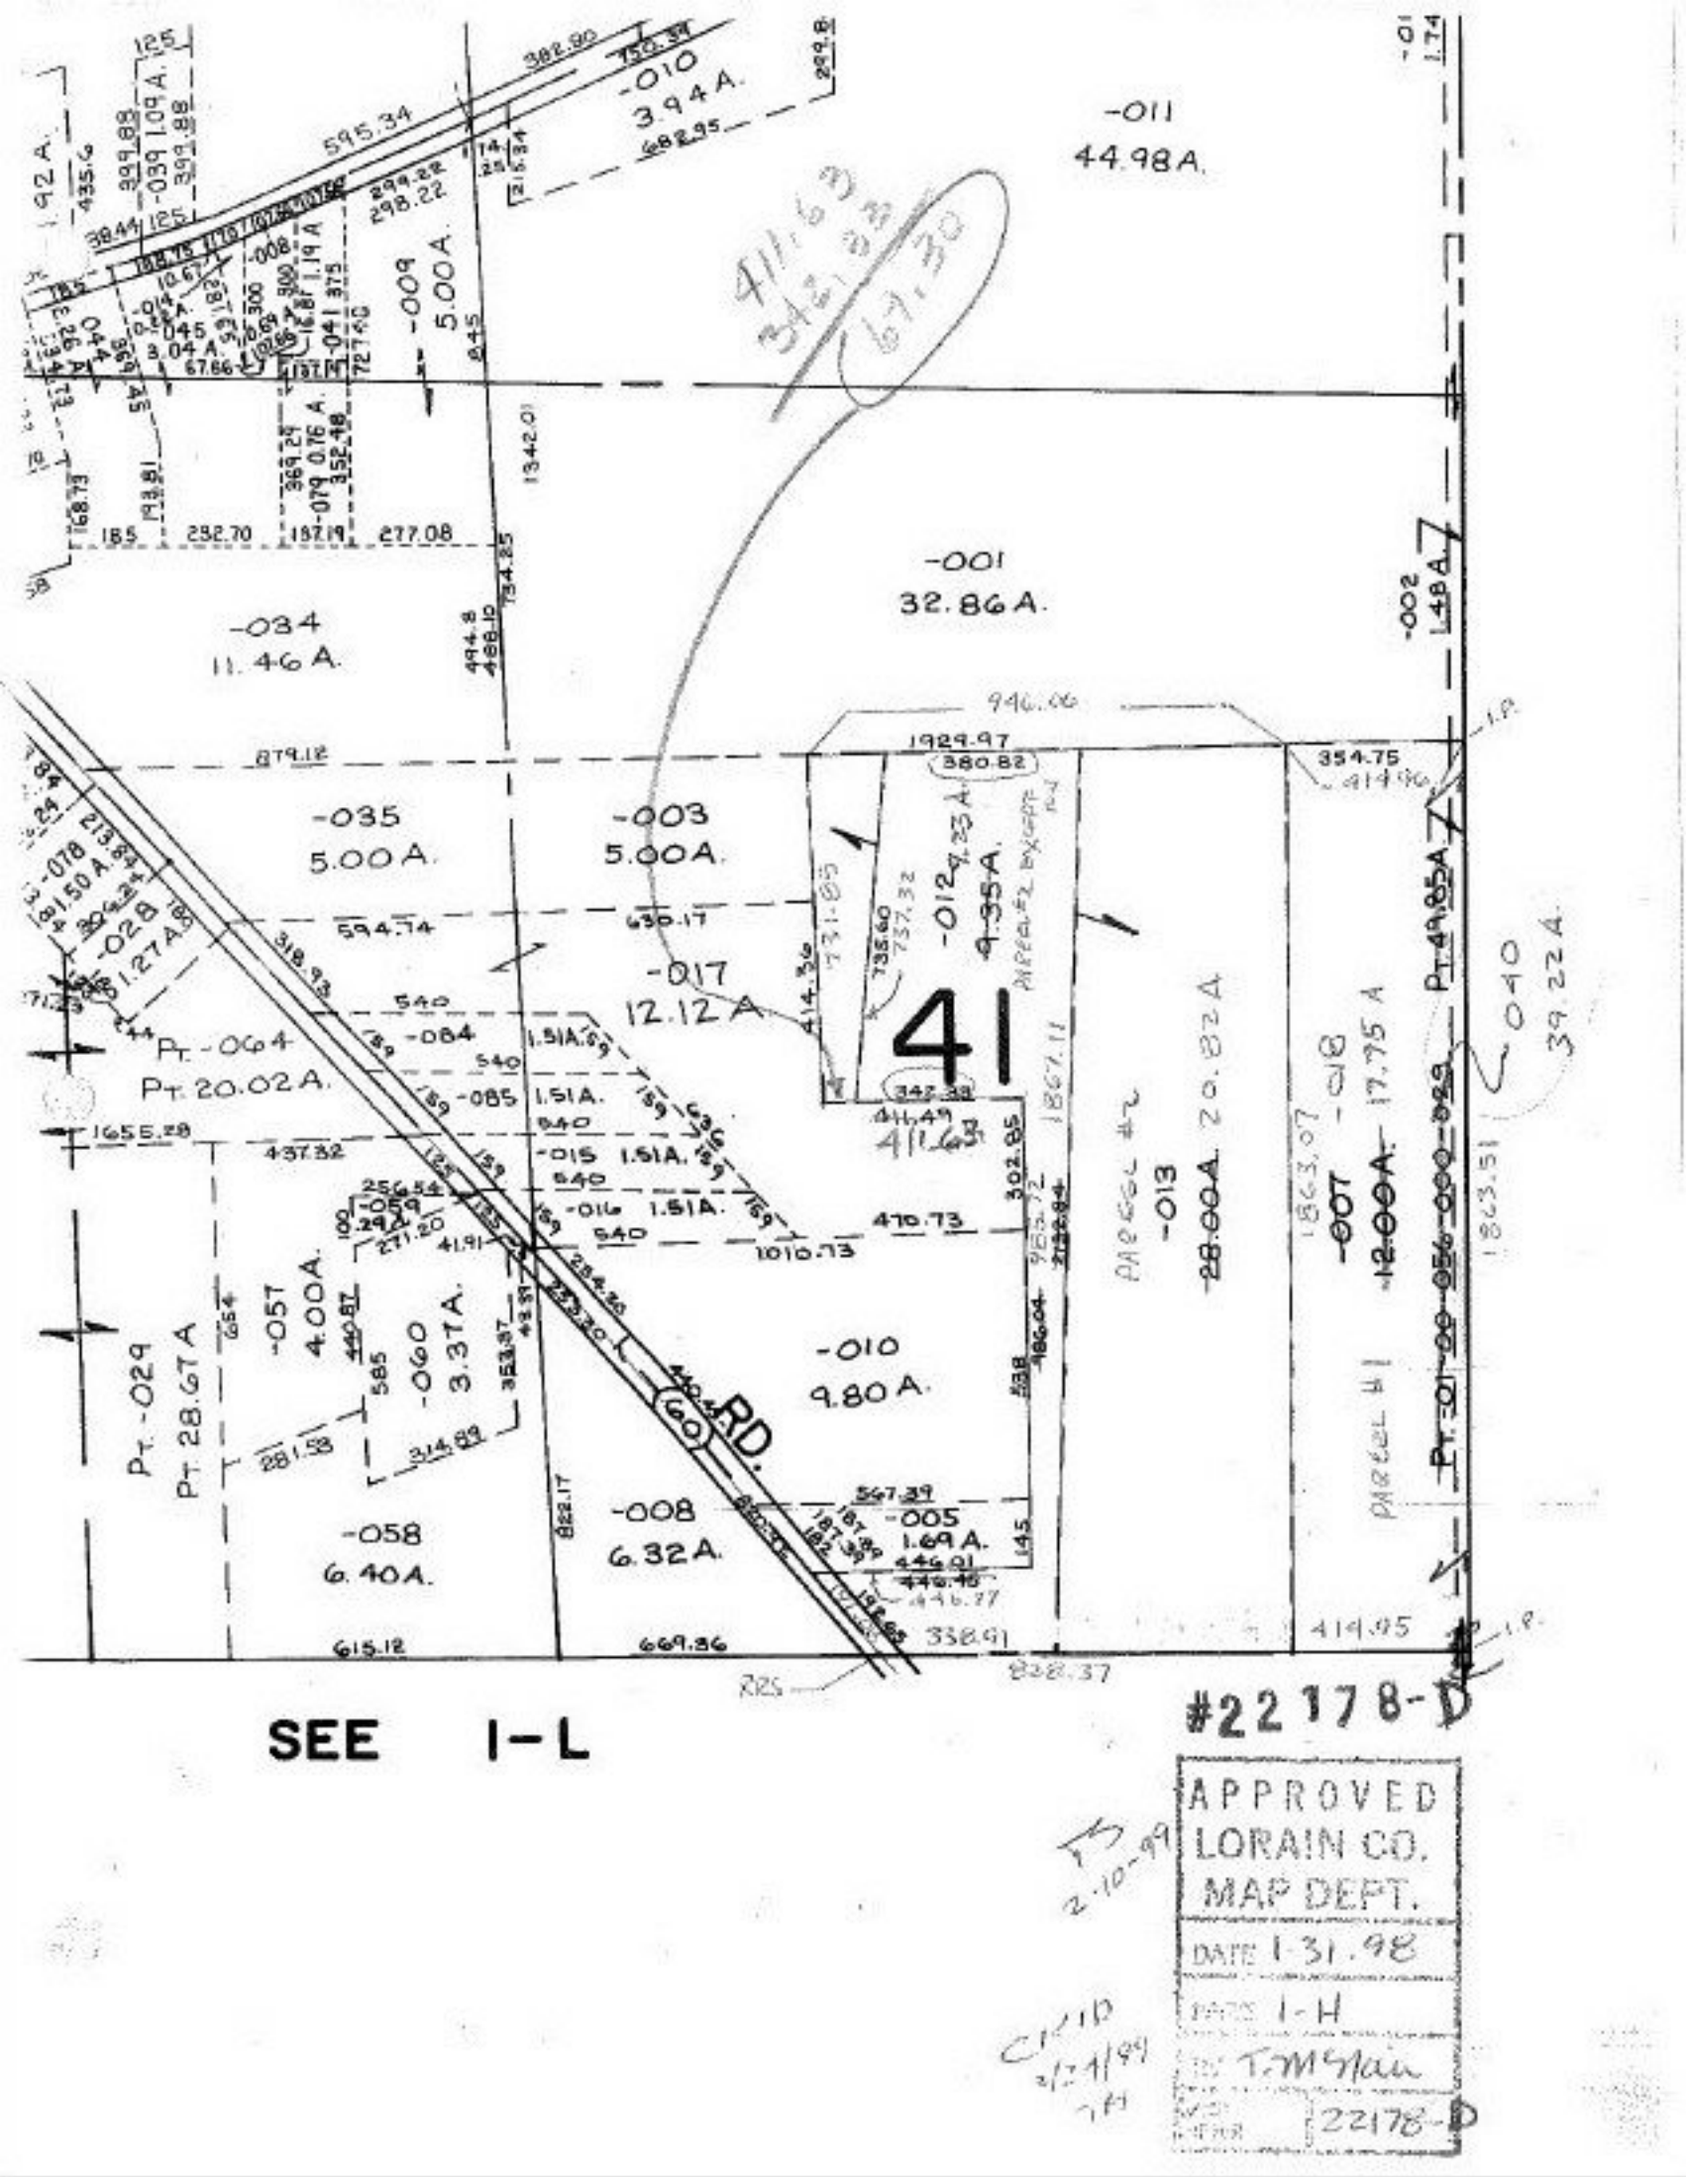
-010
3.94 A.
-011
44.98 A.
-009
5.00 A.
-008
1.19 A.
-039 1.09 A.
-041 1.75 A.
-079 0.76 A.
-045 3.04 A.
-001
32.86 A.
-034
11.46 A.
-035
5.00 A.
-003
5.00 A.
-012 9.23 A.
9.35 A.
-017
12.12 A.
41
-084
-085 1.51 A.
-015 1.51 A.
-016 1.51 A.
-028 1.27 A.
-078 0.50 A.
Pt. -064
Pt. 20.02 A.
-013
28.00 A. 20.82 A.
-018
-007 12.00 A. 17.75 A.
Pt. -01-00-056-000-000
Pt. 49.85 A.
-040
39.22 A.
-057
4.00 A.
-060
3.37 A.
Pt. -029
Pt. 28.67 A.
-058
6.40 A.
-010
9.80 A.
-008
6.32 A.
-005
1.69 A.
-002
1.48 A.
PARCEL #2
PARCEL #1
RD.
(60)
SEE I-L
#22178-D
APPROVED
LORAIN CO.
MAP DEPT.
DATE 1.31.98
PAGE I-H
BY T.M Stain
PROP. # 22178-D