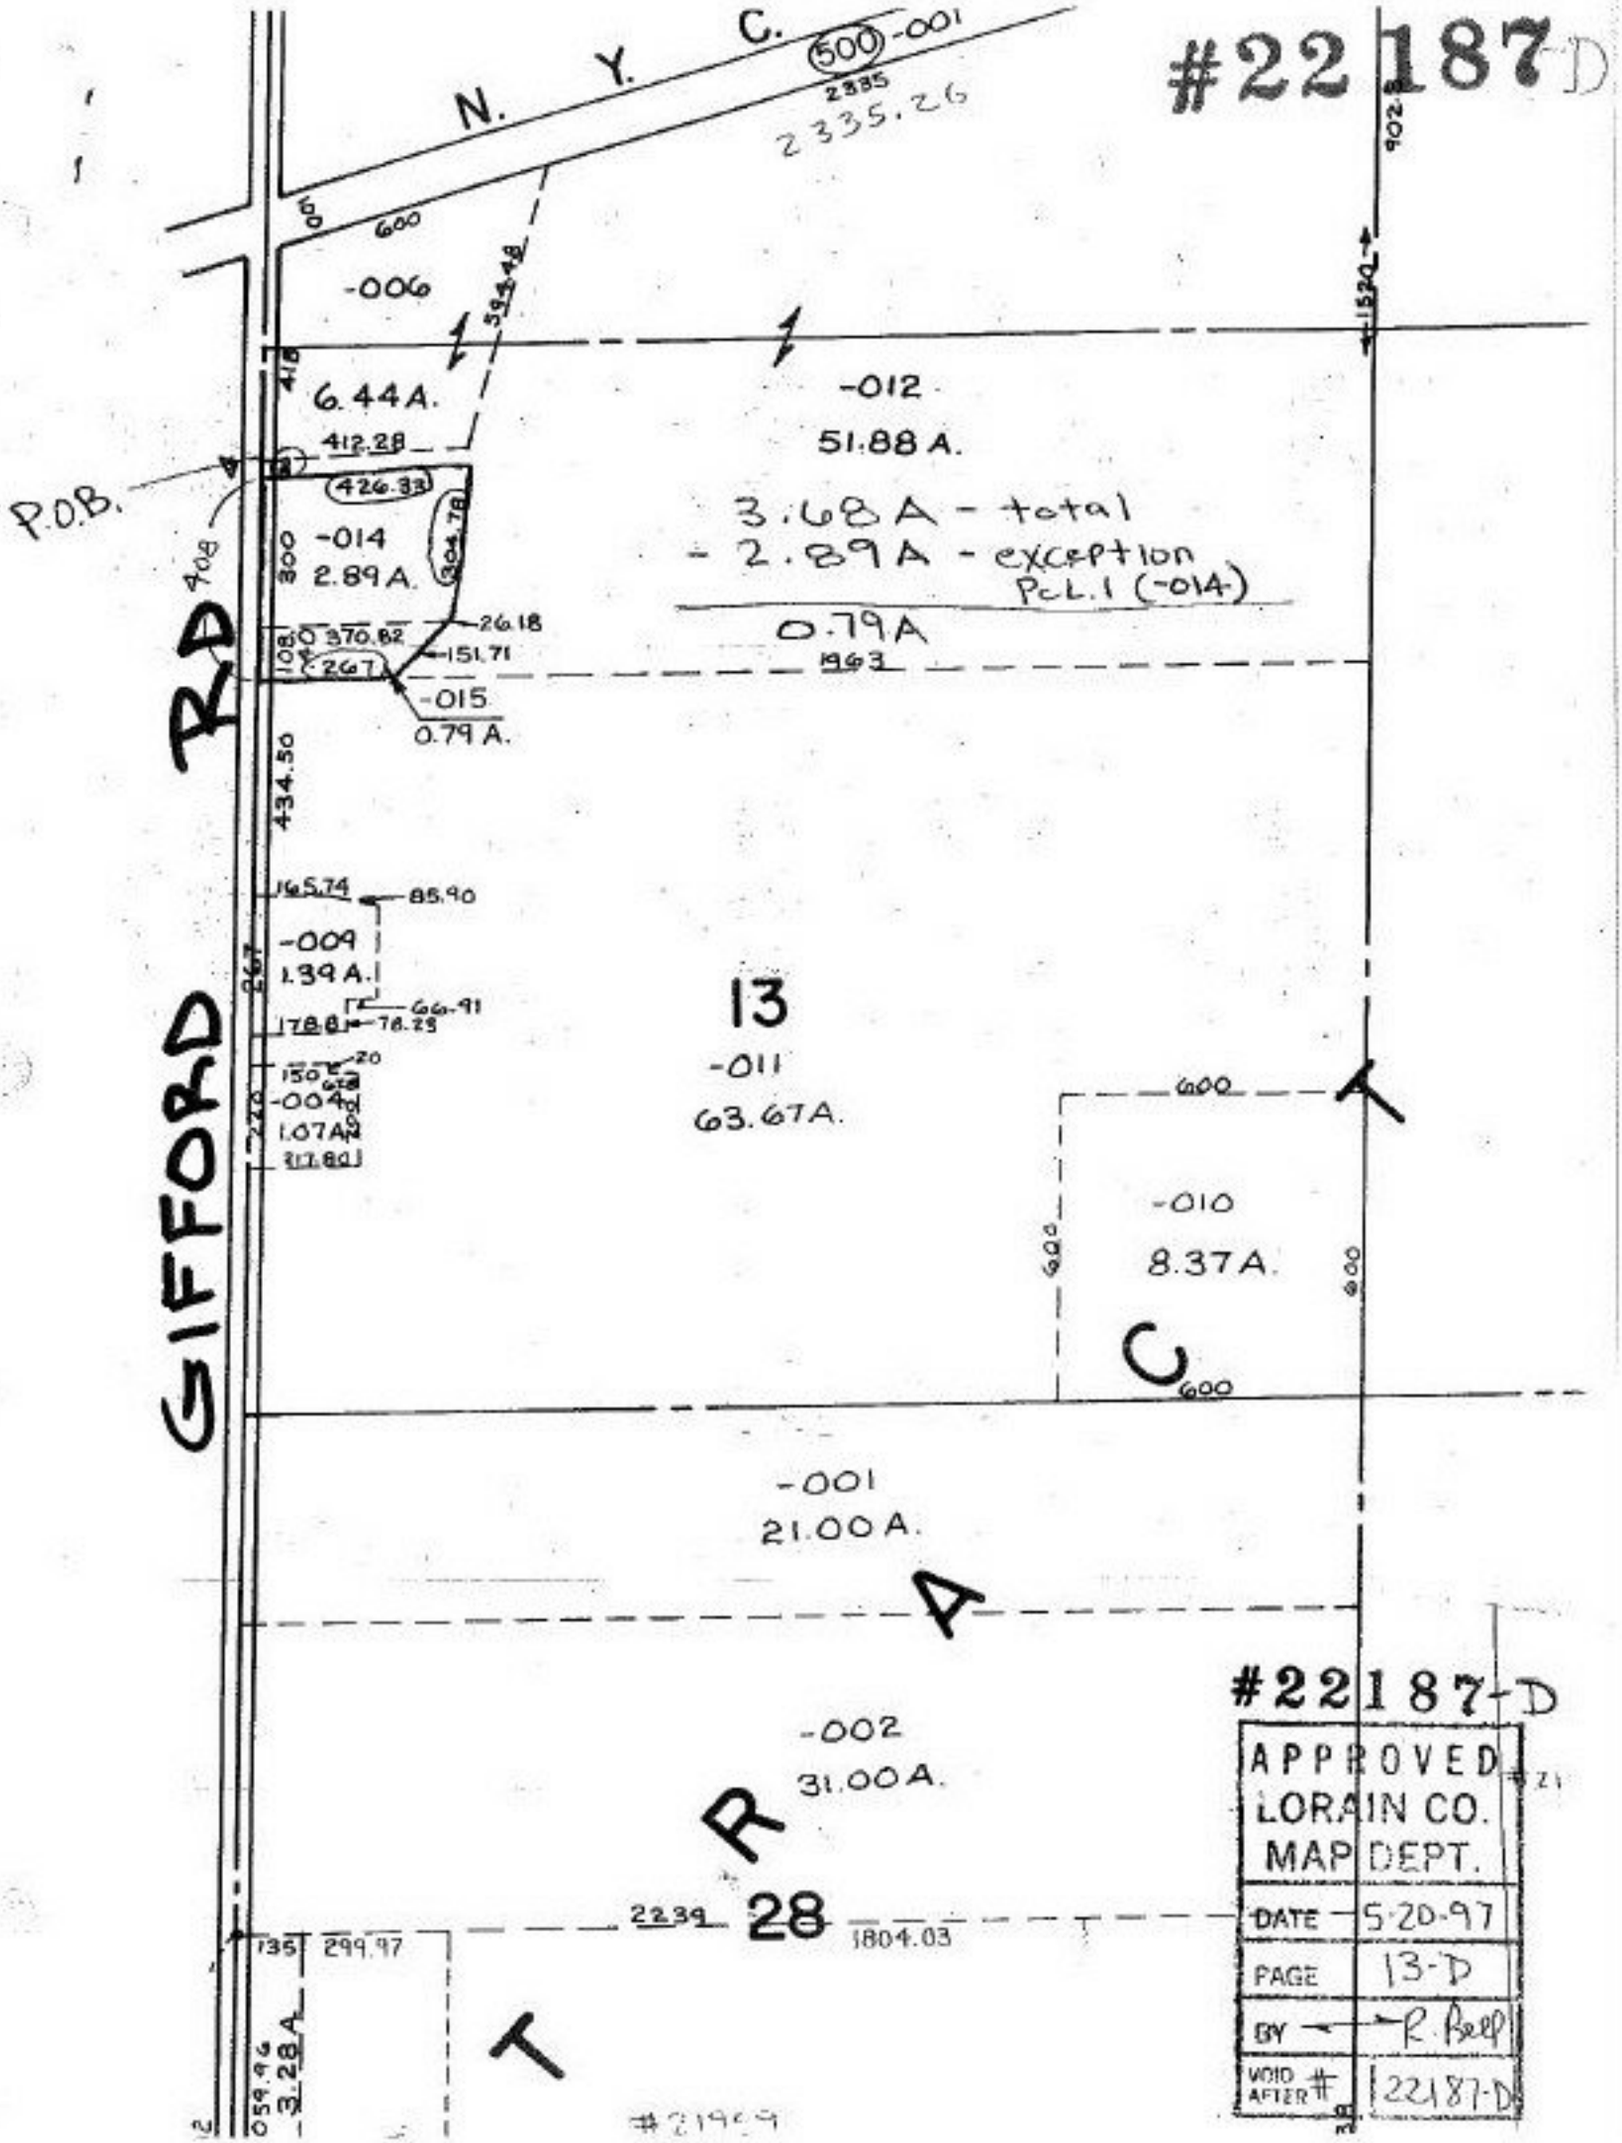
#22187-D
N. Y. C.
500 -001
2335
2335.26
600
-006
594.48
6.44A.
412.28
-012
51.88 A.
P.O.B.
426.33
-014
2.89 A.
304.78
3.68 A - total
- 2.89 A - exception
Pcl. 1 (-014)
0.79A
1963
26.18
370.82
151.71
267
-015
0.79 A.
434.50
GIFFORD RD
165.74
85.90
-009
1.39 A.
66.91
178.8
78.25
13
-011
63.67A.
-004
1.07A
217.80
600
-010
8.37A.
C
-001
21.00 A.
A
-002
31.00 A.
R
28
2239
1804.03
299.97
3.28 A
T
#22187-D
APPROVED
LORAIN CO.
MAP DEPT.
DATE 5-20-97
PAGE 13-D
BY R. Beep
VOID AFTER # 22187-D