#22 200

PARENT PARCEL: 05-00-032-000-021, 023, 024

CHILD PARCEL: 05-00-032-000-061 THRU 066

STARTING POINT: n. line of O.L. 32 & cL of State Route 113 (Milan Elyria Rd.)

NO. 22200

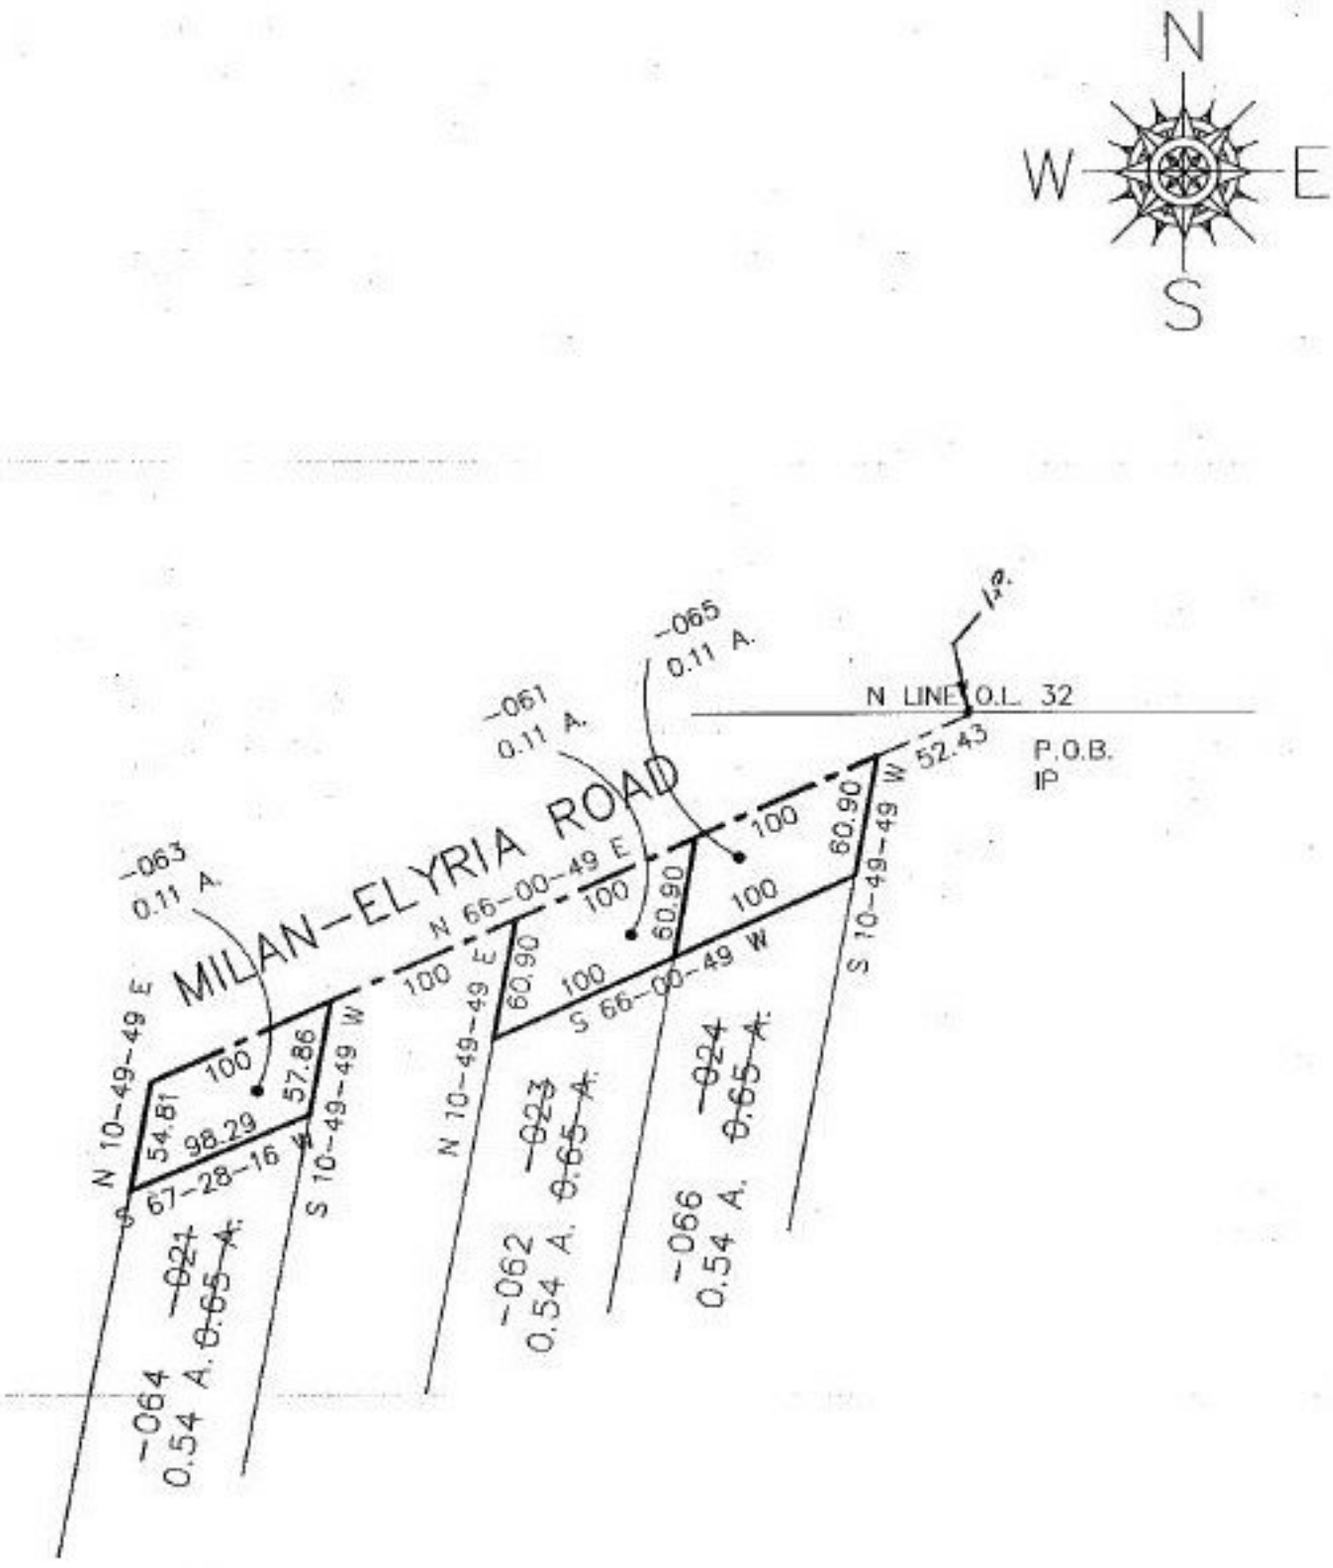

SPLITS/DEEDS PROCESSED

LORAIN COUNTY TAX MAP DEPARTMENT

226 MIDDLE AVE. ELYRIA, OHIO

SURVEYED BY: Ohio Dept. of Transportation

CLOSURE: 0.13 per 10,000

MAP PAGE(S): 05-00-032-A

APPROVED BY: kac/REB DATE: 6-9-97

SCALE: 1"= 100