#22 201

NO. 22201

PARENT PARCEL: 21-03-000-000-020,021,023 & 026

CHILD PARCEL: 21-03-000-000-072, -073

STARTING POINT: INT CL SR 162 & CL CLARK ROAD

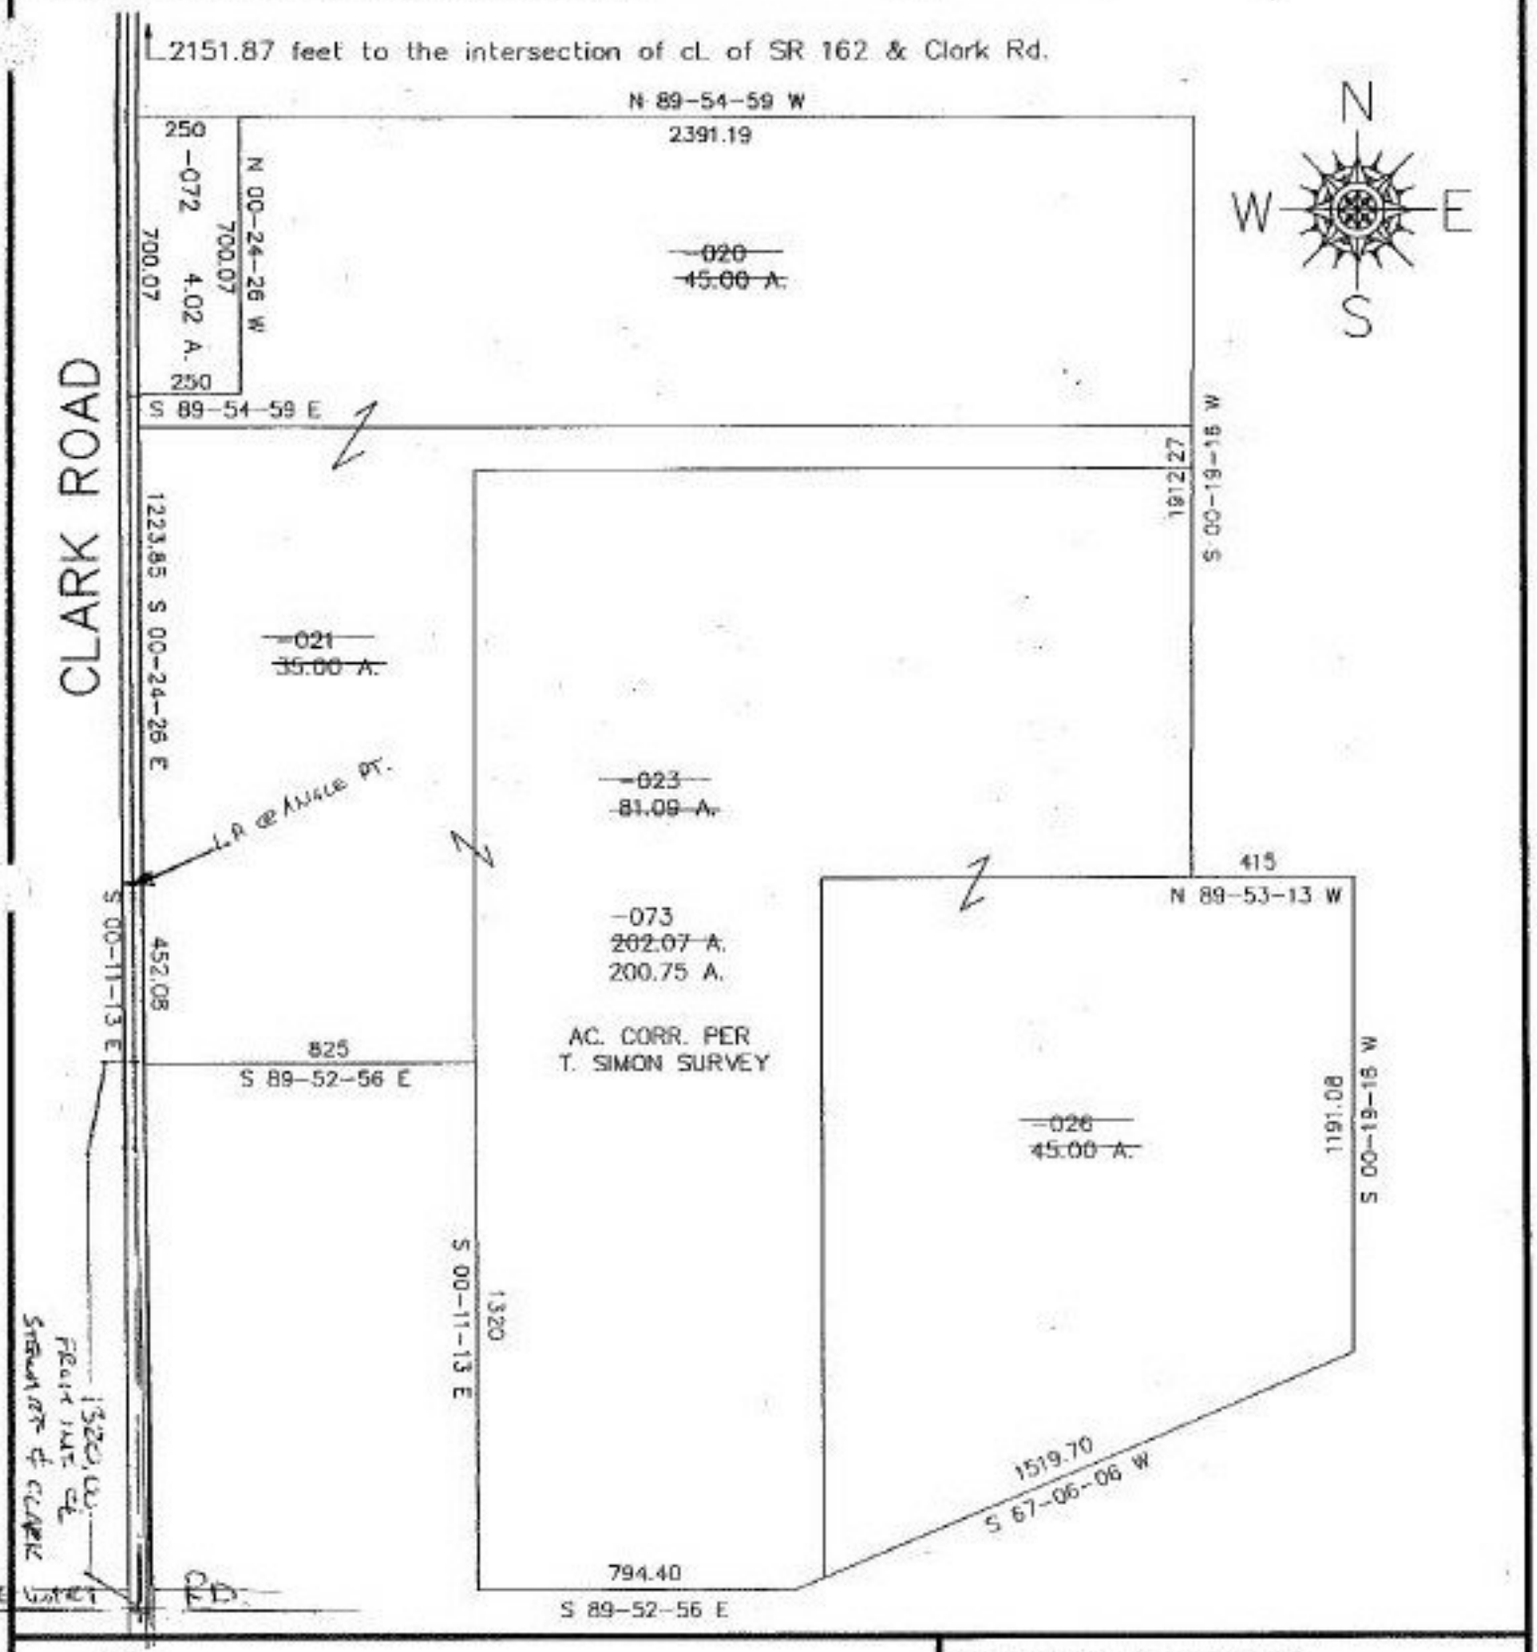

SPLITS/DEEDS PROCESSED

LORAIN COUNTY TAX MAP DEPARTMENT

226 MIDDLE AVE. ELYRIA, OHIO

SURVEYED BY: THOMAS SIMON

CLOSURE: 0.01 : 10,000

MAP PAGE(S): 21-F

APPROVED BY: RFB/KAC DATE: 6-10-97

SCALE: 1" = 500'