PARENT PARCEL: 07-00-032-000-035 & 042
CHILD PARCEL: 07-00-032-000-049 THRU 052 & 07-00-029-000-100
STARTING POINT: INT CL STONEY RIDGE RD & CL BARRES RD

NO. 22204 #22204

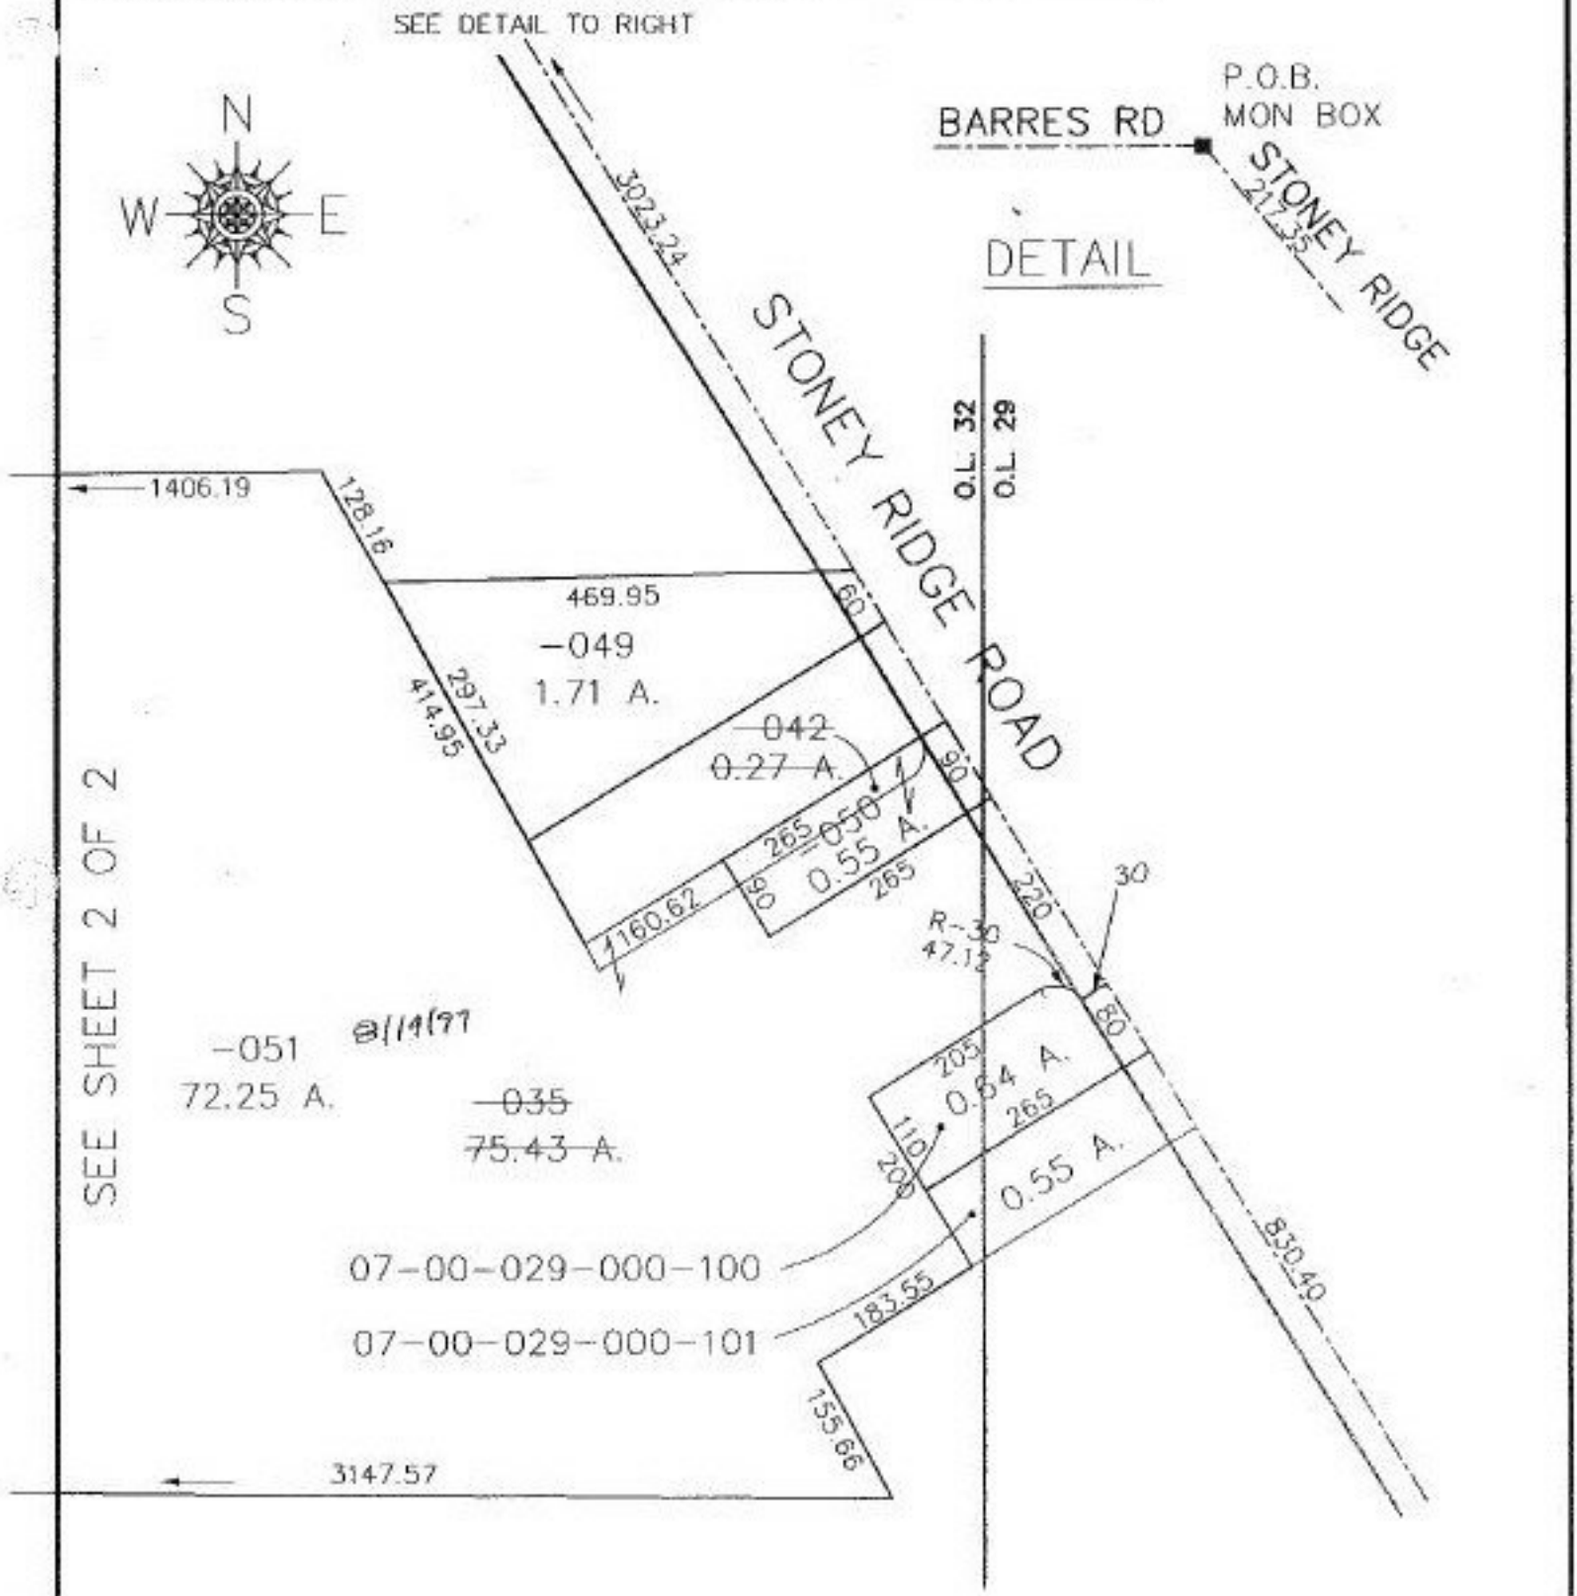

SPLITS/DEEDS PROCESSED
LORAIN COUNTY TAX MAP DEPARTMENT
226 MIDDLE AVE. ELYRIA, OHIO

SURVEYED BY: DANE A. HAPONEK
CLOSURE: 0.05 : 10,000
MAP PAGE(S): 07-00-029C & 7-8
APPROVED BY: RFB DATE: 06/25/97
SCALE: 1"=200