#22 207

PARENT PARCEL: 03-00-074-102-003
CHILD PARCEL: 03-00-074-102-009 & 010
STARTING POINT: cL of Ford Road & cL of Old North Ridge Road

NO. 22207

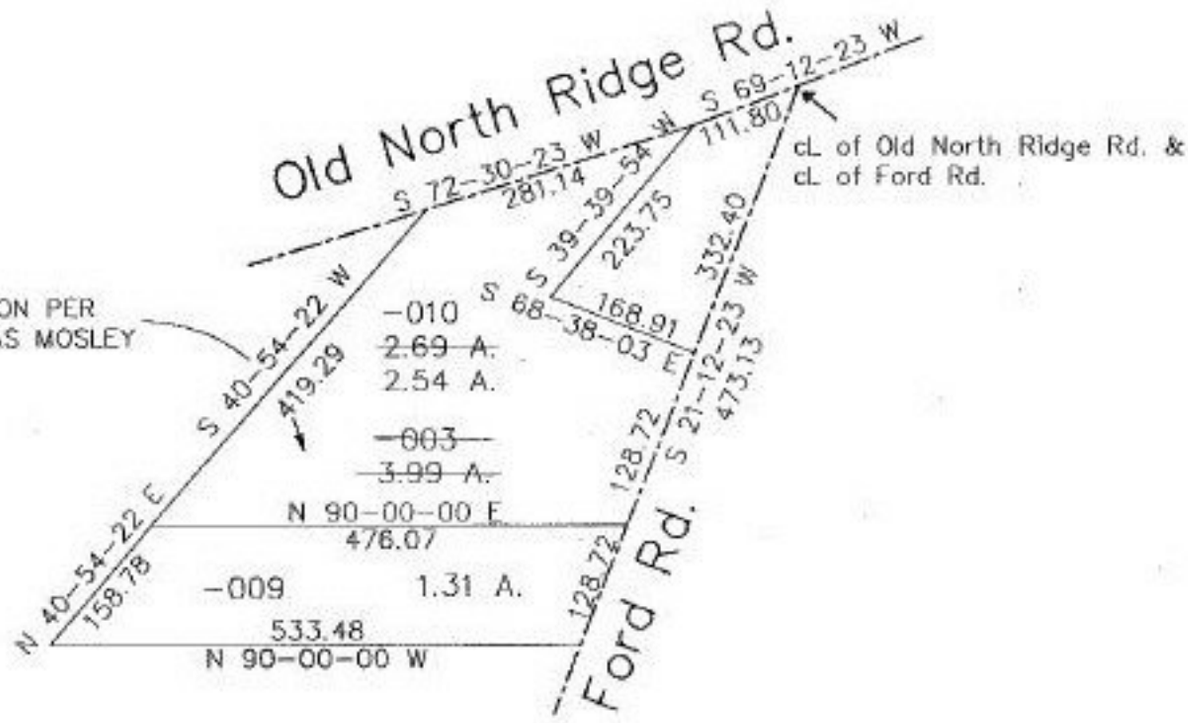

SPLITS/DEEDS PROCESSED
LORAIN COUNTY TAX MAP DEPARTMENT
226 MIDDLE AVE. ELYRIA, OHIO

SURVEYED BY: Douglas Mosley
CLOSURE: 0.01 per 10,000
MAP PAGE(S): 03-00-073-A
APPROVED BY: kac DATE: 6-17-97
SCALE: 1"=200