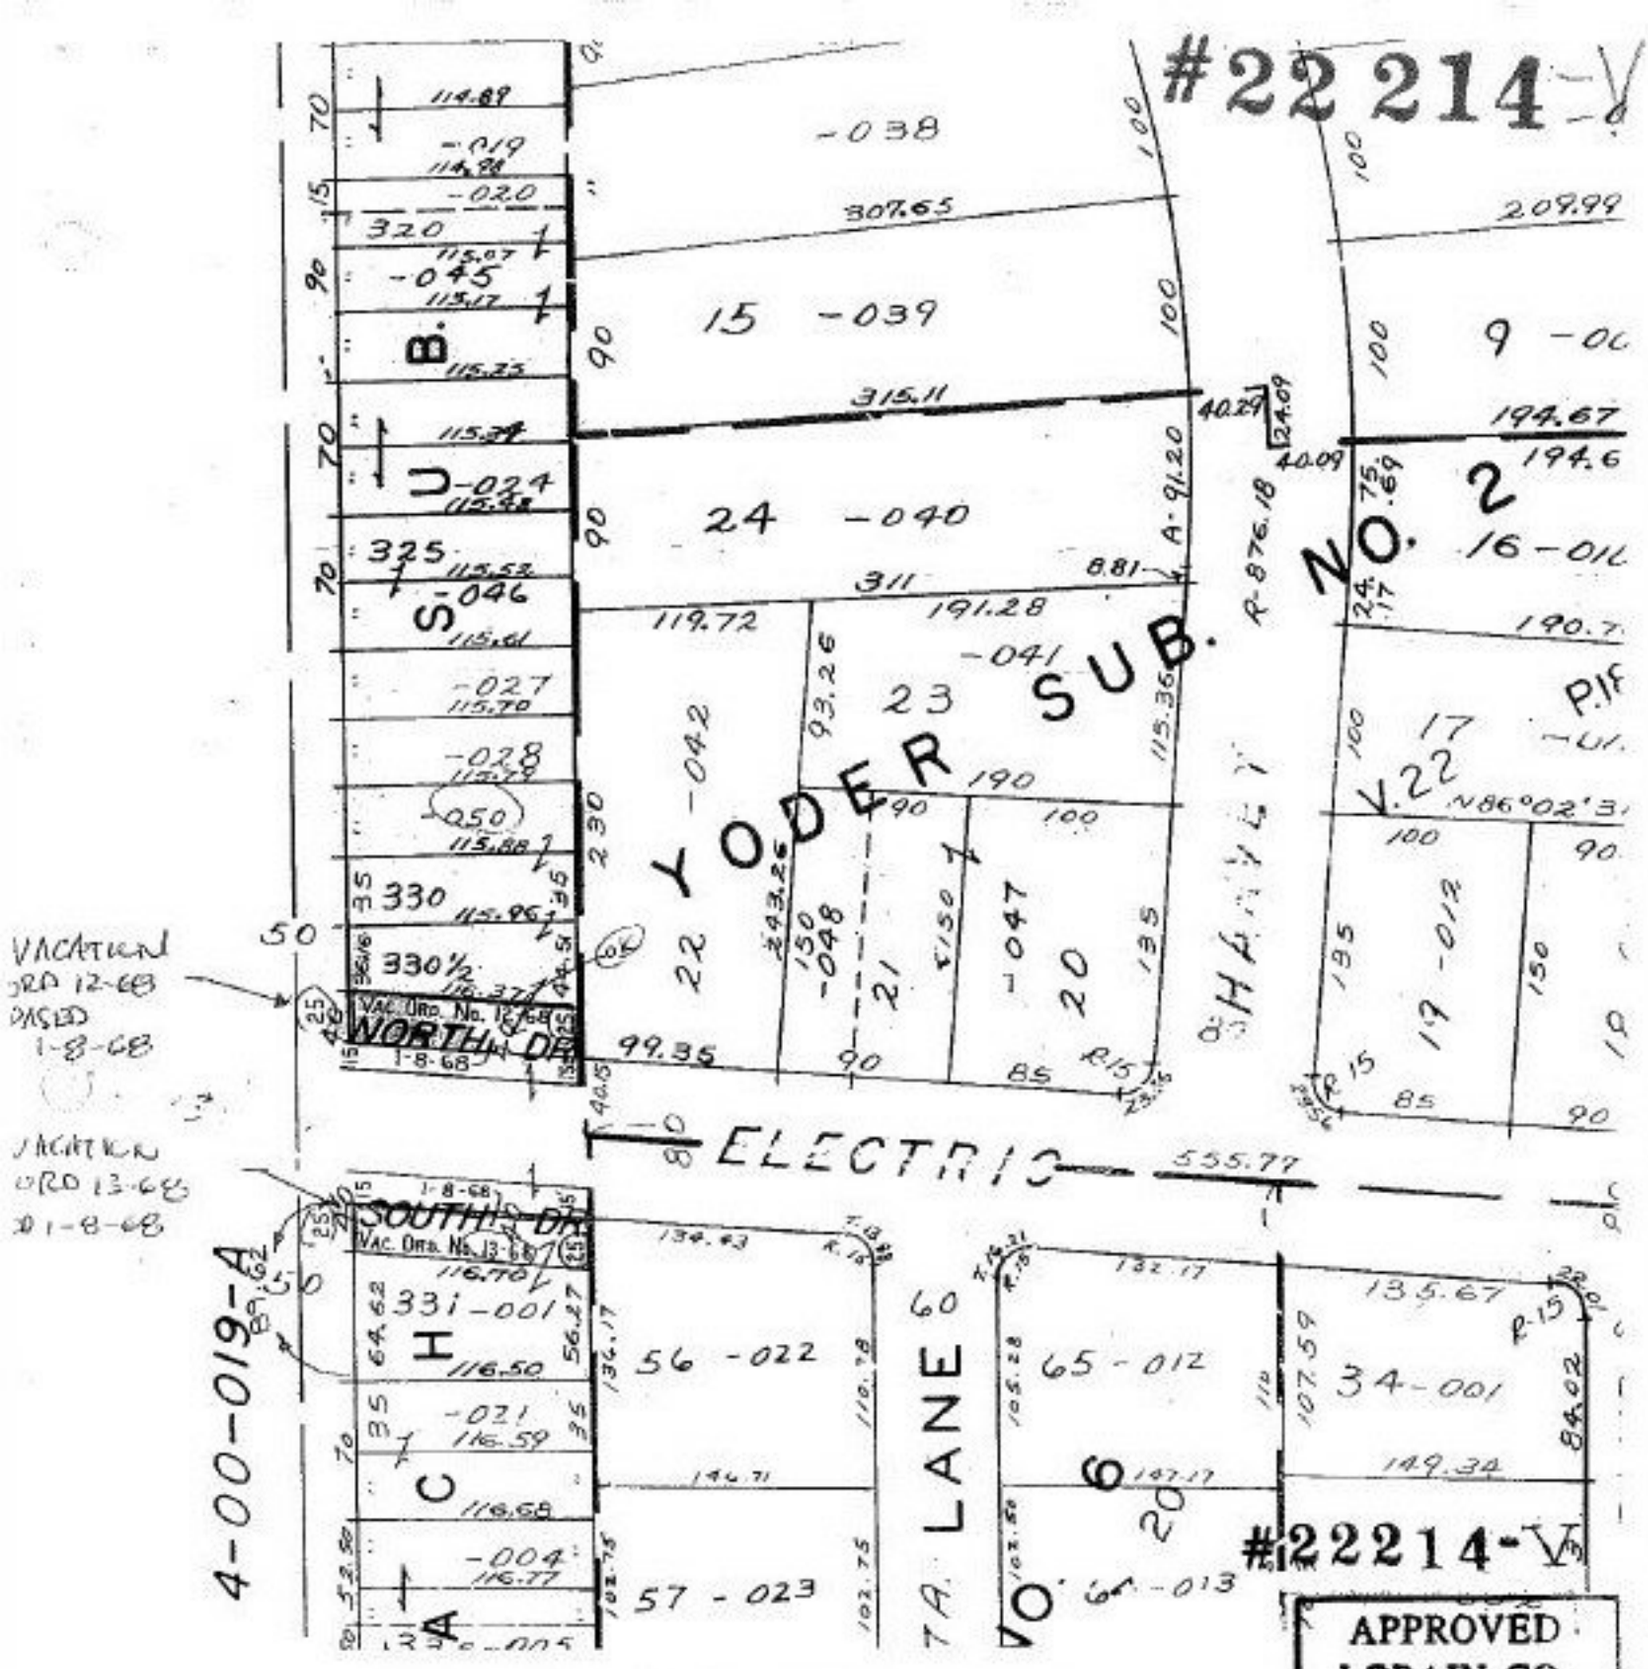

FRONTAGE CORRECTION (-001) TO INCLUDE PART OF SOUTH DR. (VACATED) BY ORDINANCE # 13-68

FRONTAGE CORRECTION (-050) TO INCLUDE PART OF NORTH DR (VACATED) BY ORDINANCE # 17-68.