#22216

NO. 22216

PARENT PARCEL: 21-05-011-000-004

CHILD PARCEL: 21-05-011-000-042, 043

STARTING POINT: CL BURSLEY ROAD & ELY LINE LOT 11 TRACT 5

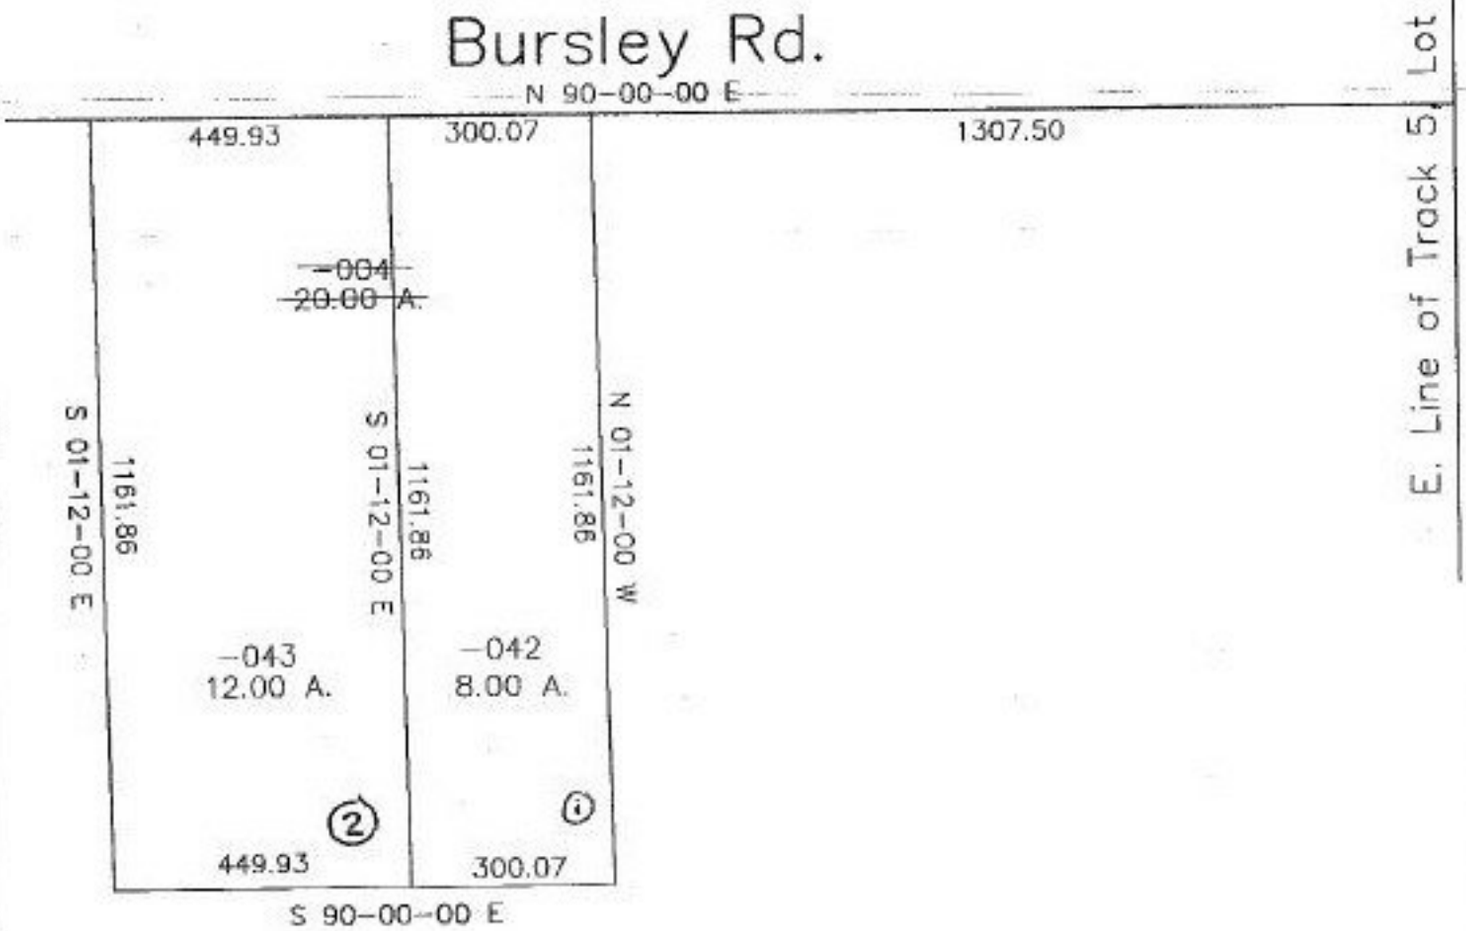

SPLITS/DEEDS PROCESSED

LORAIN COUNTY TAX MAP DEPARTMENT

226 MIDDLE AVE. ELYRIA, OHIO

SURVEYED BY: THOMAS M. SNEZEK

CLOSURE: 0.00 ; 10,000

MAP PAGE(S): 21-6

APPROVED BY: RFB DATE: 06/23/97

SCALE: 1" = 300