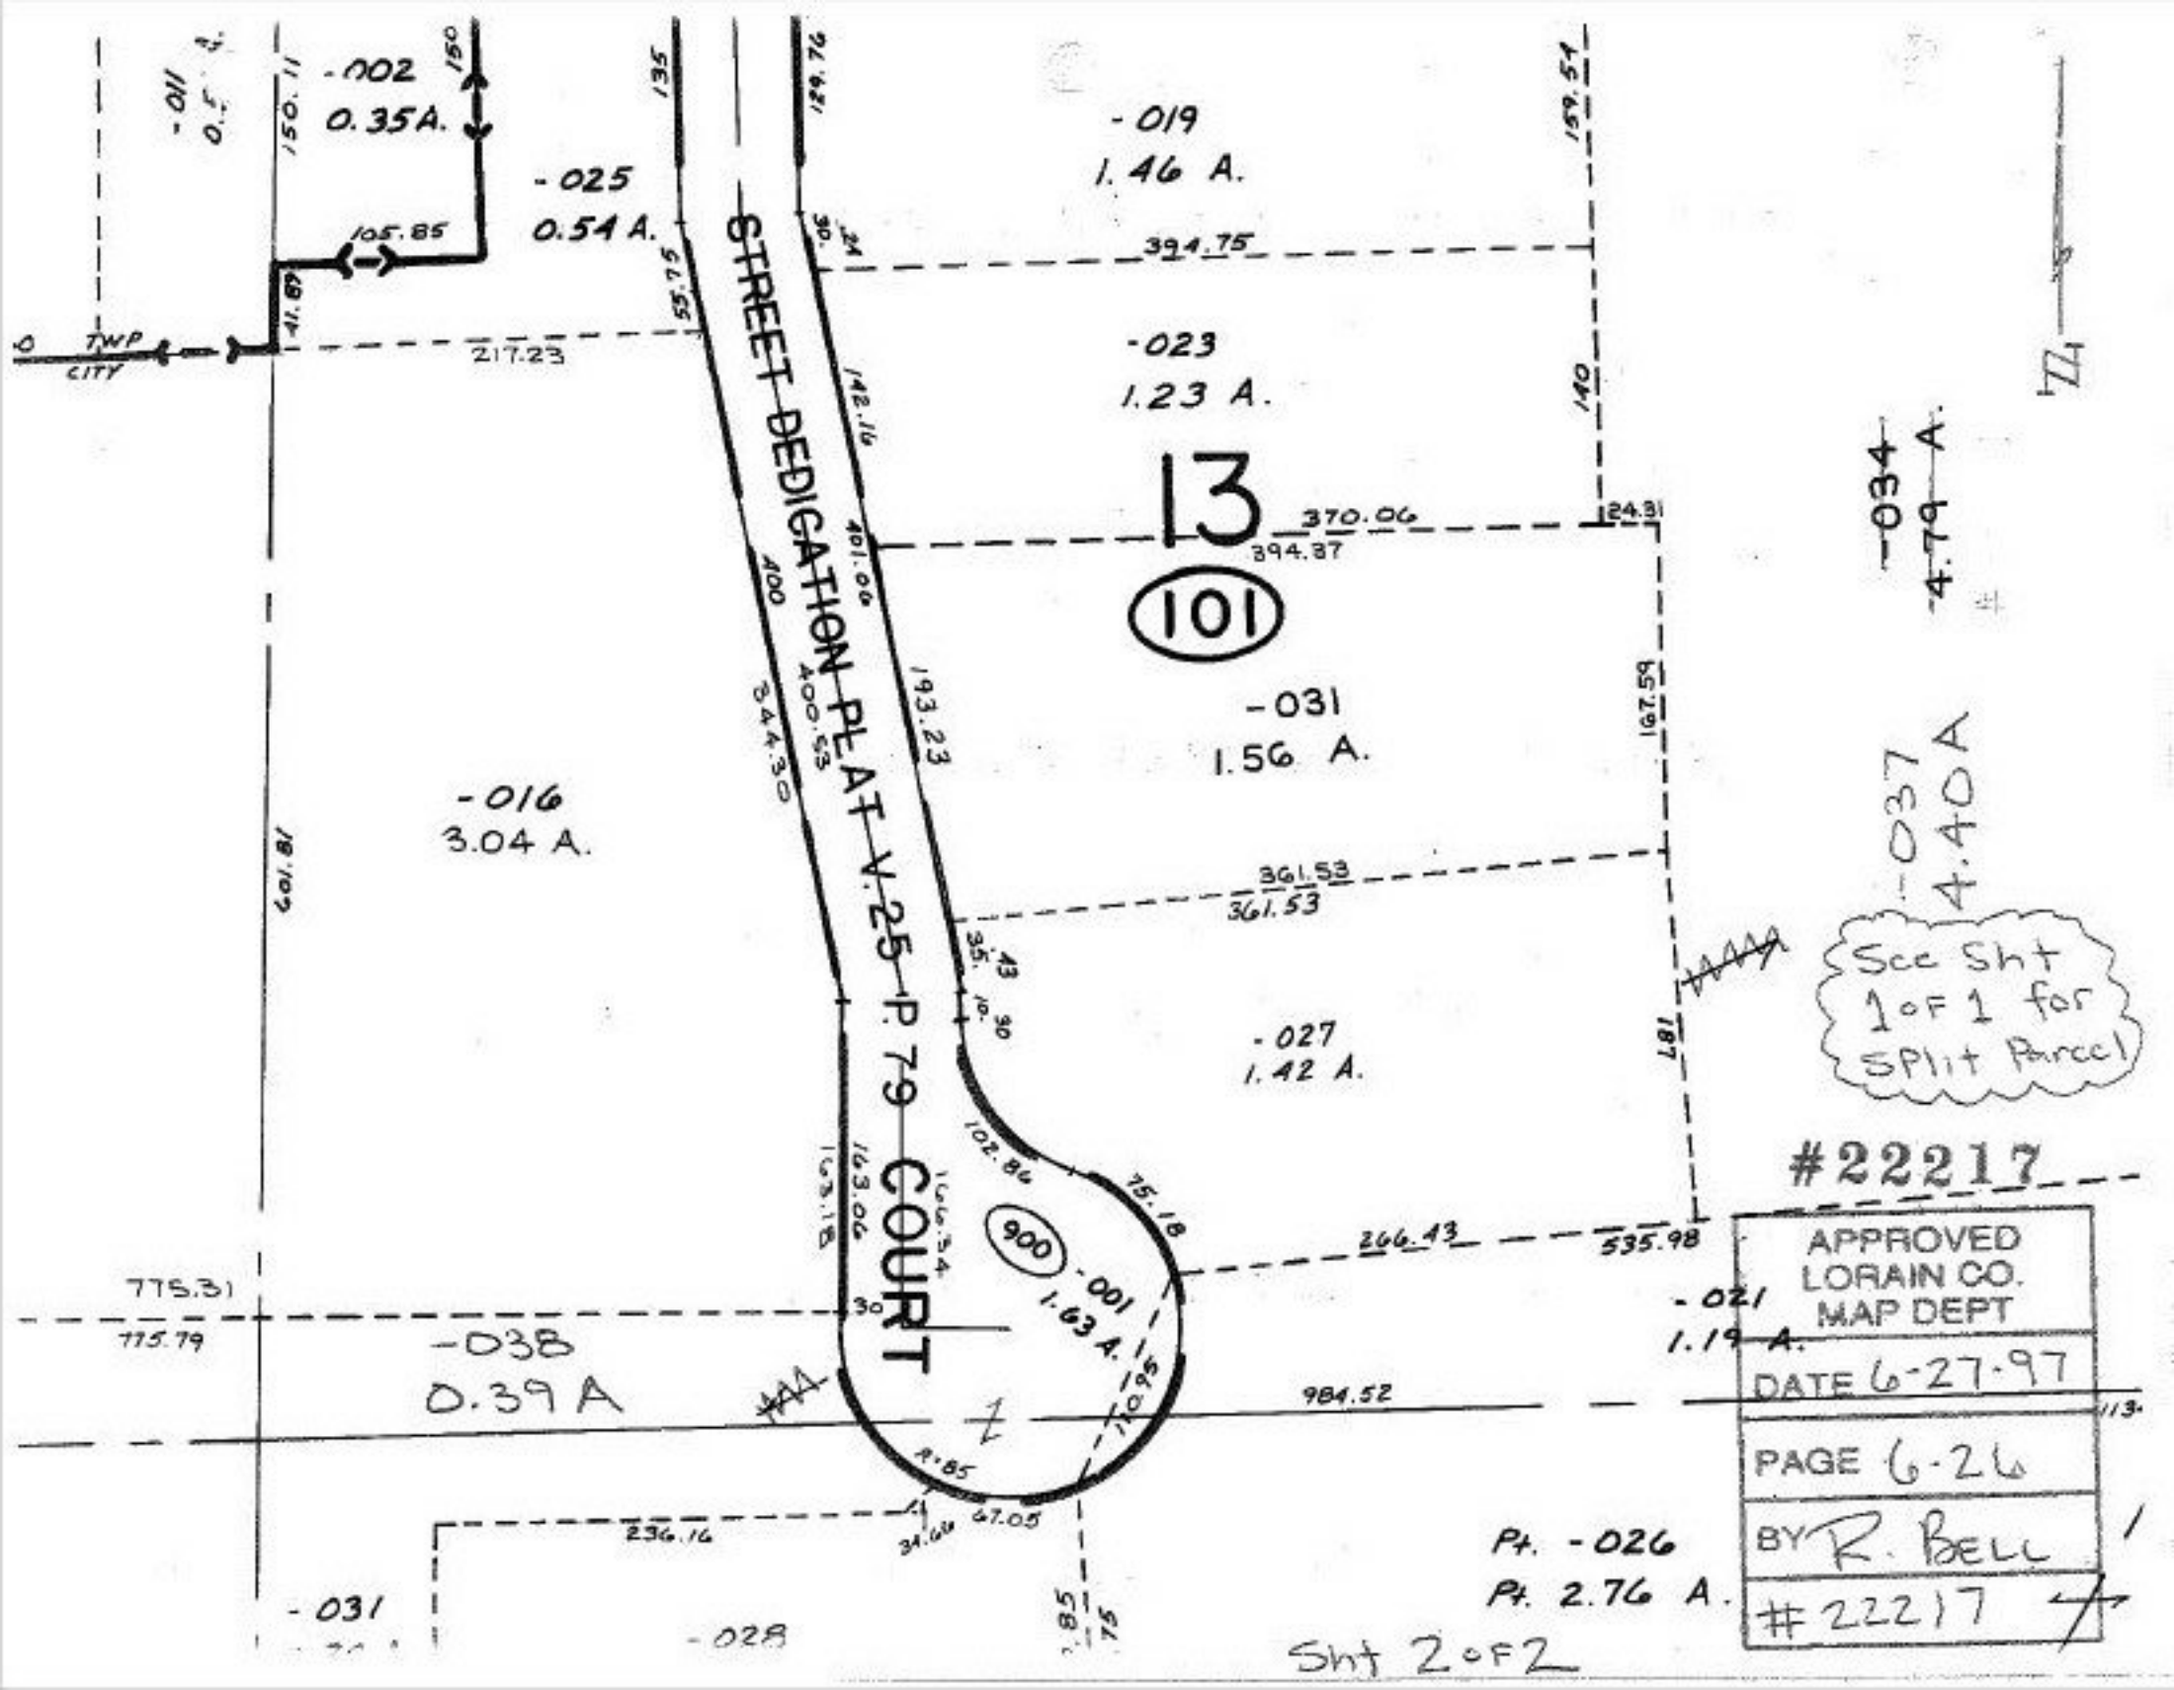
-011
0.5 A.
-002
0.35A.
-025
0.54 A.
-019
1.46 A.
-023
1.23 A.
13
101
-031
1.56 A.
-016
3.04 A.
-027
1.42 A.
-034
4.79 A.
-037
4.40A
See Sht 1 of 1 for Split Parcel
STREET DEDICATION PLAT V.25 P.79 COURT
900
-001
1.63 A.
-038
0.39 A
-021
1.19 A.
Pt. -026
Pt. 2.76 A.
-031
-028
TWP
CITY
#22217
APPROVED
LORAIN CO.
MAP DEPT
DATE 6-27-97
PAGE 6-26
BY R. BELL
#22217
Sht 2 of 2