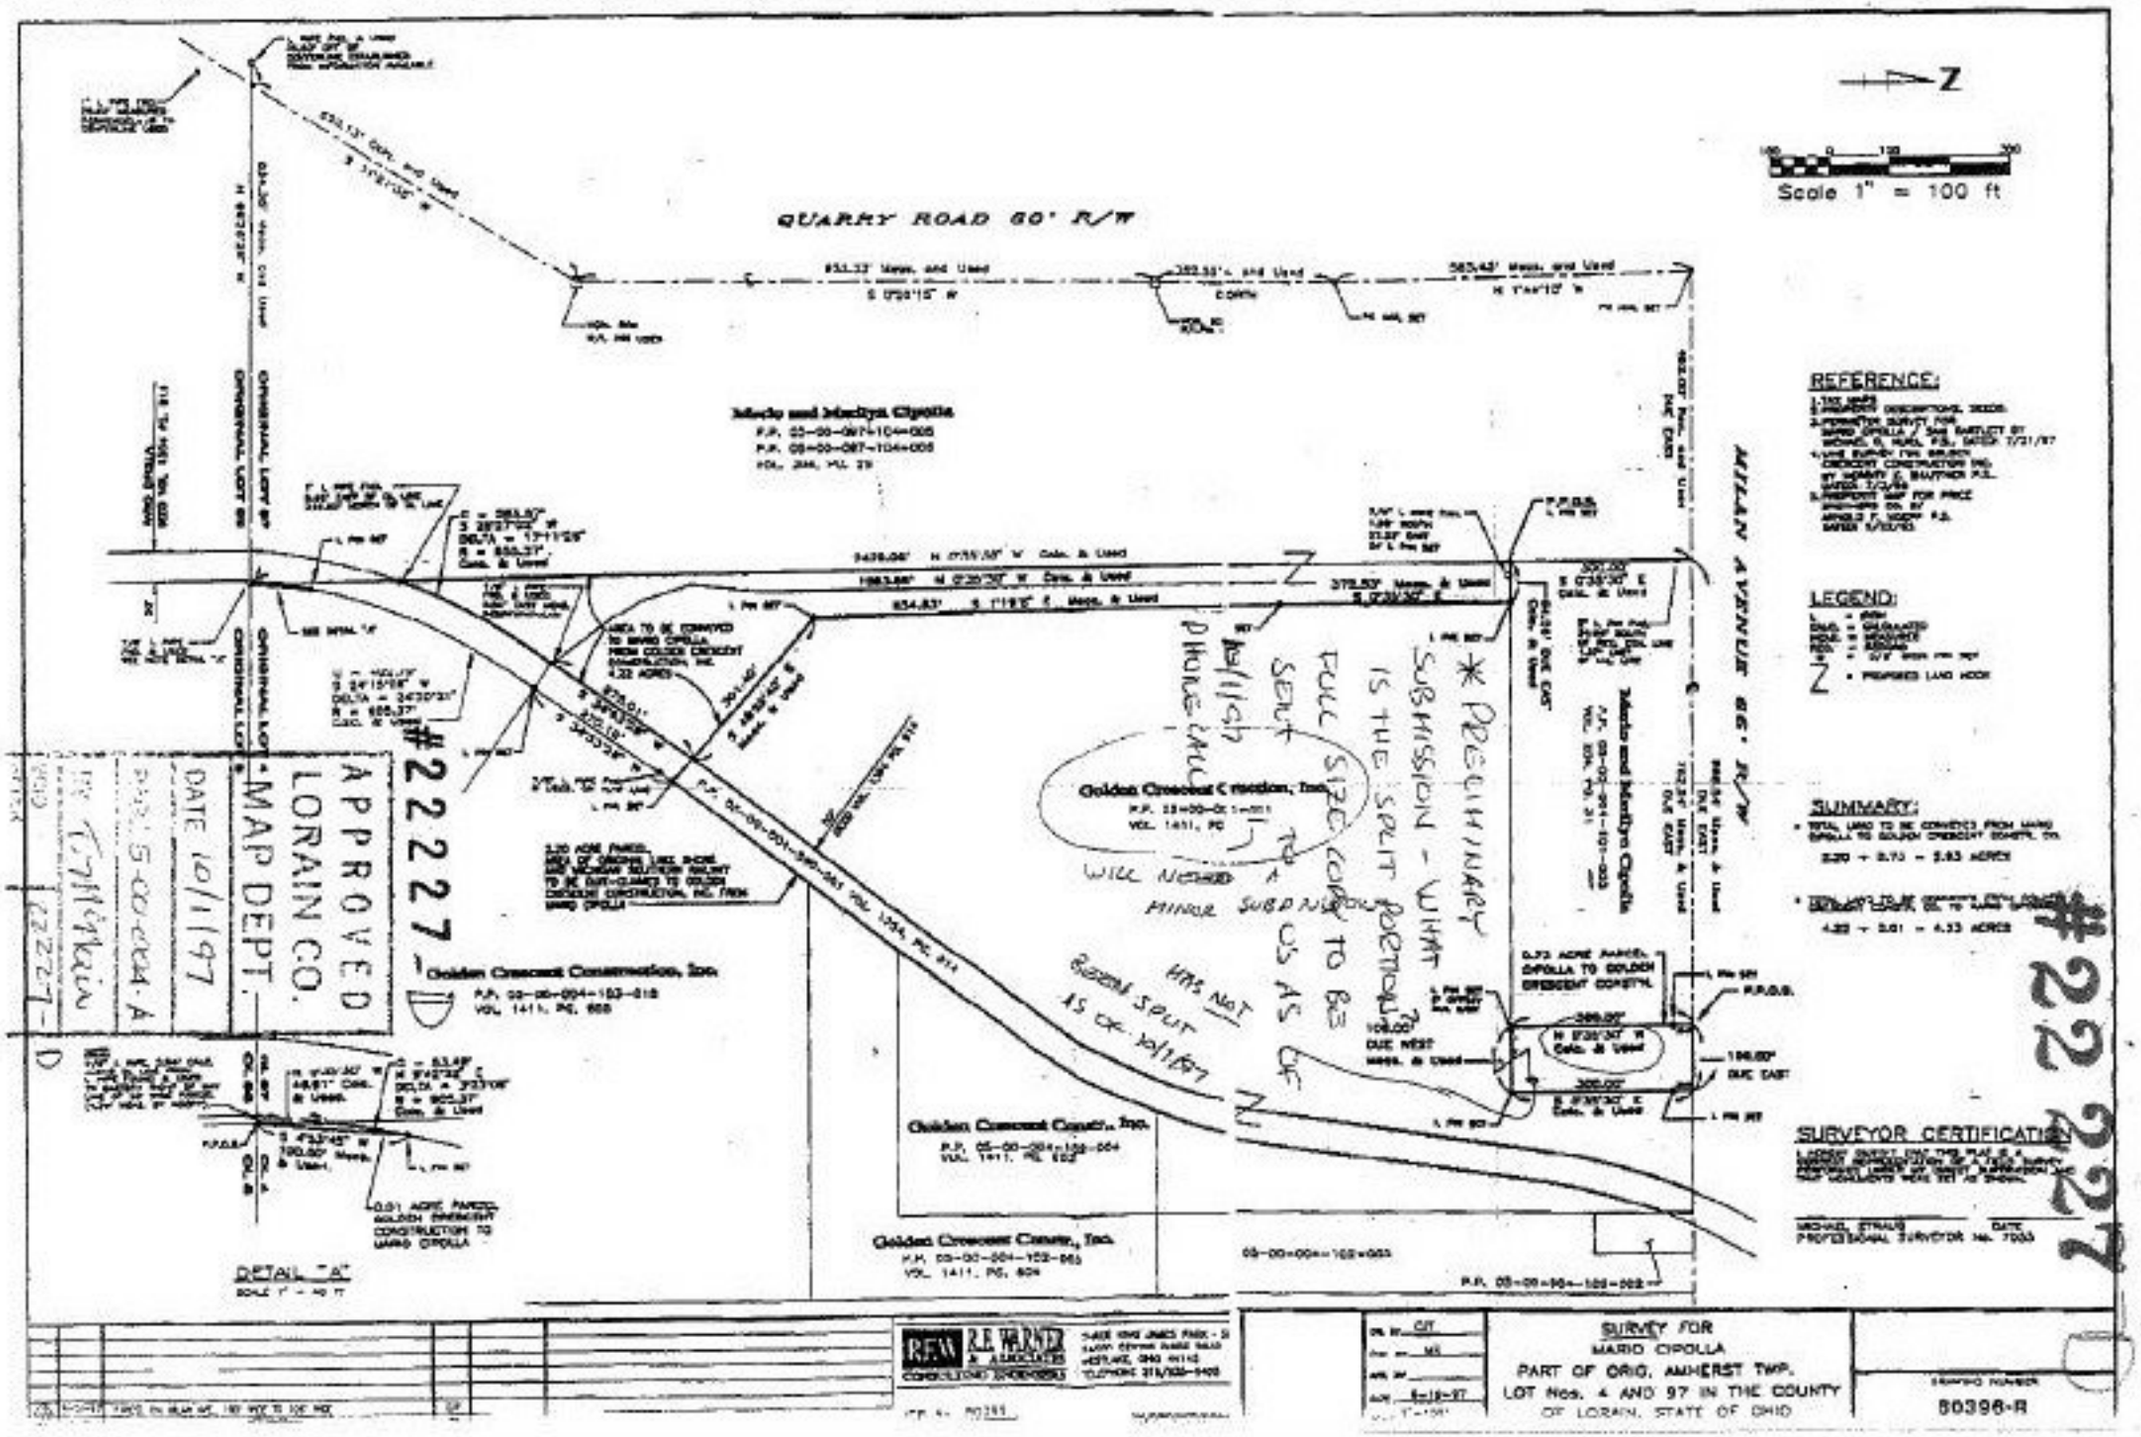
QUARRY ROAD 60' R/W
MILAN AVENUE 66' R/W
Scale 1" = 100 ft
Mario and Marilyn Cipolla
Golden Crescent Construction, Inc.
Golden Crescent Constr., Inc.
REFERENCE:
LEGEND:
SUMMARY:
SURVEYOR CERTIFICATION
DETAIL "A"
APPROVED
LORAIN CO.
MAP DEPT.
DATE 10/1/97
#22227-D
* PRELIMINARY SUBMISSION - WHAT IS THE SPLIT PORTION? FULL SIZE COPY TO BE SENT TO US AS OF 10/1/97 PHONE CALL
WILL NEED A MINOR SUBDIVISION
HAS NOT BEEN SPLIT AS OF 10/1/97
#22227
R.E. WARNER & ASSOCIATES
CONSULTING ENGINEERS
SURVEY FOR
MARIO CIPOLLA
PART OF ORIG. AMHERST TWP.
LOT Nos. 4 AND 97 IN THE COUNTY
OF LORAIN, STATE OF OHIO
80396-R