#22 228

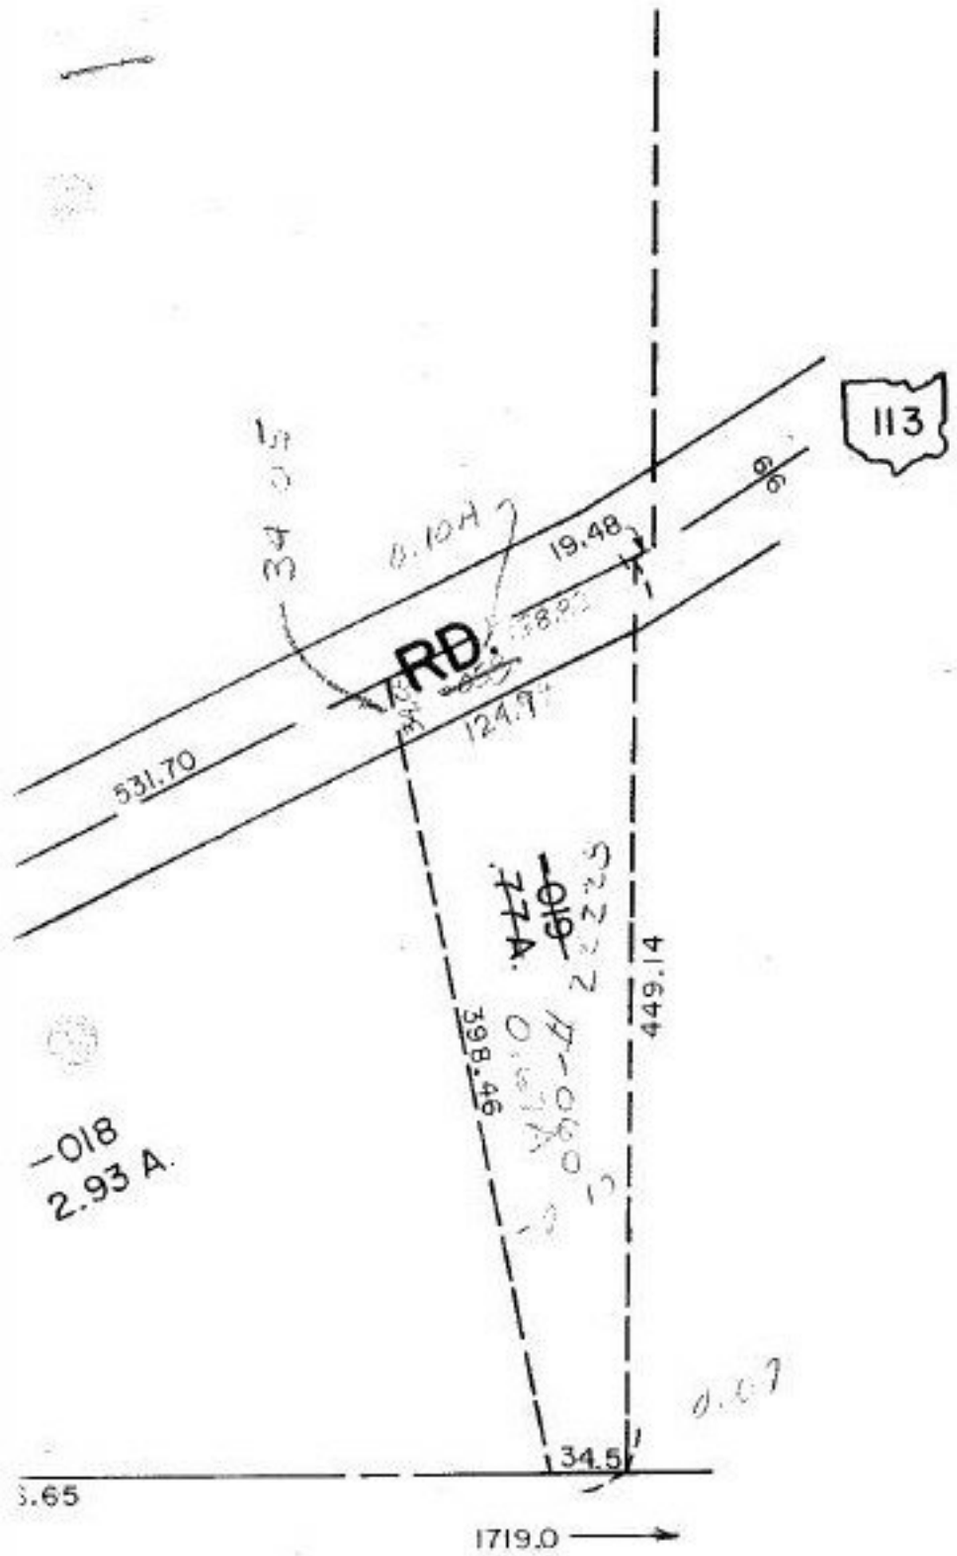

#22228

APPROVED LORAIN CO. MAP DEPT
DATE 4-26-97
PAGE 5-00-029A
BY AGolbert
22228

HERST TWP.