#22228-A

ACREAGE CORRECTION

12.00-005-A

12-00-005-101-012

J.W. WARDEN SURVEY, 8/20/41

PRIOR INST REF. DV 1369/324

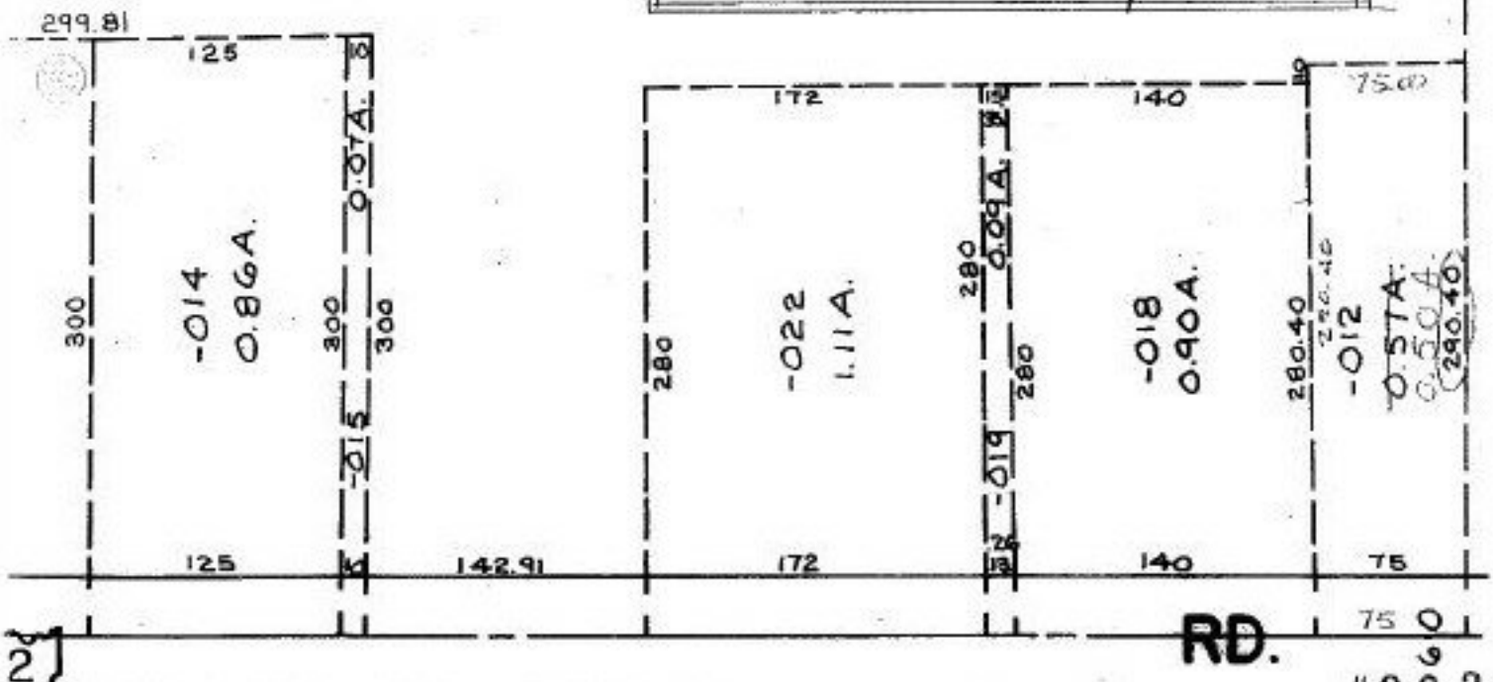

SEE 12-00-006-A

#22228-A

APPROVED
LORAIN CO.
MAP DEPT.
8-6-97
12-00-005-A
K. Colbert
22228-A