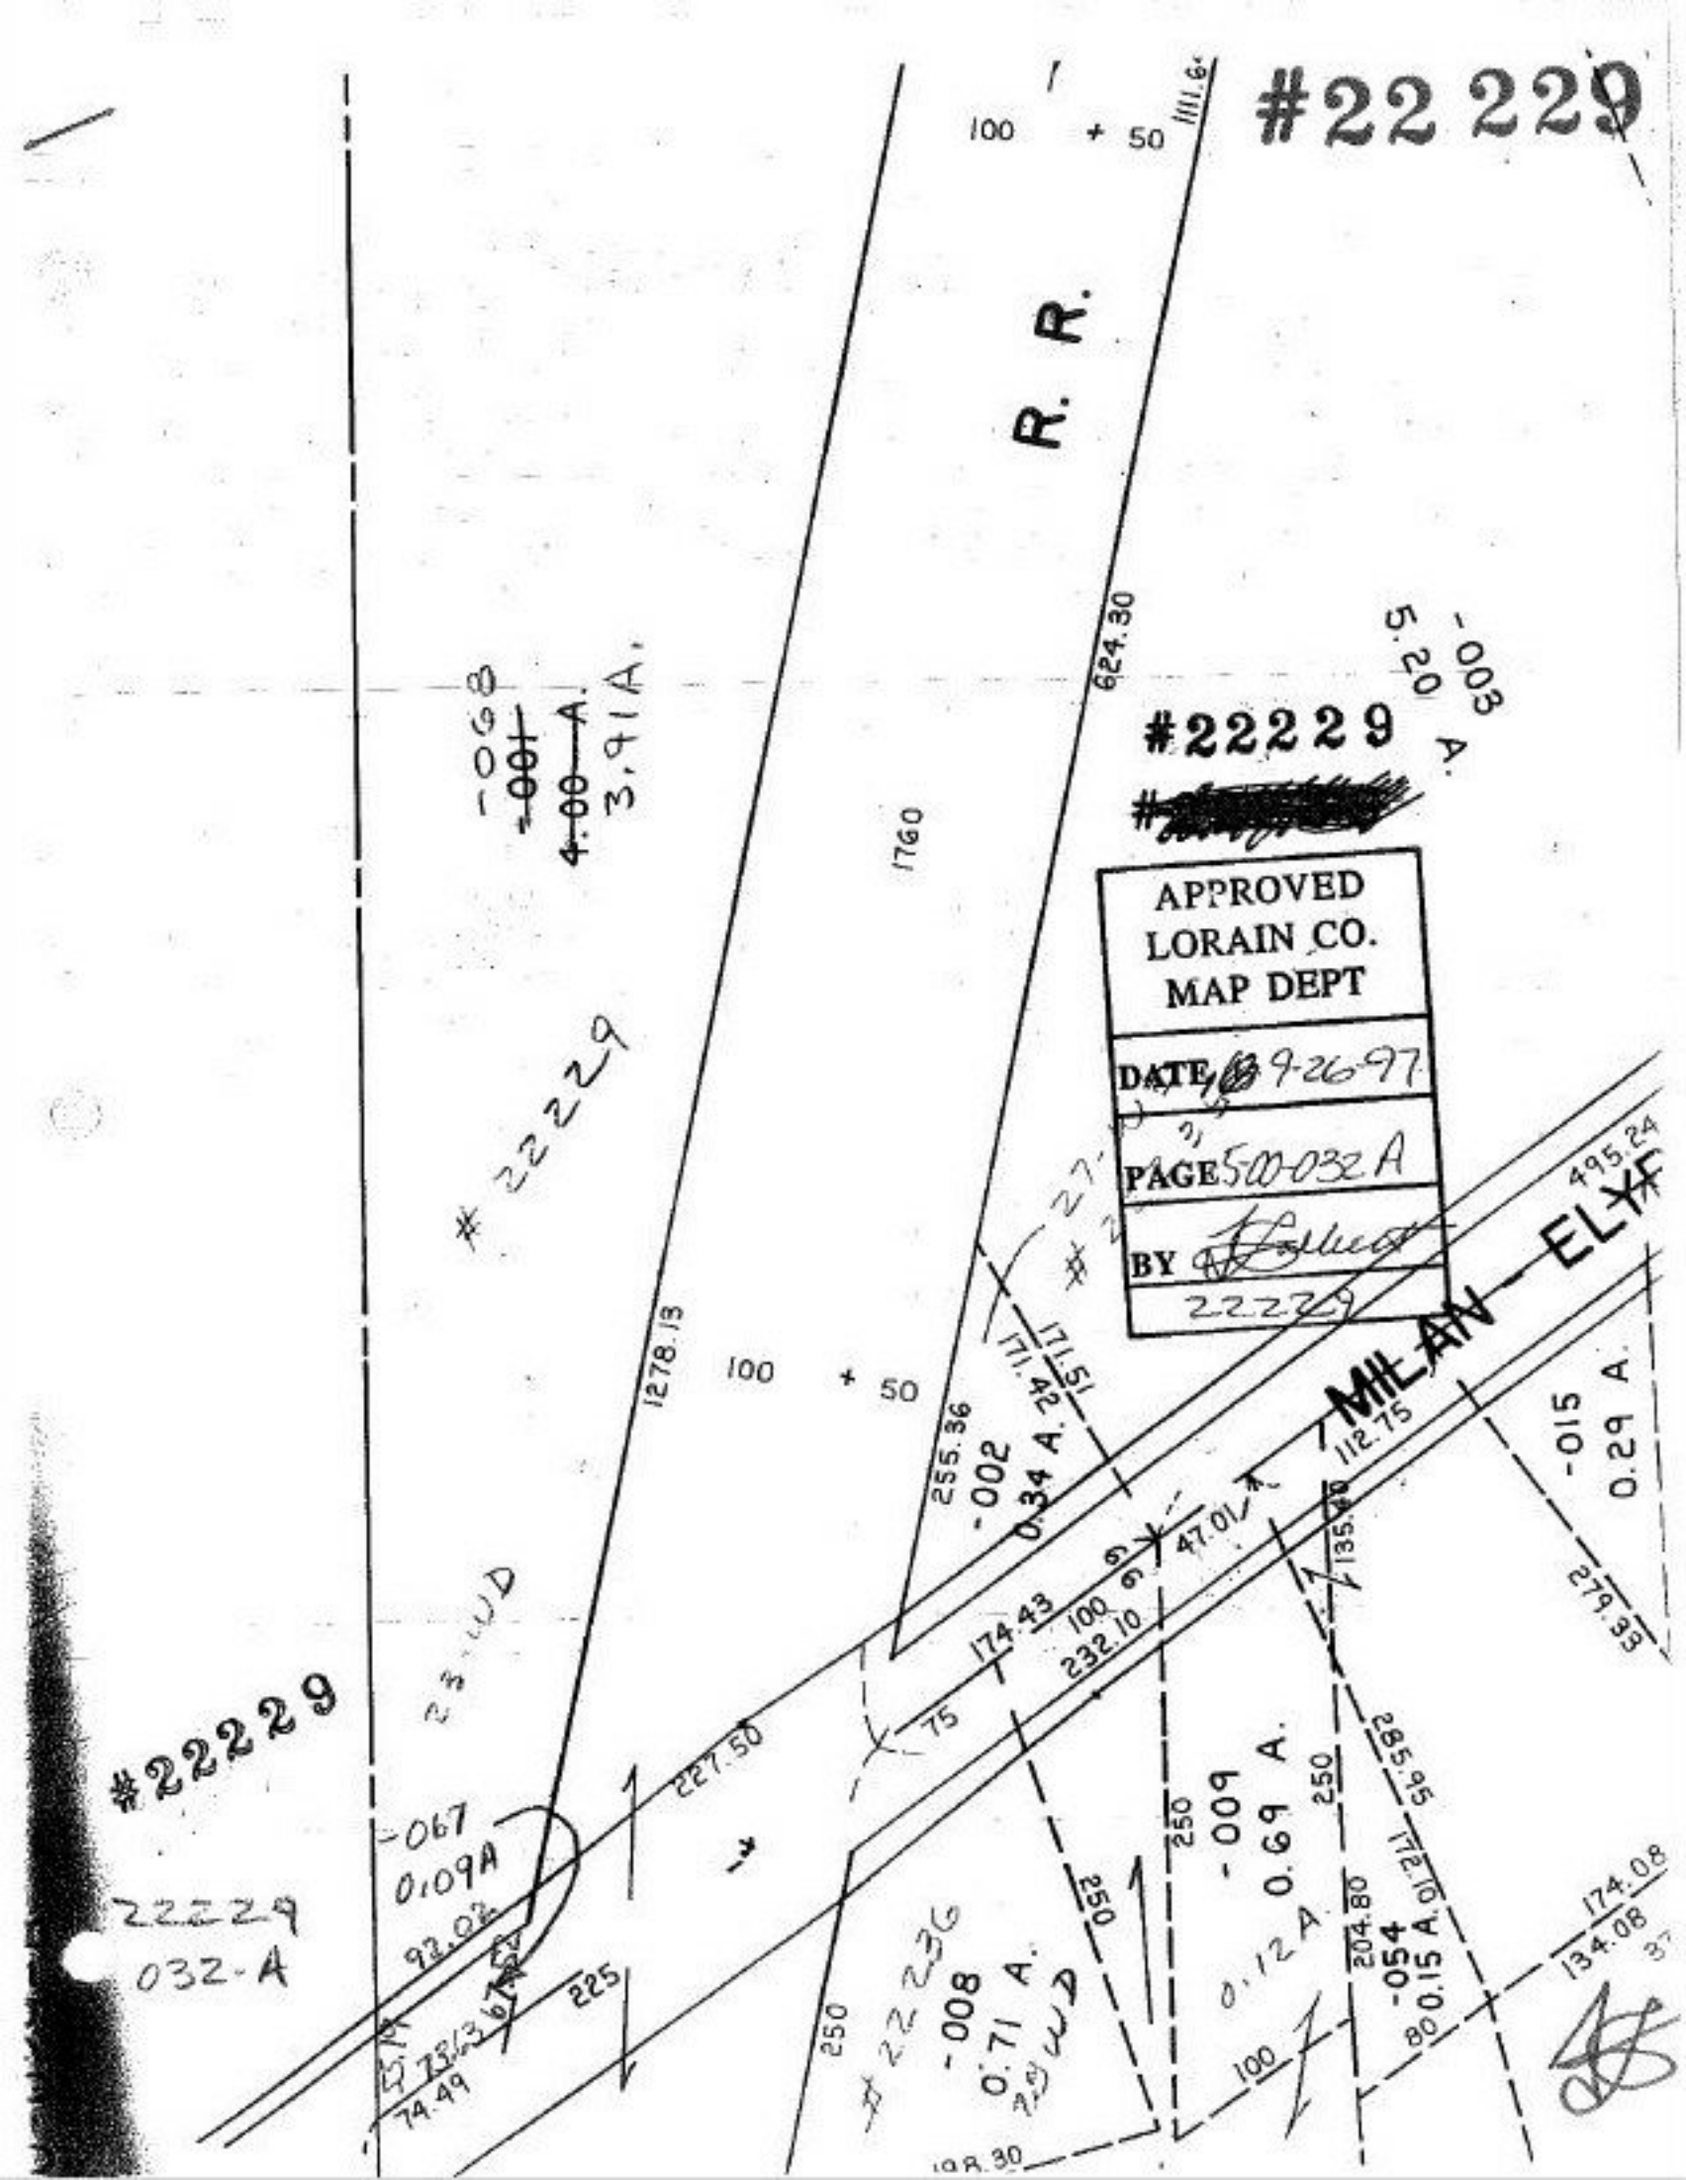
#22229
100 + 50
1111.6'
R. R.
624.30
-003
5.20 A.
#22229
#[redacted]
APPROVED
LORAIN CO.
MAP DEPT
DATE 9-26-97
PAGE 500-032 A
BY
22229
-068
-001
4.00 A.
3.91 A.
#22229
1760
1278.13
100 + 50
255.36
-002
0.34 A.
171.24
171.51
MILAN-ELYR
495.24
112.75
-015
0.29 A.
47.01
135.40
279.33
174.43
100
232.10
75
227.50
#22229
-067
0.09A
92.02
225
250
-009
0.69 A.
250
285.95
172.10
-008
0.71 A.
#22236
-054
0.15 A.
204.80
174.08
134.08
80
100
198.30
22229
032-A