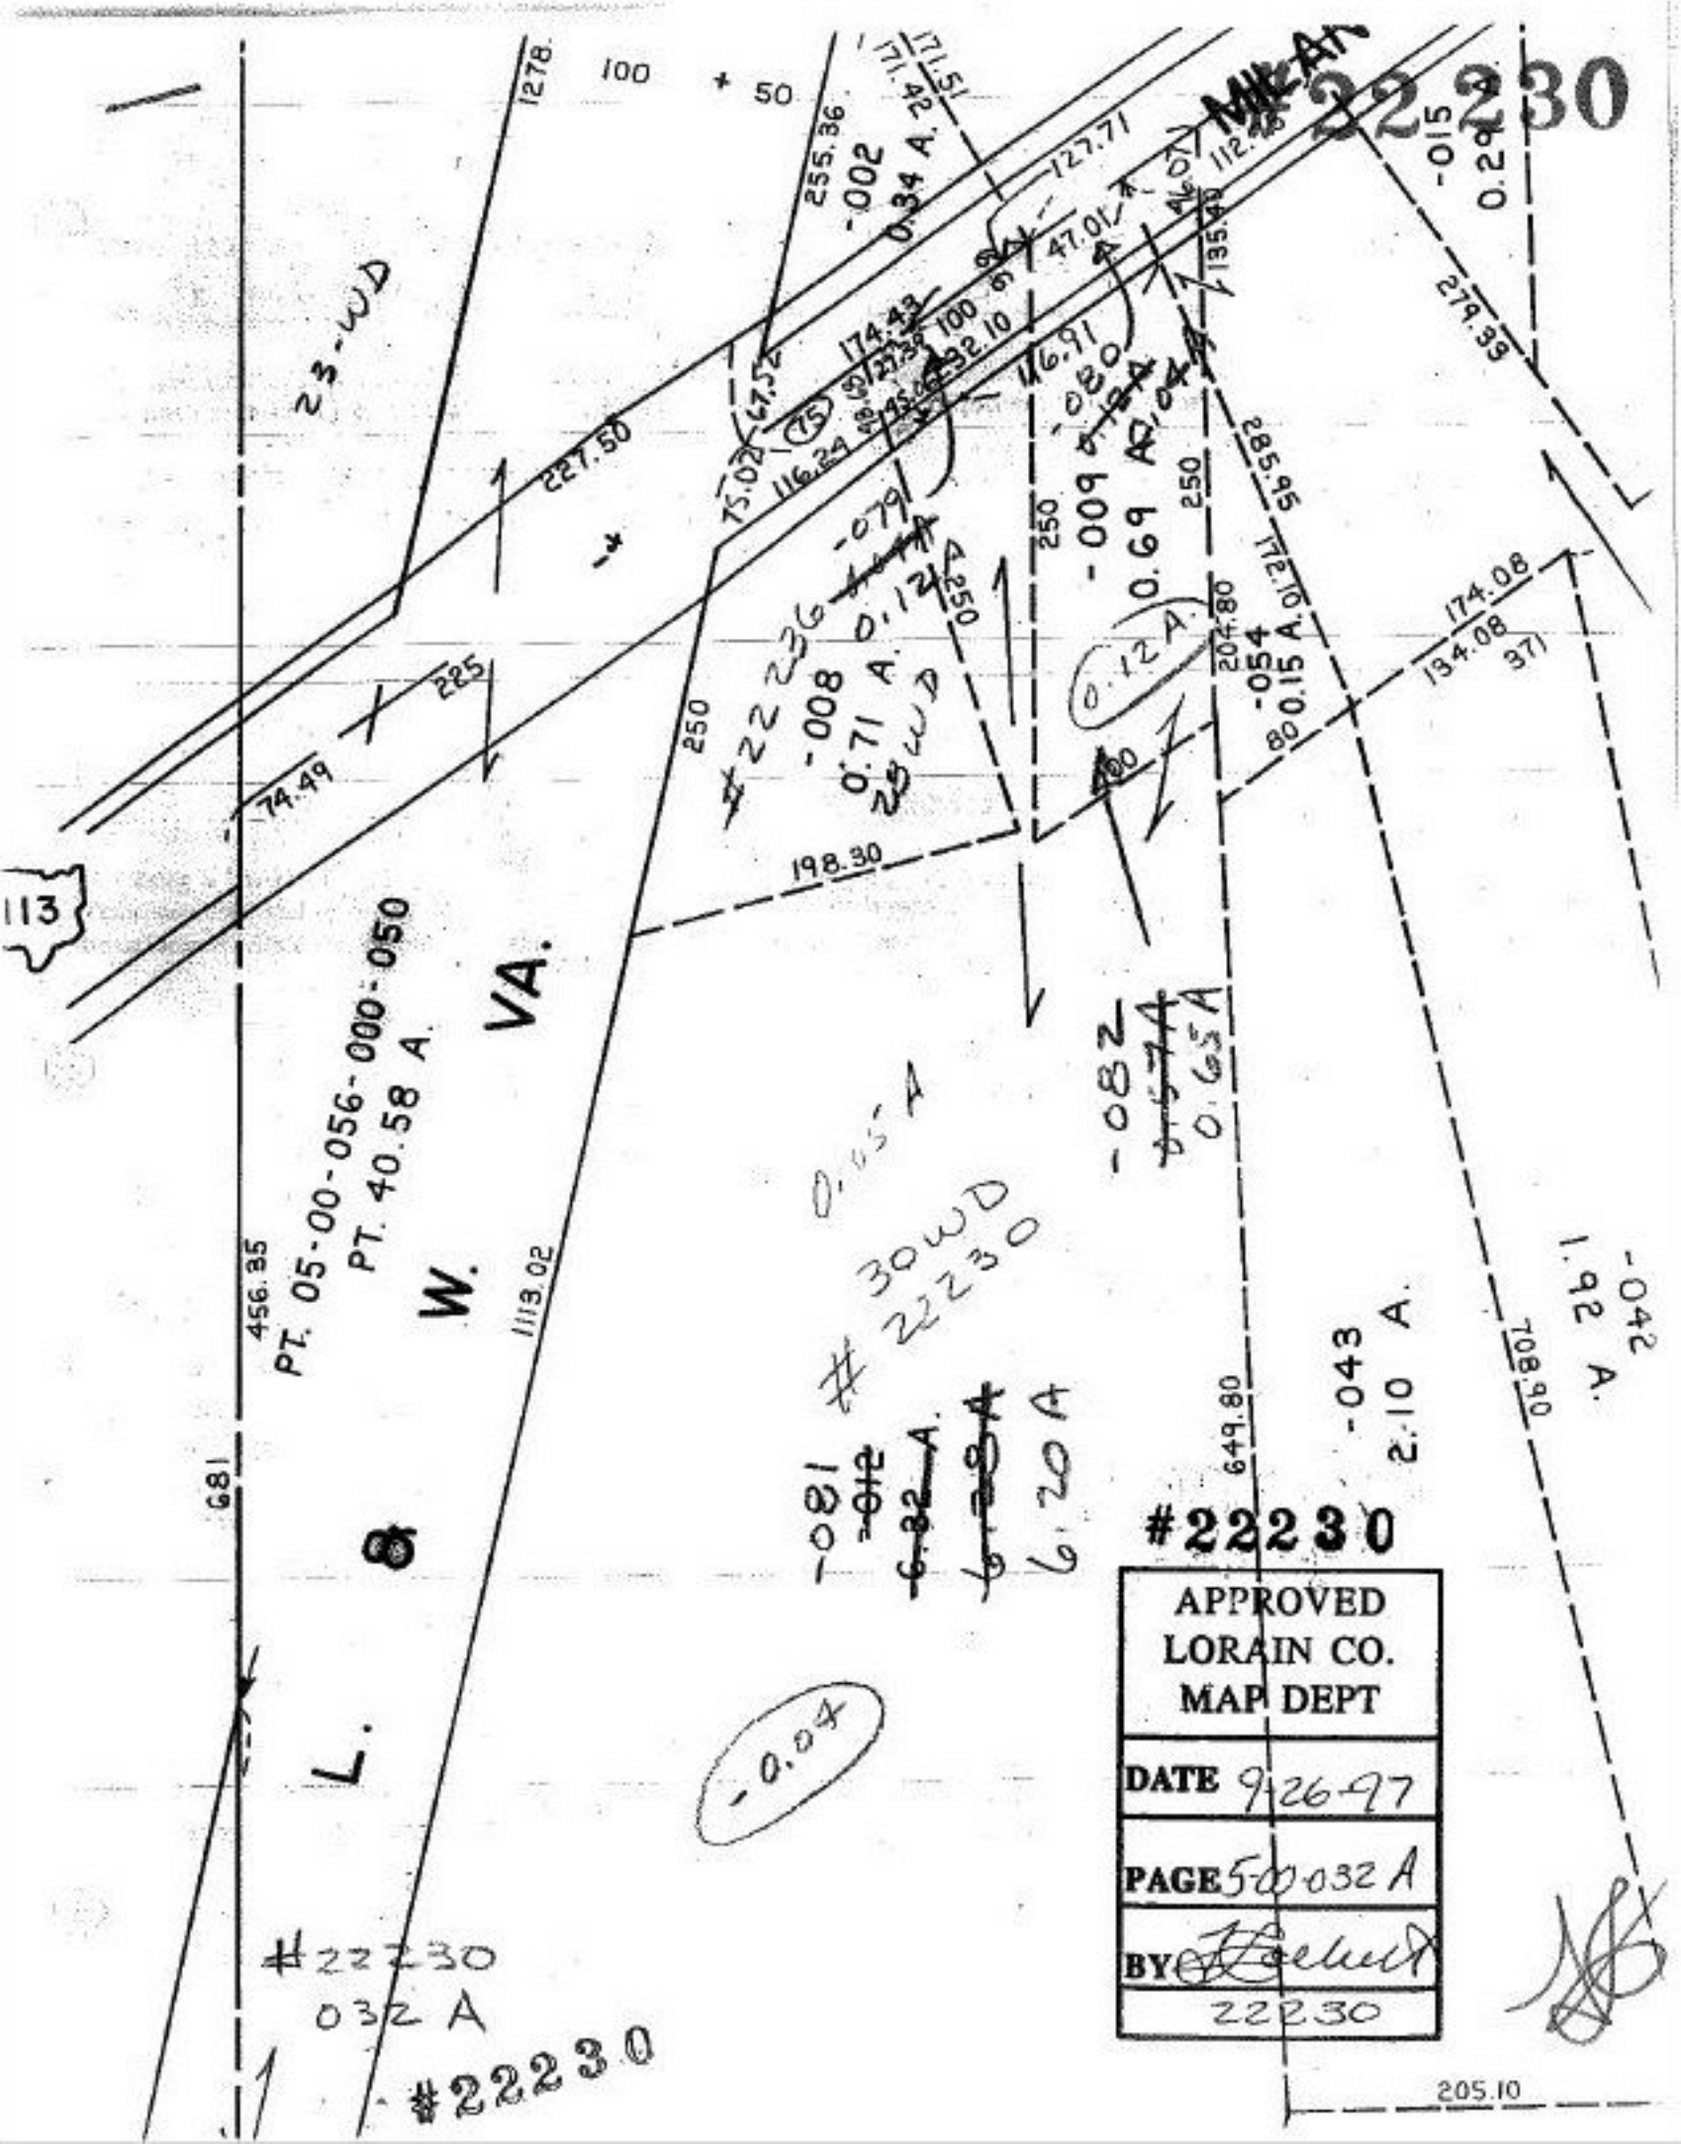
#22230
APPROVED
LORAIN CO.
MAP DEPT
DATE 9-26-97
PAGE 50-032 A
BY
22230
L. & W. VA.
PT. 05-00-056-000-050
PT. 40.58 A.
113
23-WD
#22236
30WD
#22230
#22230
032 A
#22230