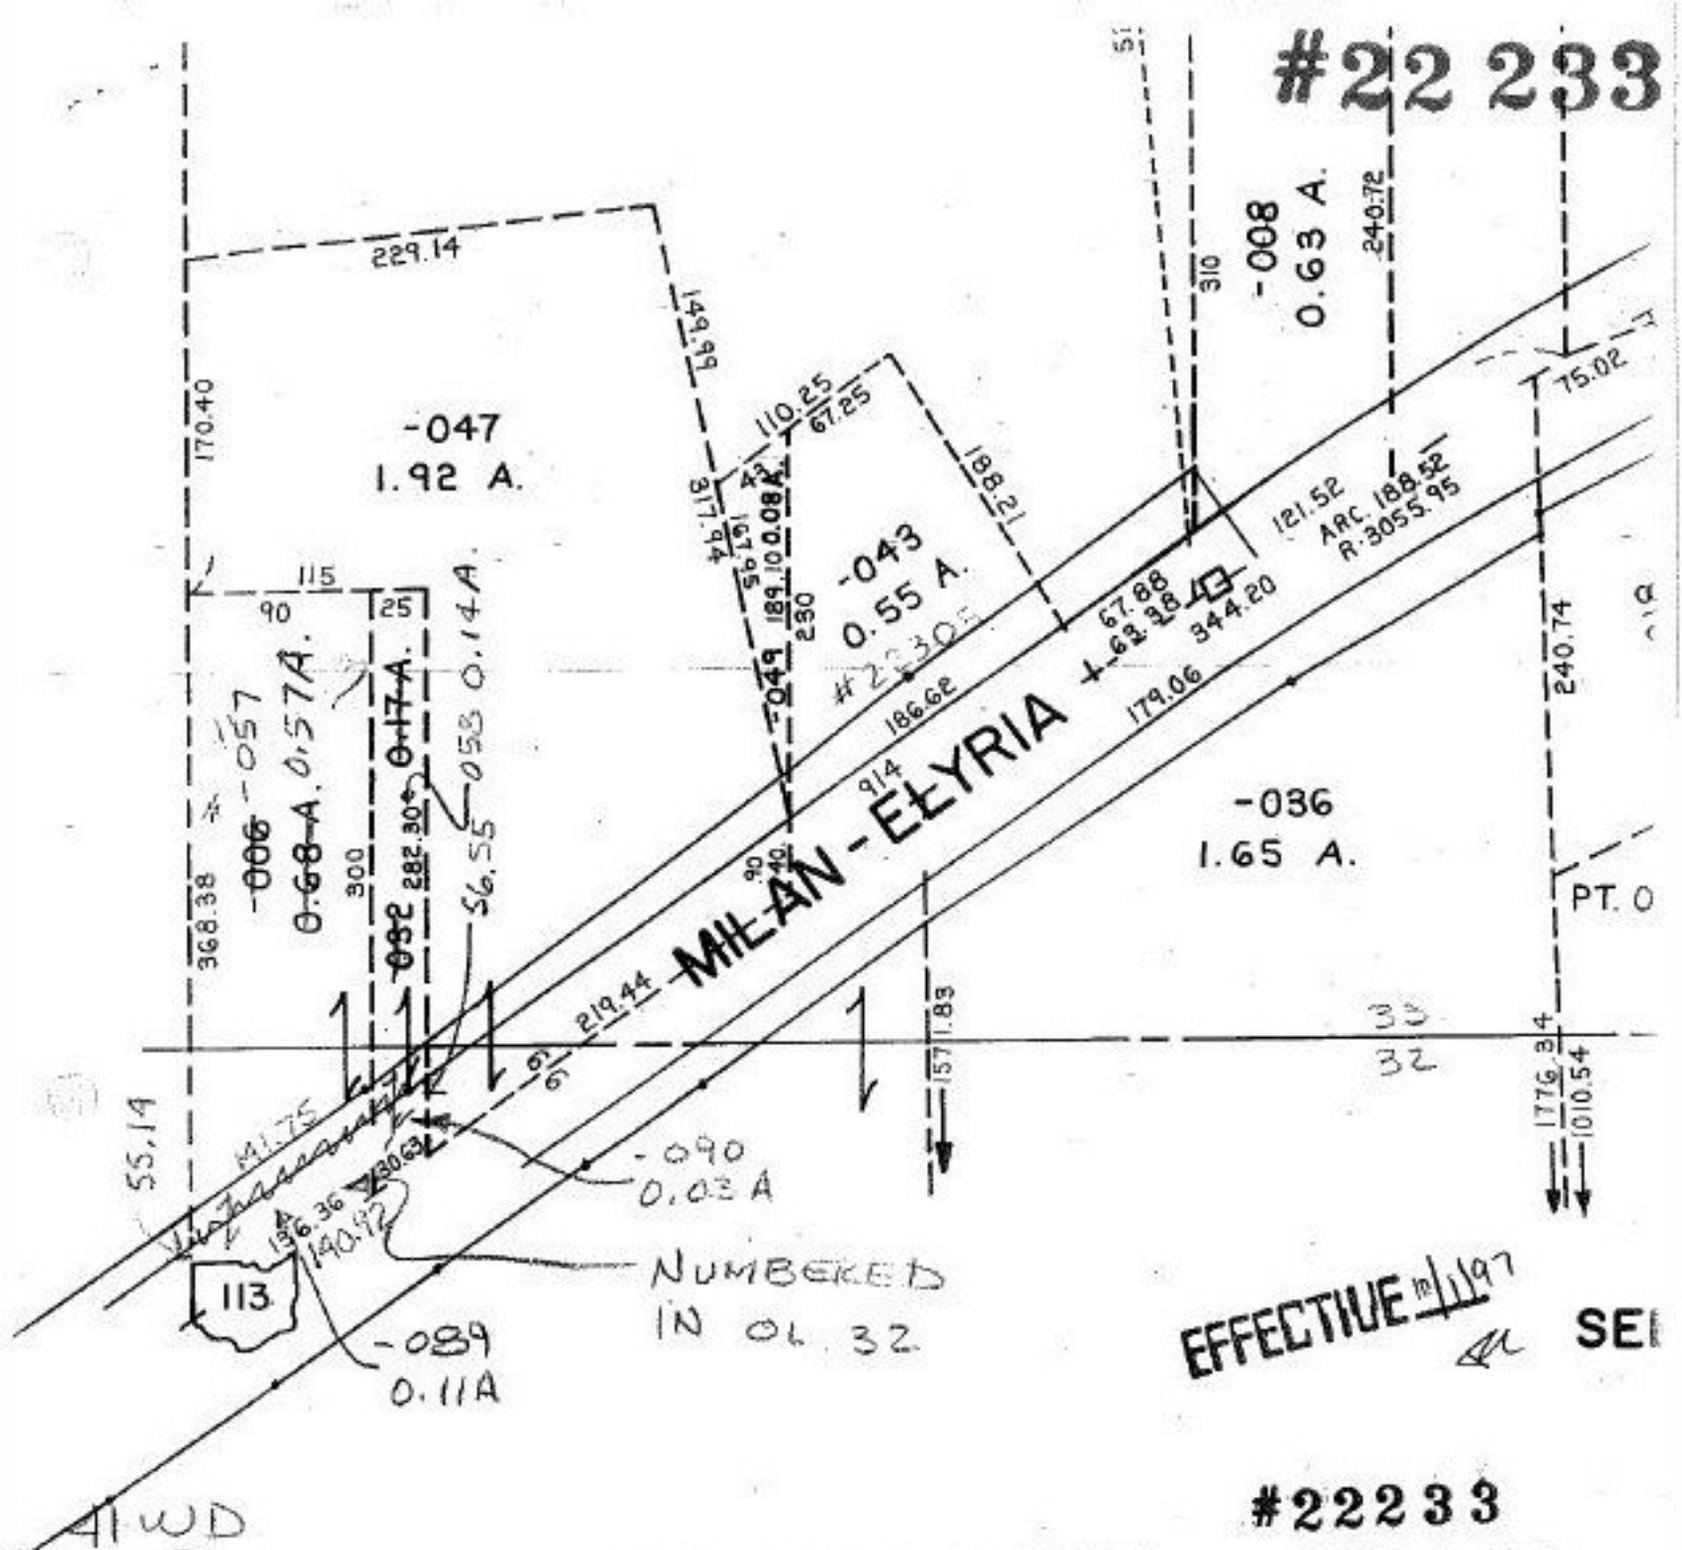

41 WD
033-B
22233

#22233

AMHERST TWP.

SCALE: 1" = 100'

APPROVED LORAIN CO. MAP DEPT
DATE 9-26-97
PAGE 5-00-033B
BY
22233

#22233