#22 238

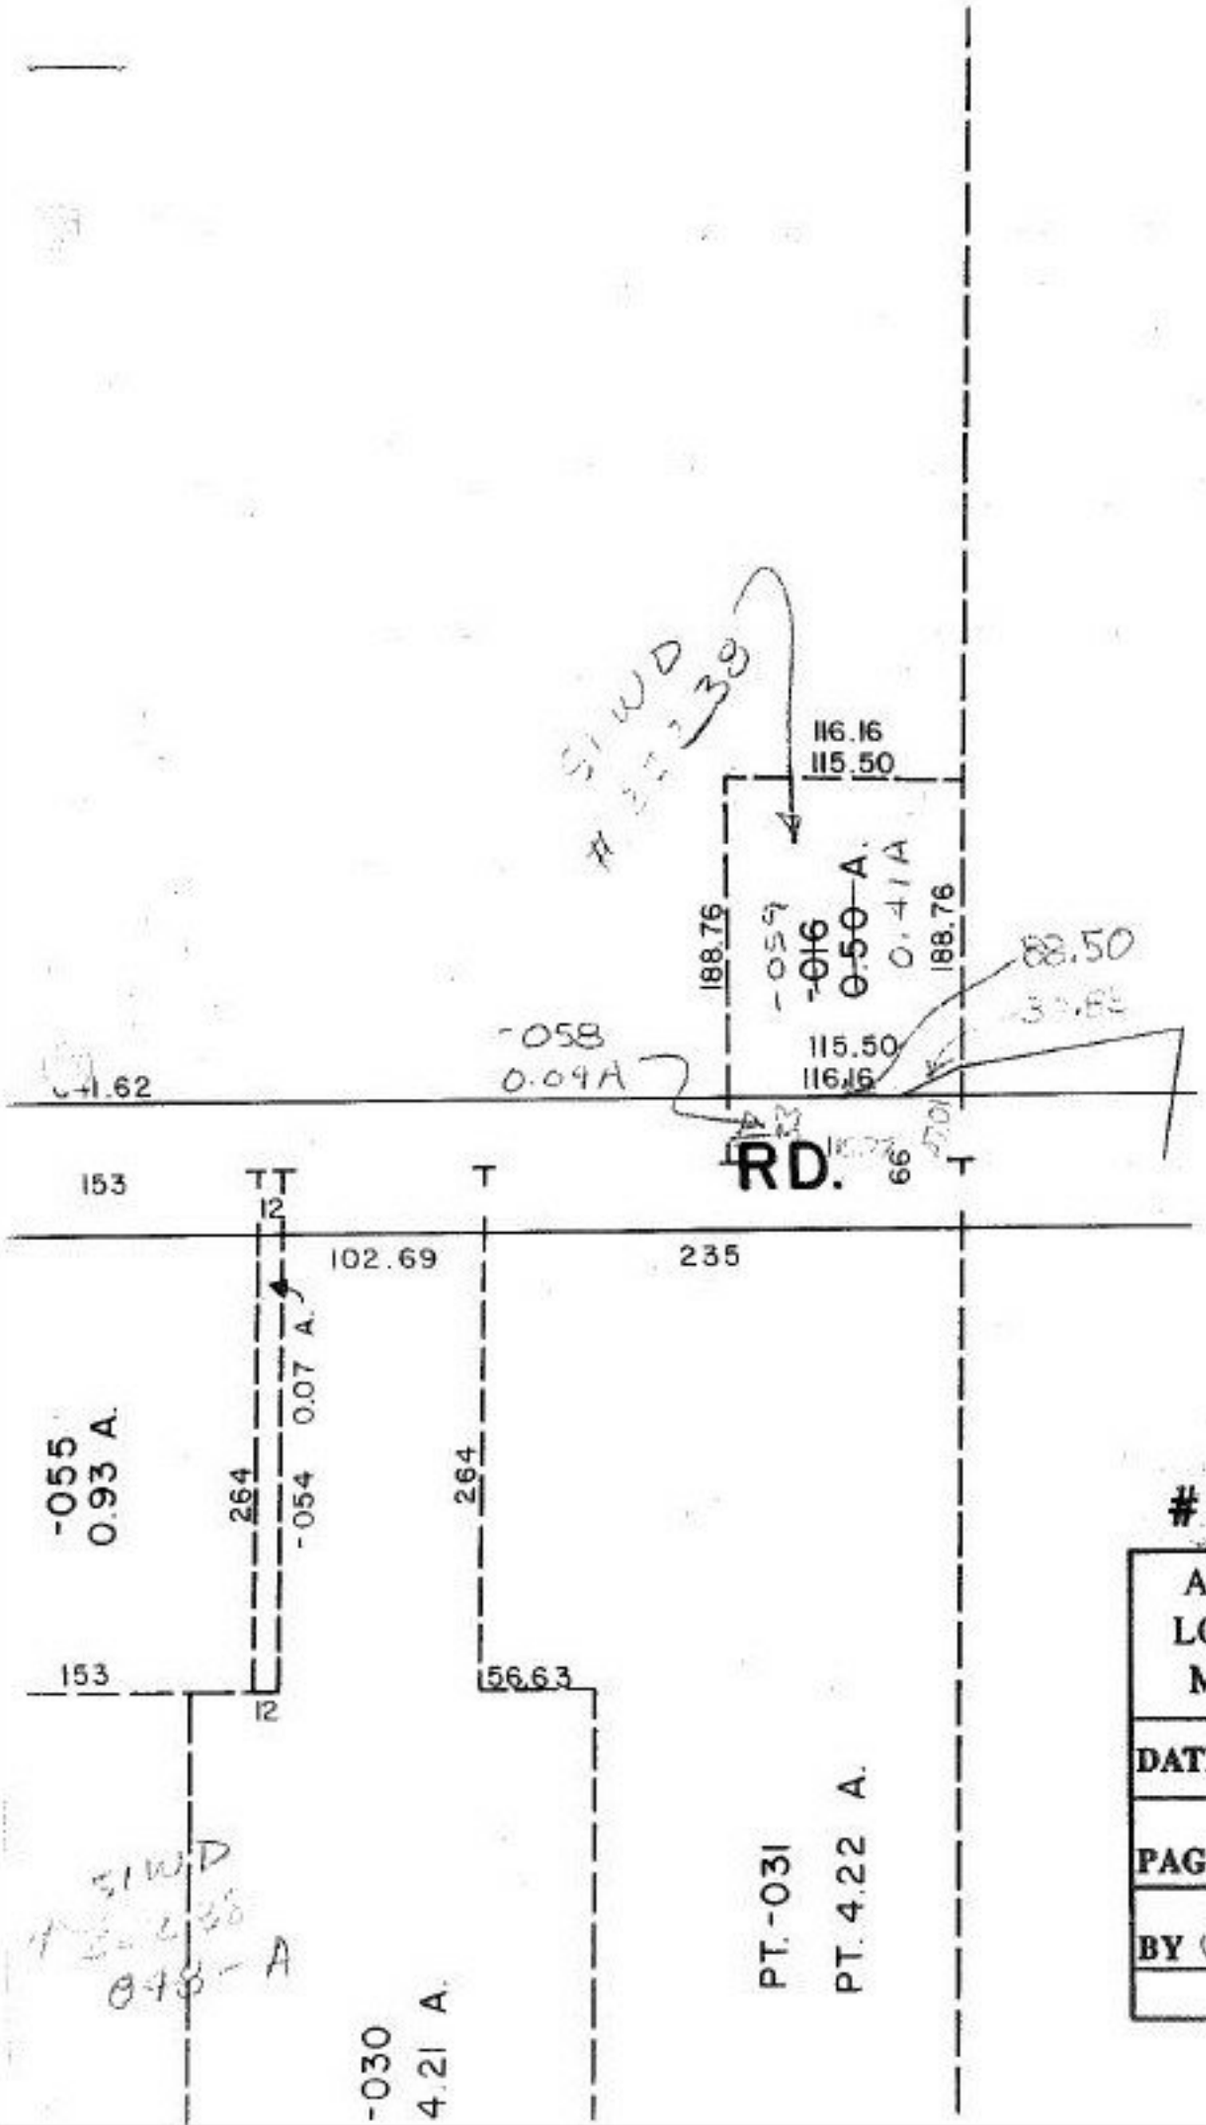

#22238

APPROVED
LORAIN CO.
MAP DEPT

DATE 9-26-97

PAGE 500048-A

BY

22238