#22 239

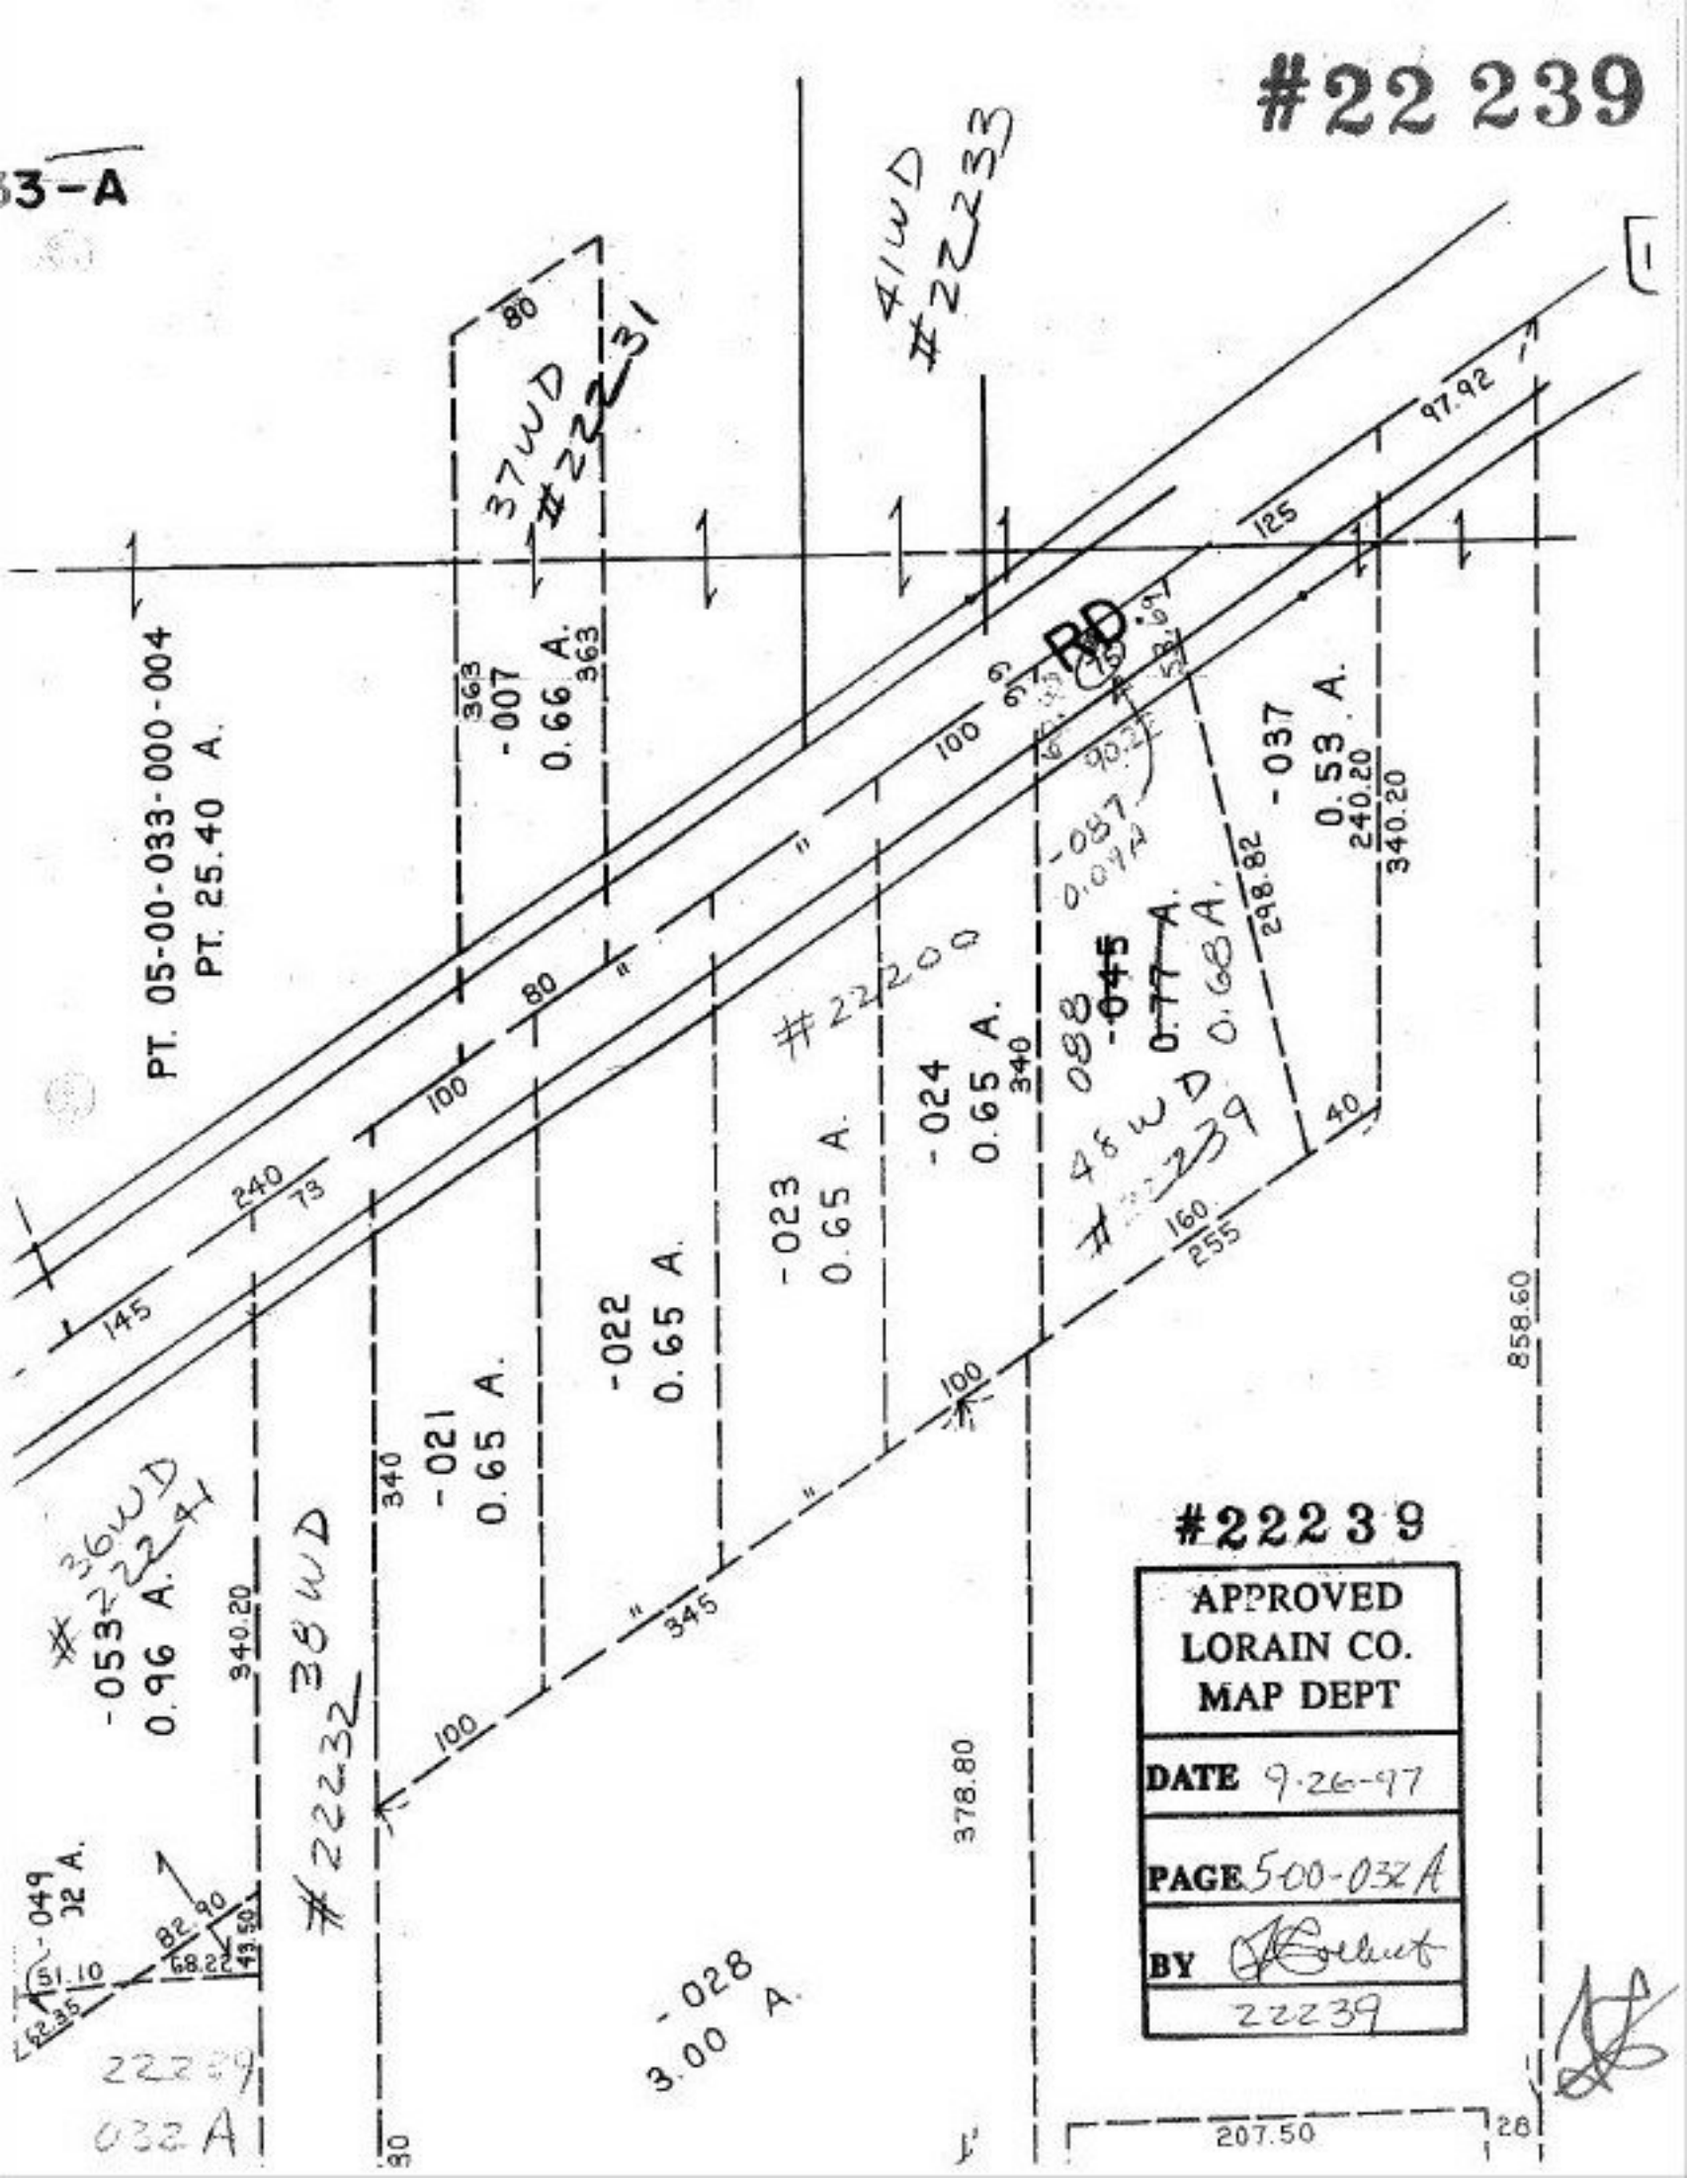

#22239

APPROVED
LORAIN CO.
MAP DEPT

DATE 9-26-97

PAGE 5-00-032A

BY [signature]

22239