#22 240

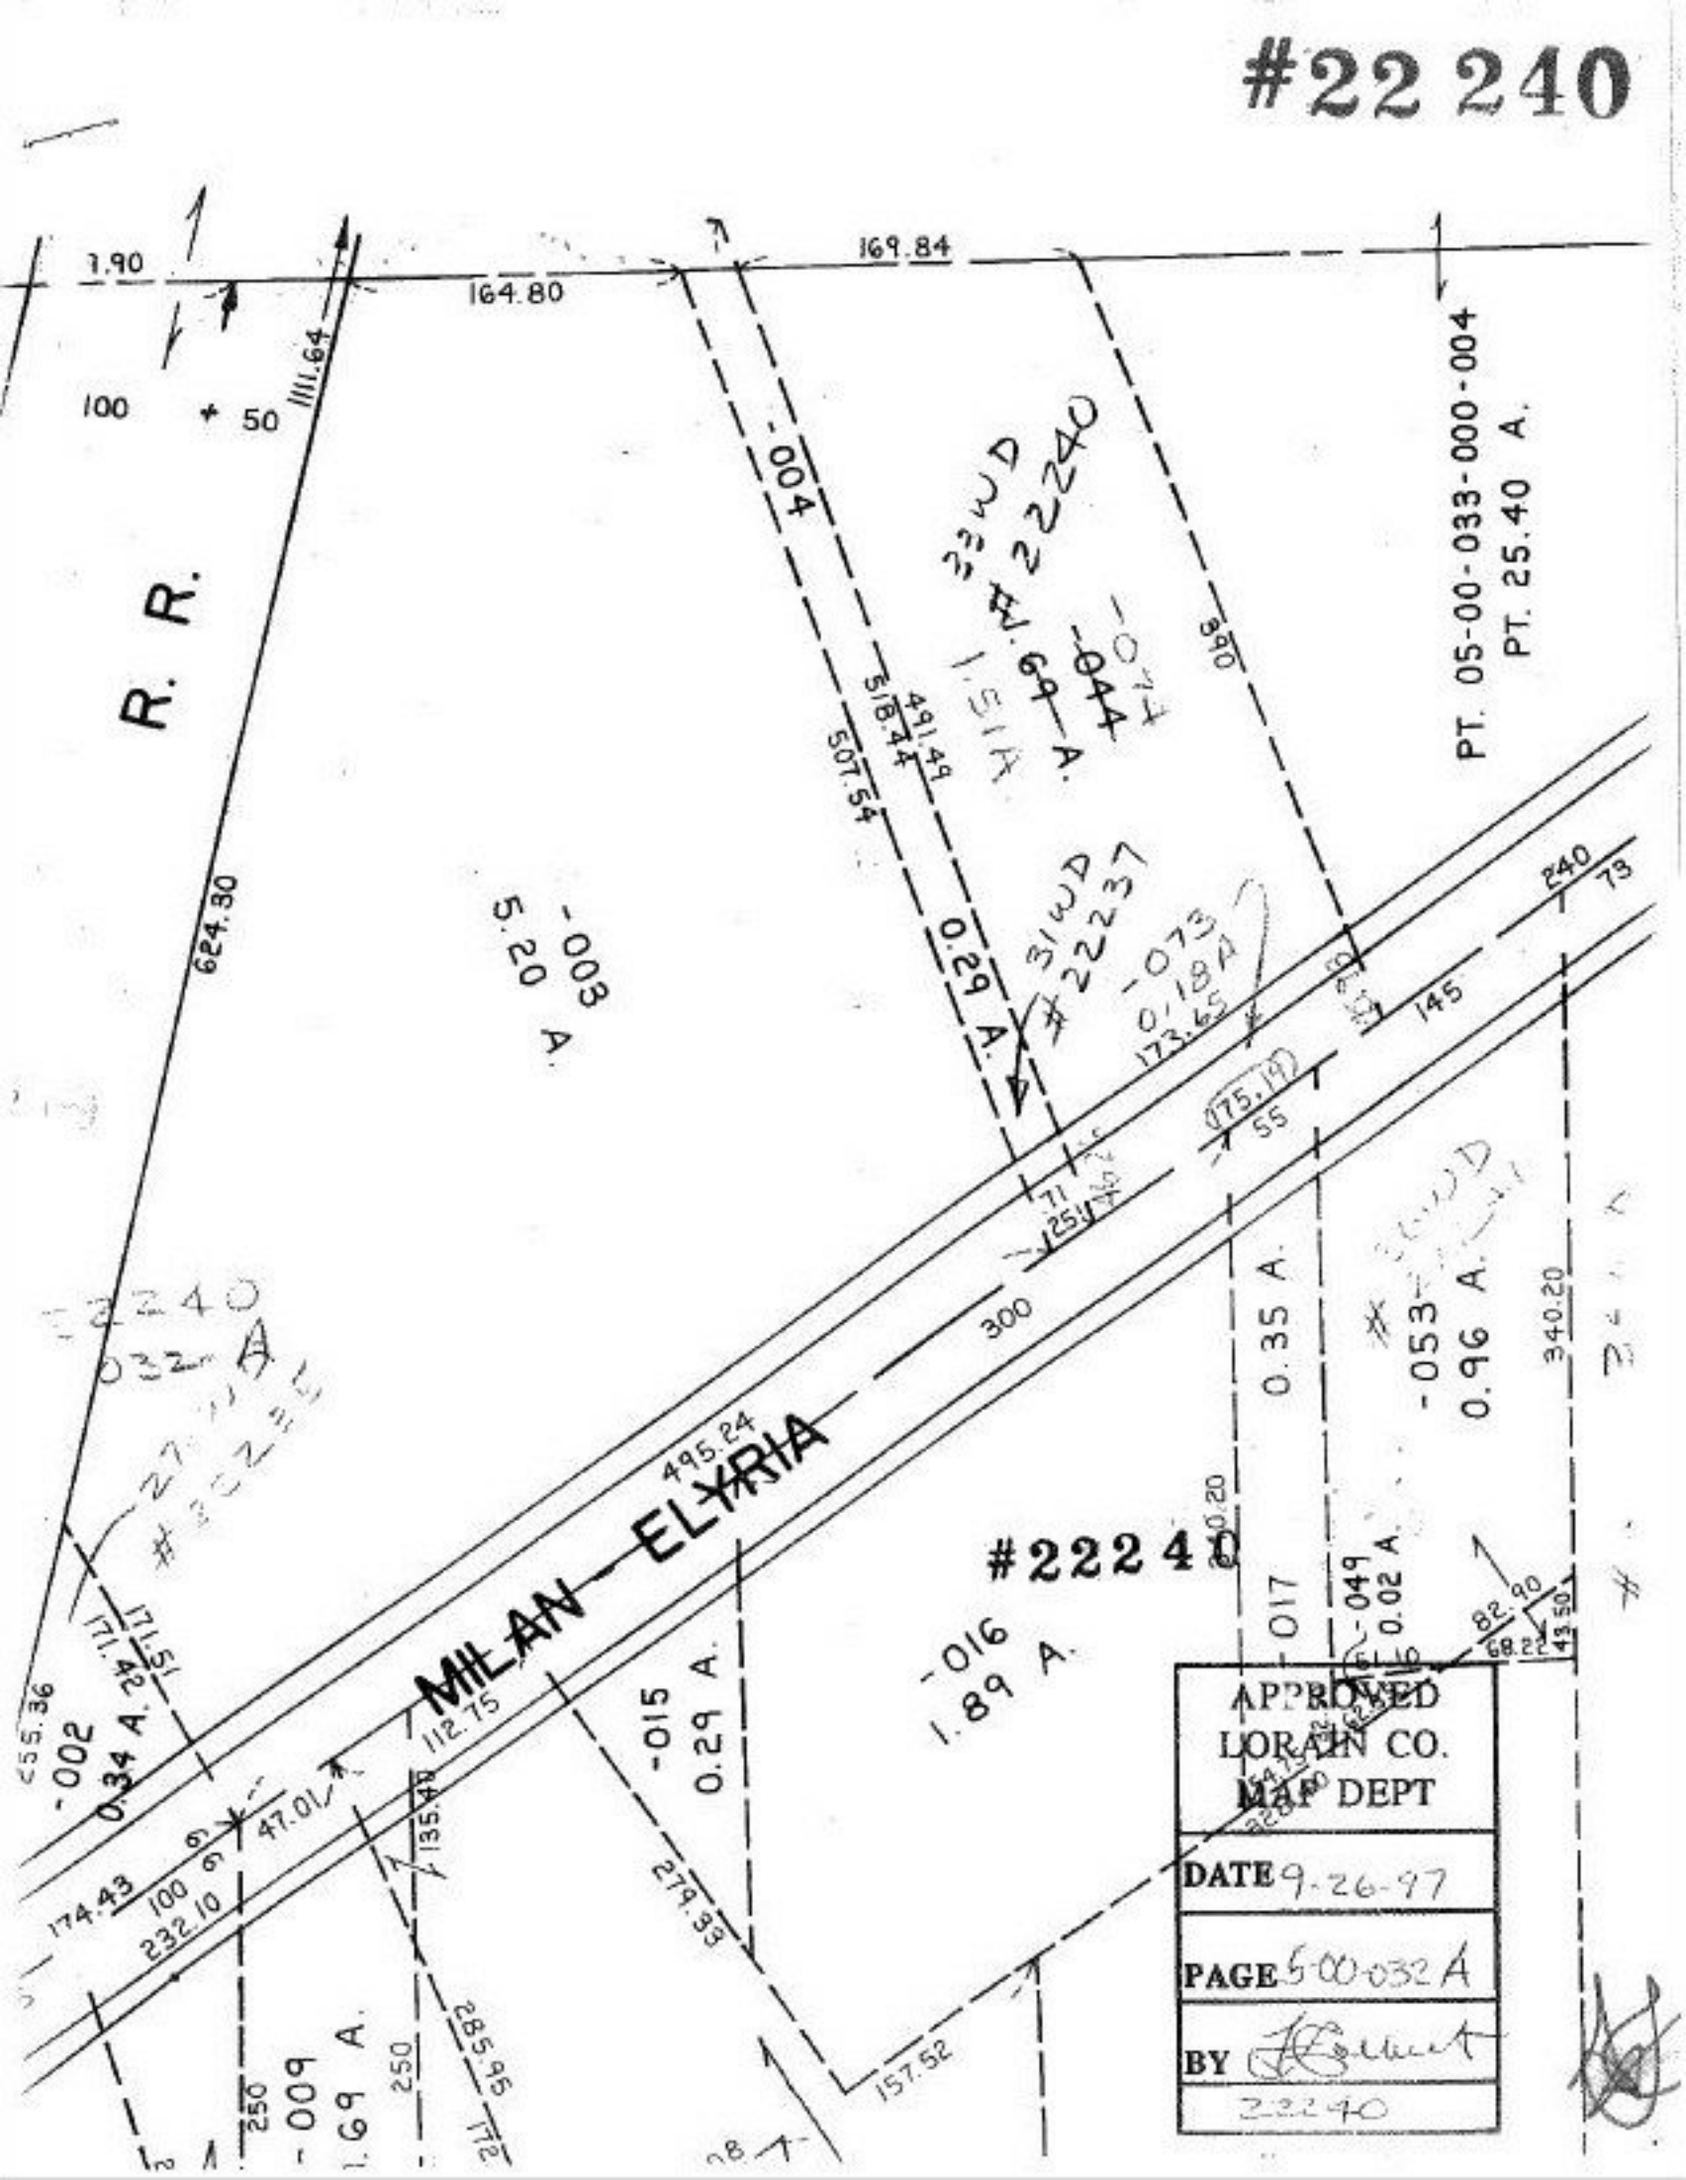
1.90
164.80
169.84
1111.64
100
50
R. R.
624.30
-004
518.44
507.54
49.49
0.29 A.
33 WD #22240
-044
1.51 A.
PT. 05-00-033-000-004
PT. 25.40 A.
-003
5.20 A.
33 WD #22237
-073
0.18 A.
173.65
240
73
145
55
71
125
300
MILAN - ELYRIA
495.24
-002
0.34 A.
171.51
112.75
47.01
135.49
174.43
100
232.10
-015
0.29 A.
279.33
-016
1.89 A.
#22240
0.35 A.
-053
0.96 A.
340.20
-017
-049
0.02 A.
82.90
68.22
43.50
157.52
250
285.96
-009
1.69 A.
APPROVED
LORAIN CO.
MAP DEPT
DATE 9-26-97
PAGE 5-00-032 A
BY
22240