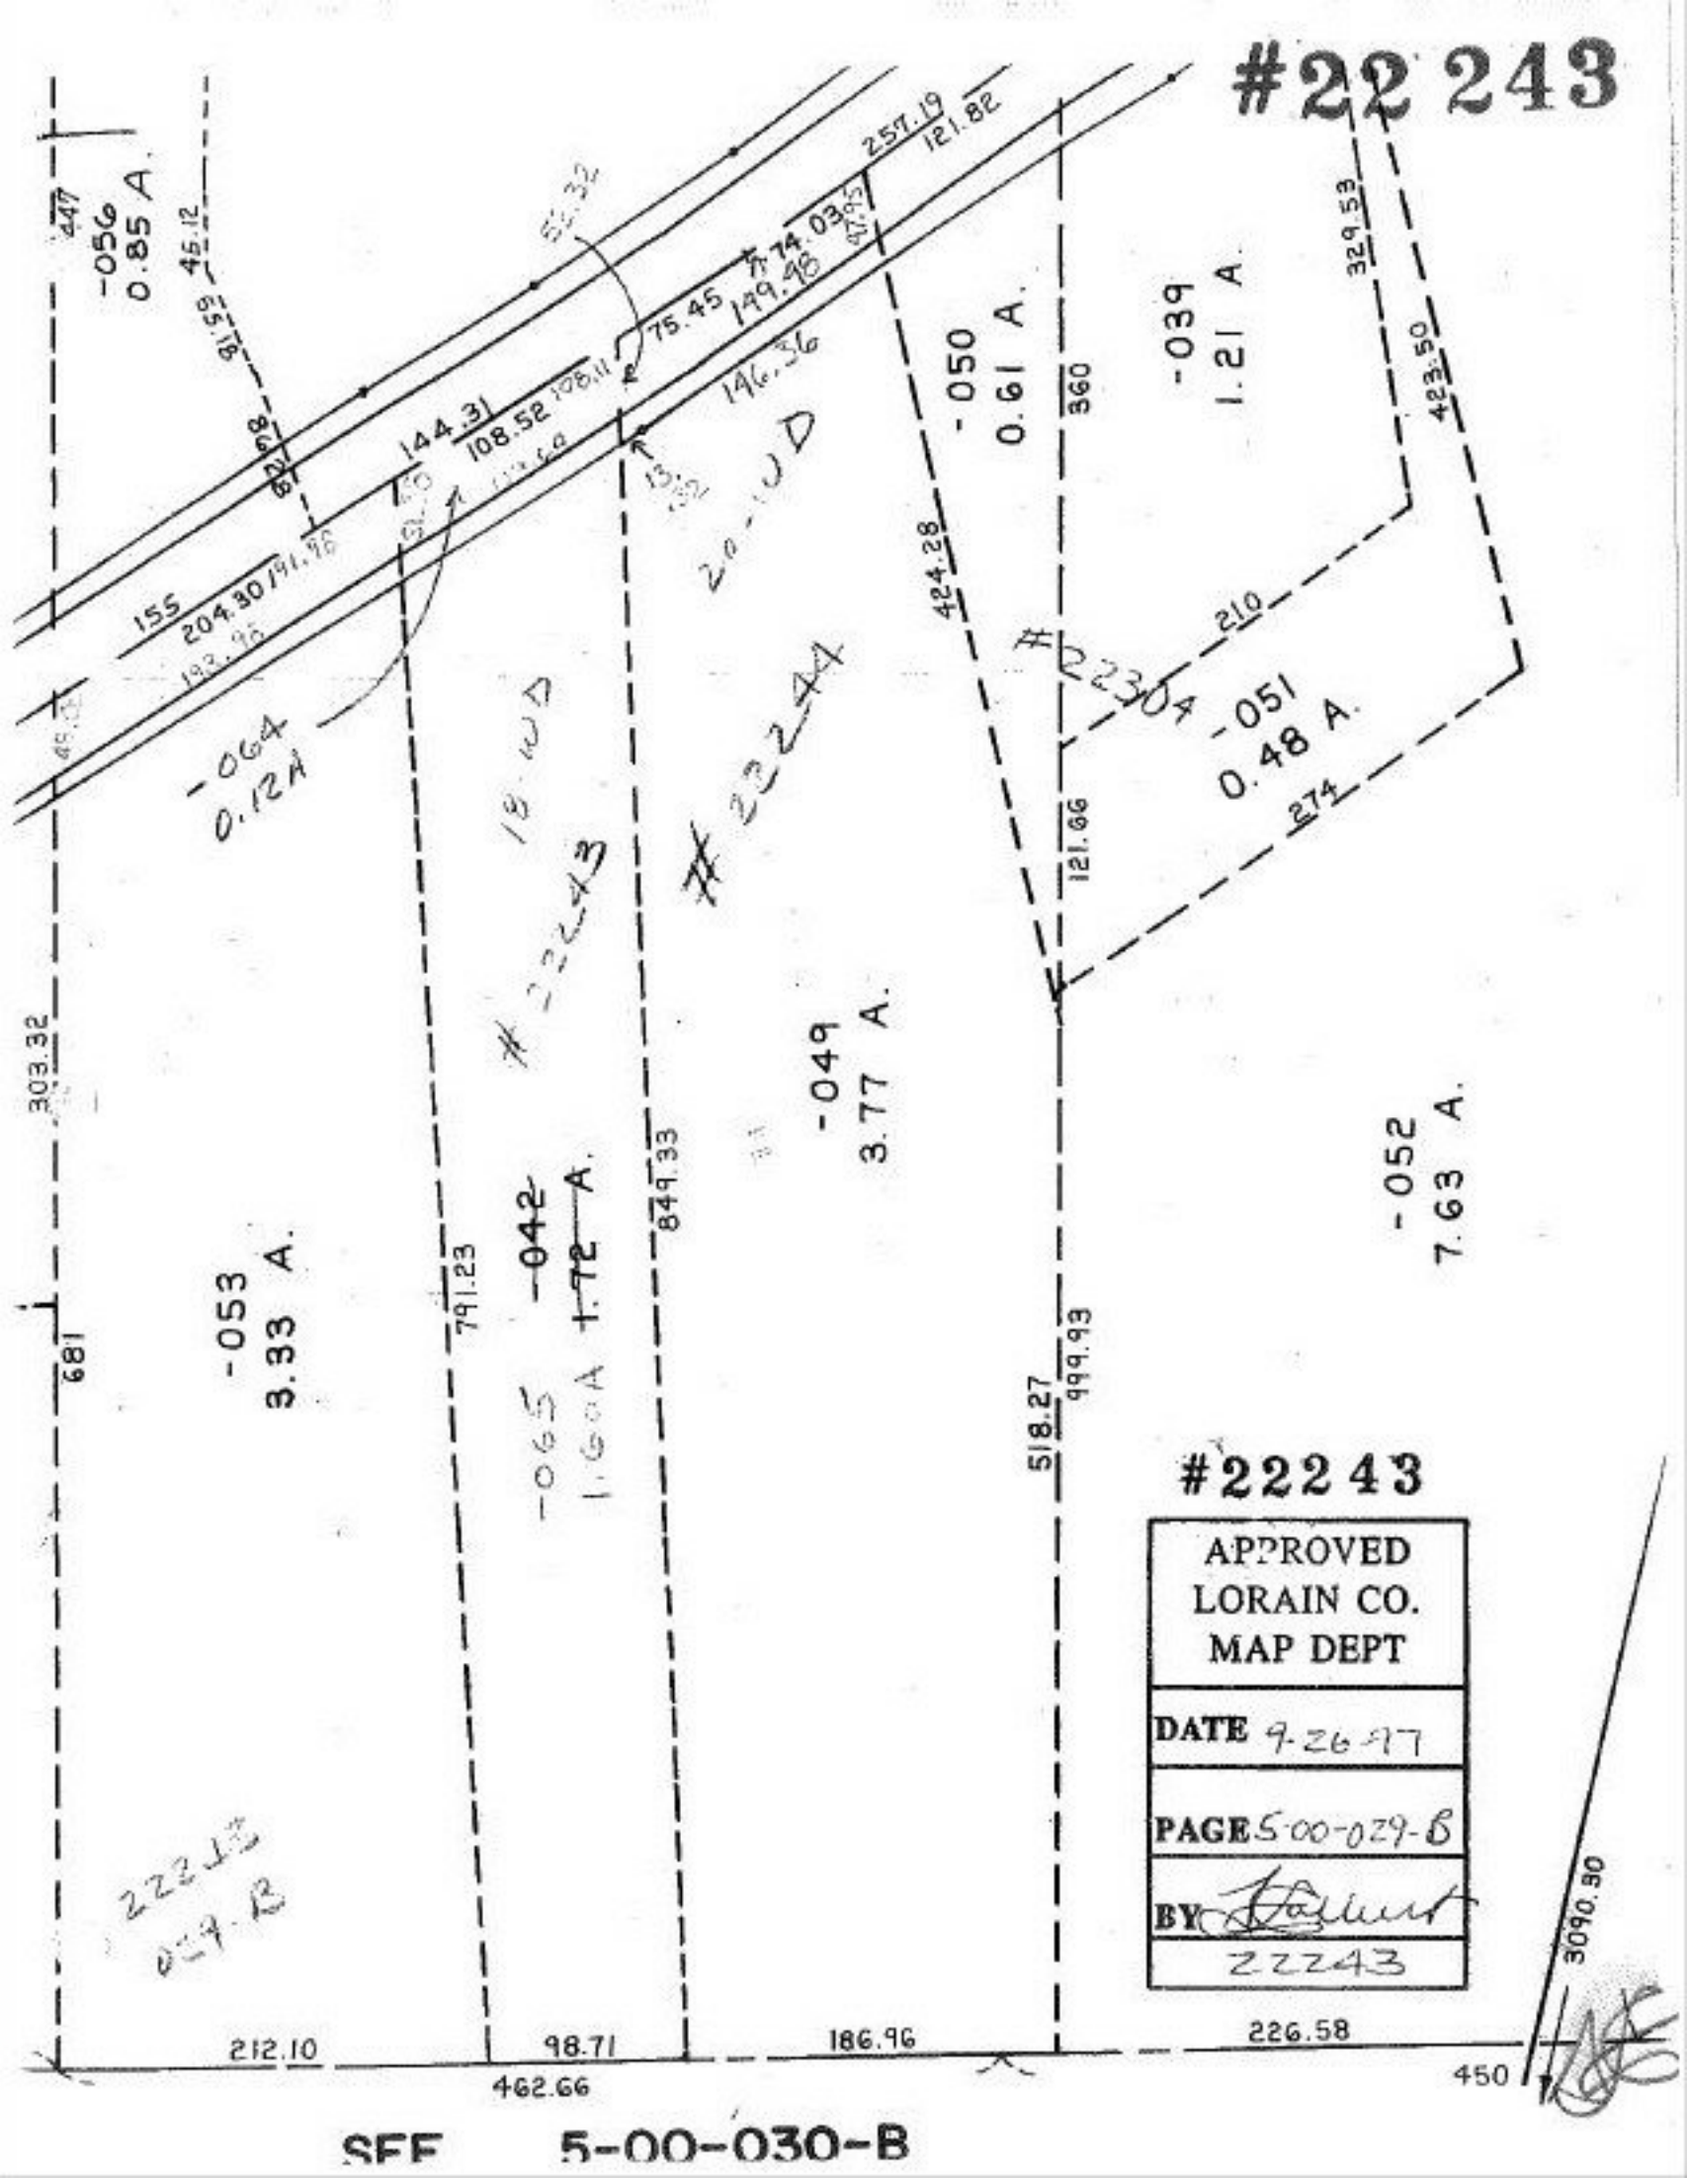
#22243
-056
0.85 A.
-064
0.12A
-053
3.33 A.
-042
1.72 A.
-065
1.66A
-049
3.77 A.
-050
0.61 A.
-039
1.21 A.
-051
0.48 A.
-052
7.63 A.
#22244
#22243
#22243
APPROVED
LORAIN CO.
MAP DEPT
DATE 9-26-97
PAGE 5-00-029-B
BY
22243
SEE 5-00-030-B