#22245-U

PARENT PARCEL: 09-00-086-104-001
CHILD PARCEL: 09-00-086-104-010, 011
STARTING POINT:

NO. 22245-U

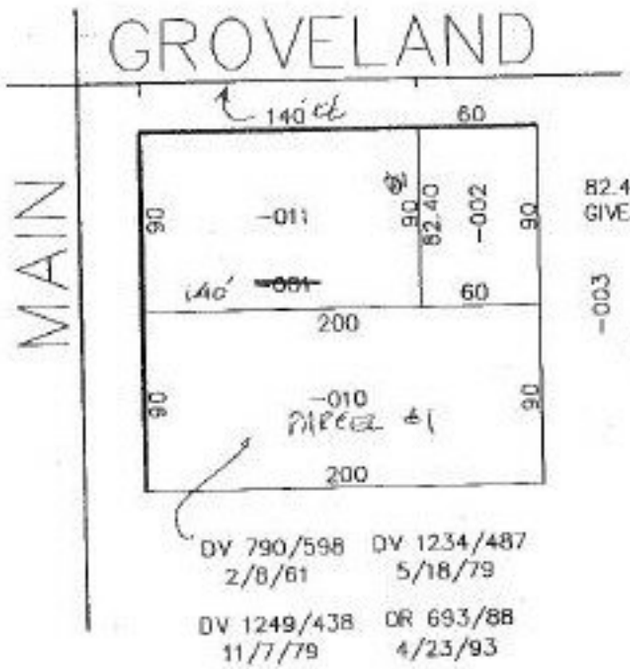

82.40 IS FROM DEED, OUR MAP GIVES A DISTANCE OF 90.

UNCOMBINATION PER DEEDS:
OR 693/88
OR 1207/152

SPLITS/DEEDS PROCESSED
LORAIN COUNTY TAX MAP DEPARTMENT
226 MIDDLE AVE. ELYRIA, OHIO

PRIOR INSTRUMENT: OR 693/88, OR 1207/152
CLOSURE:
MAP PAGE(S): 09-00-086-A
APPROVED BY: KAC DATE: 8/11/97
SCALE: 1" = 100