#22 245

NO. 22245

PARENT PARCEL: 10-00-005-107-044, 155, 156, 380

CHILD PARCEL: 10-00-005-107-386, 387, 390, 392, 393

STARTING POINT: NW CORNER SUBLOT 43

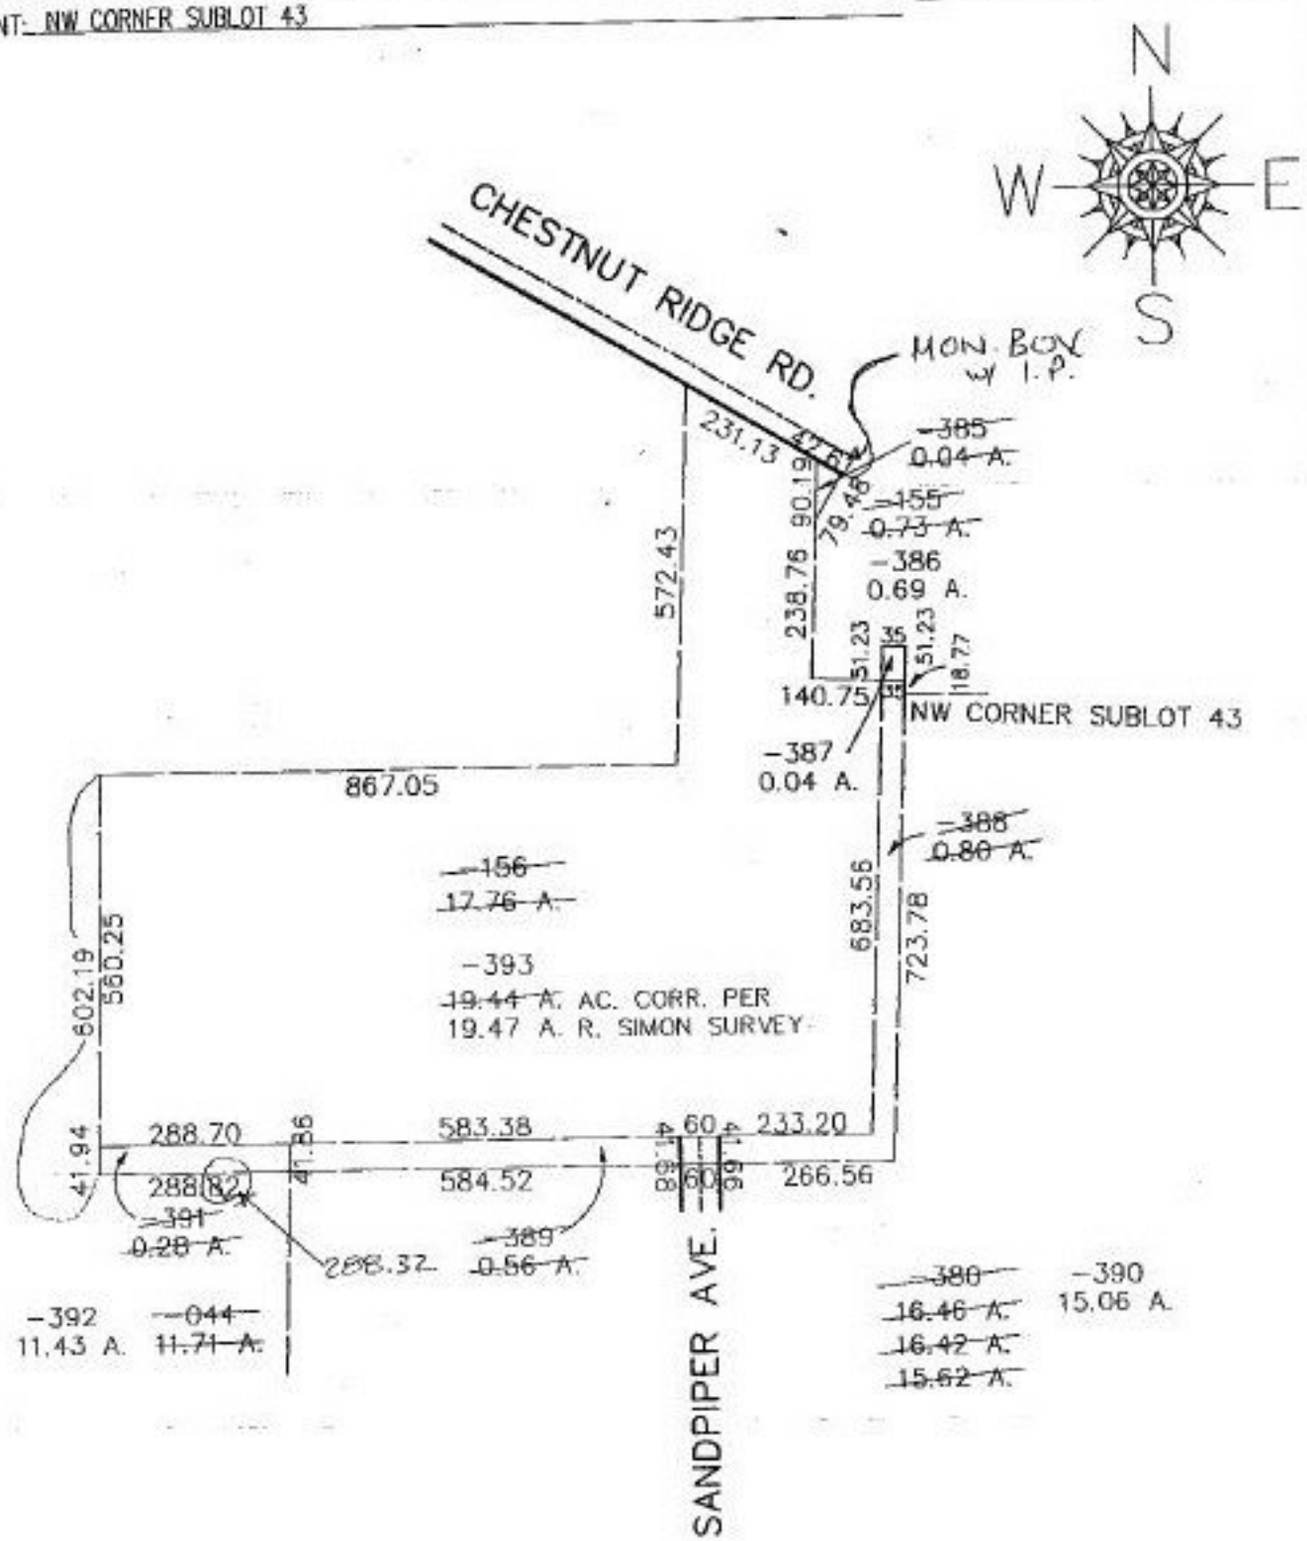

SPLITS/DEEDS PROCESSED

LORAIN COUNTY TAX MAP DEPARTMENT

226 MIDDLE AVE. ELYRIA, OHIO

SURVEYED BY: RODGER C. SIMON

CLOSURE: 0.80:10,000

MAP PAGE(S): 10-00-005-F,G,H

APPROVED BY: KAC DATE: 7/25/97

SCALE: 1" = 300