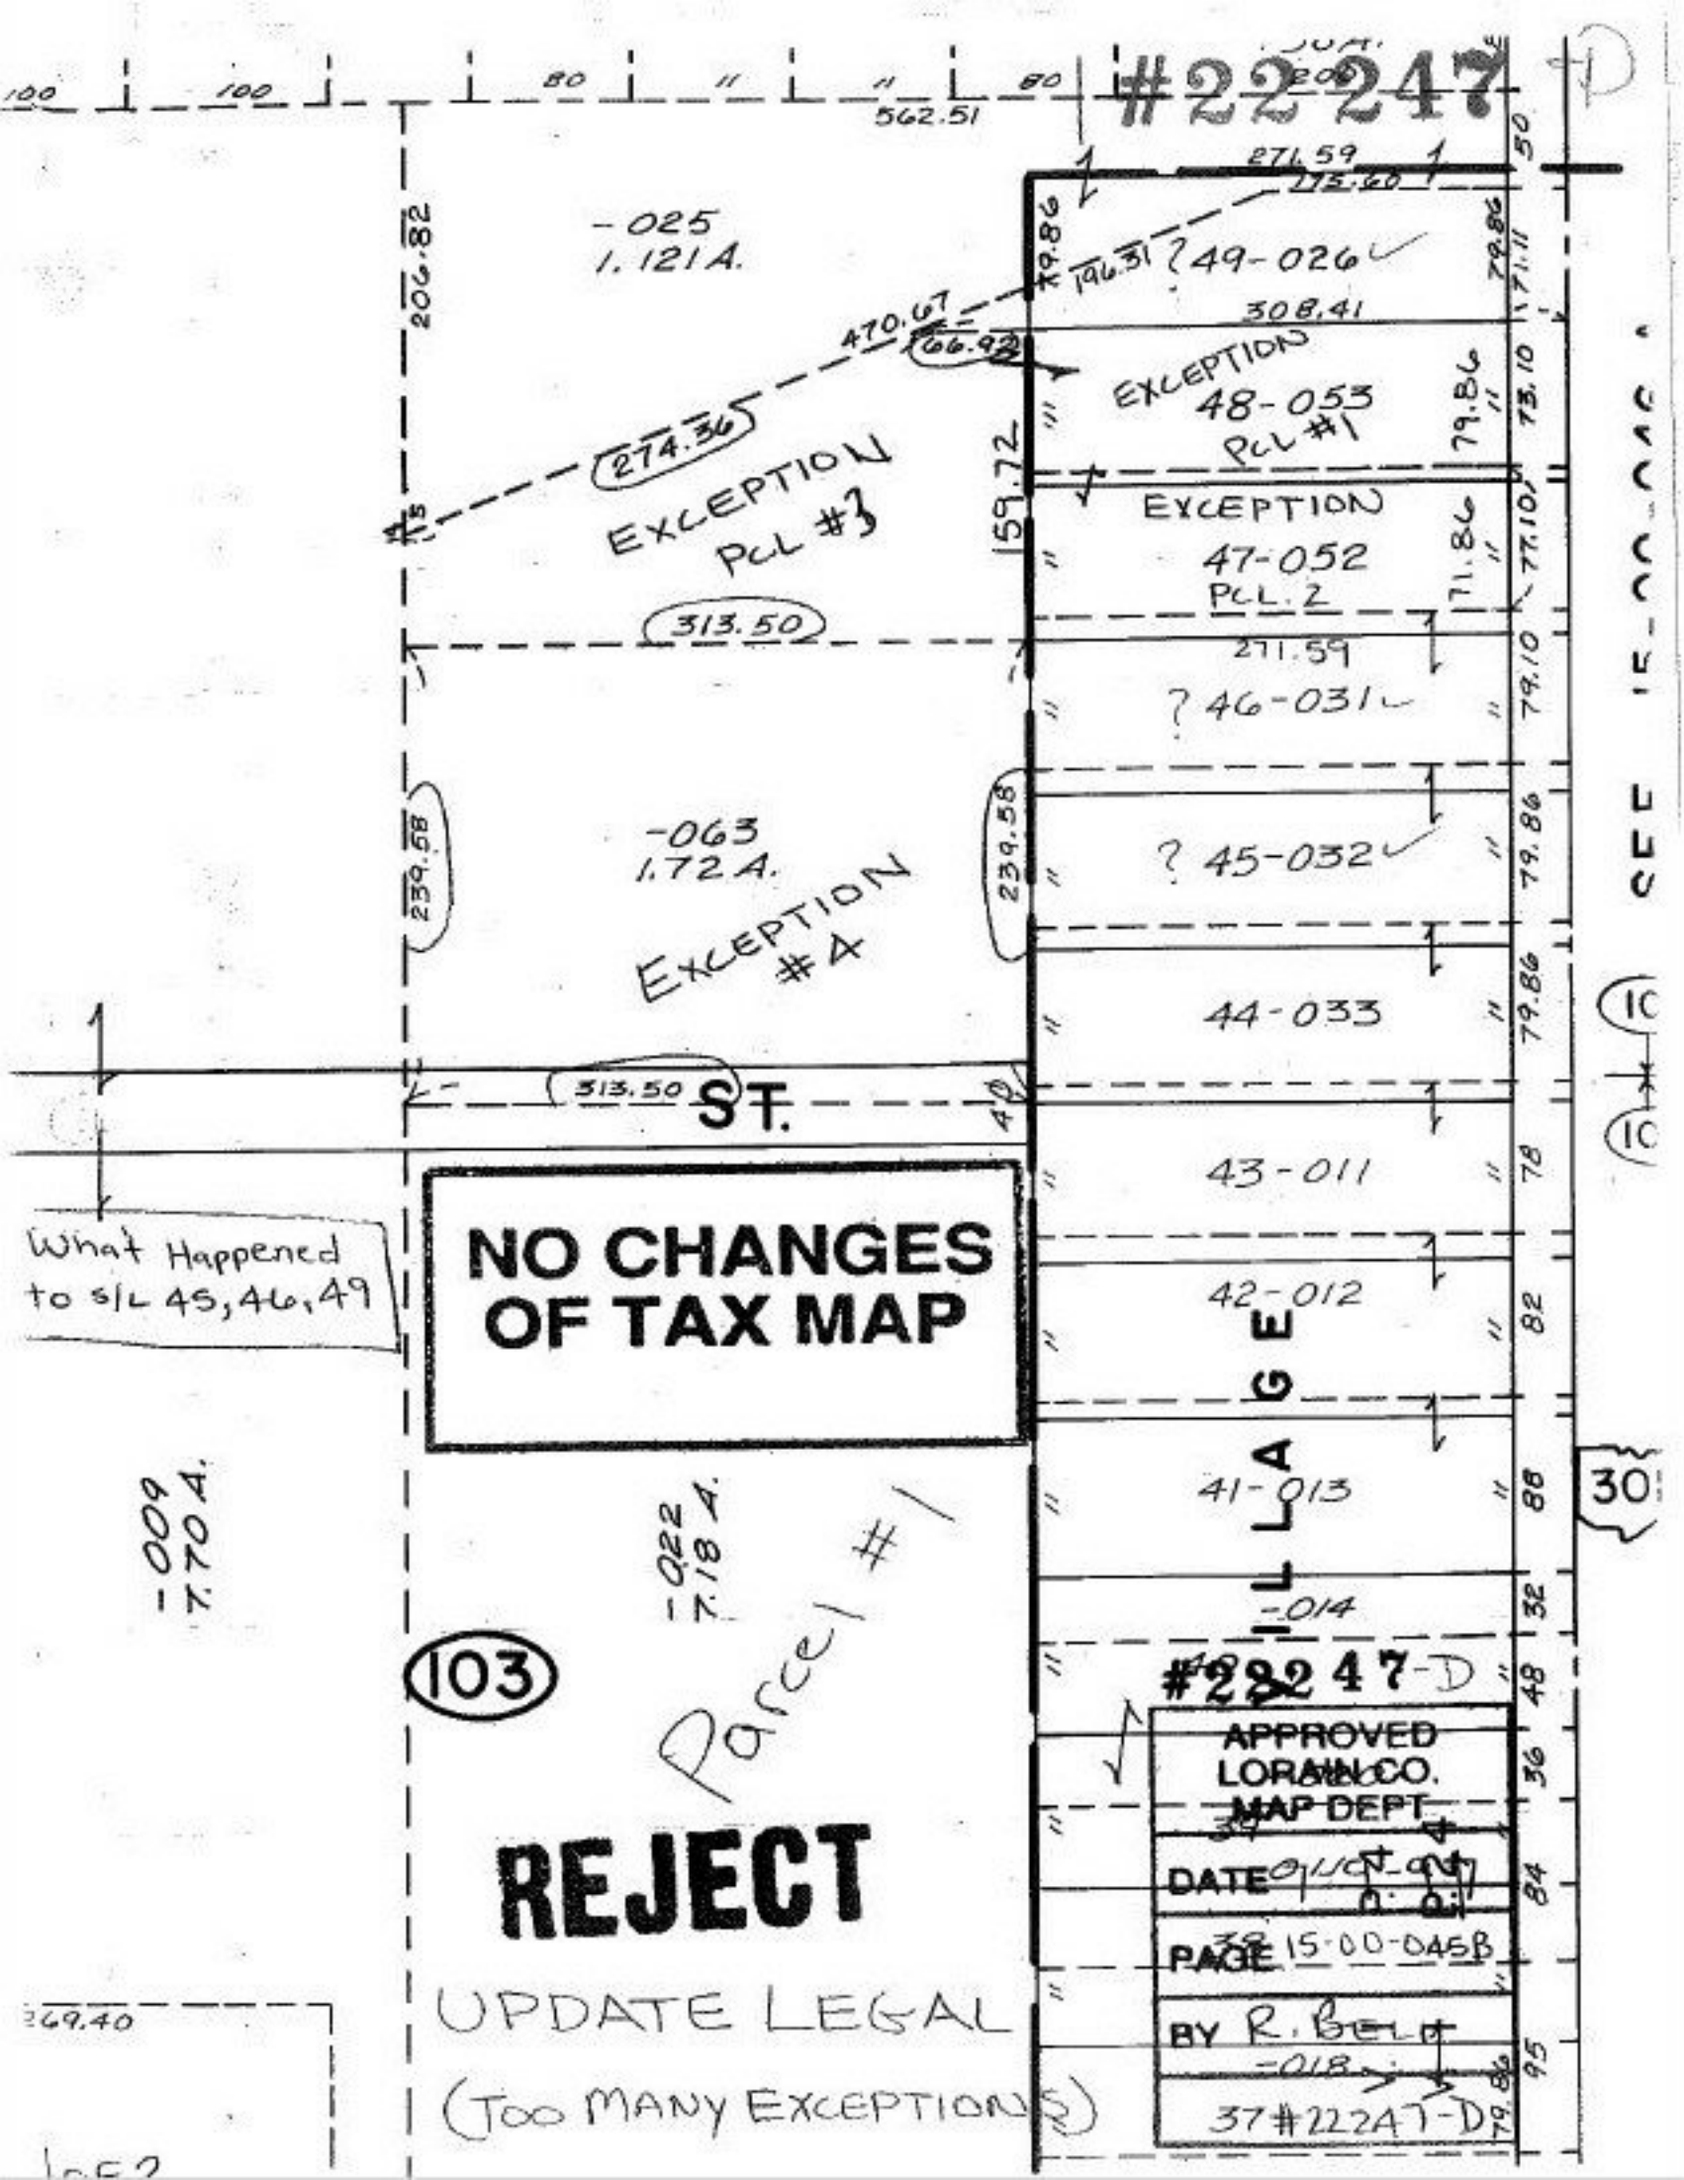
#22247
100
100
80
562.51
80
206.82
-025
1.121A.
470.67
166.92
274.36
EXCEPTION
PCL #3
313.50
239.58
-063
1.72A.
EXCEPTION
#4
313.50
ST.
What Happened
to s/L 45,46,49
NO CHANGES
OF TAX MAP
-009
7.70A.
-022
7.18A.
Parcel #1
103
REJECT
UPDATE LEGAL
(TOO MANY EXCEPTIONS)
269.40
LOT 2
271.59
196.31
?49-026
308.41
EXCEPTION
48-053
PCL #1
159.72
EXCEPTION
47-052
PCL 2
271.59
?46-031
?45-032
44-033
43-011
42-012
41-013
-014
-018
79.86
73.10
77.10
71.86
79.10
79.86
79.86
78
82
88
32
48
36
84
95
79.86
ELLAGEE
#22247-D
APPROVED
LORAIN CO.
MAP DEPT.
DATE 9/10/97
PAGE 15-00-045B
BY R. BELT
37 #222A7-D
SEE 15-00-046
10
10
30