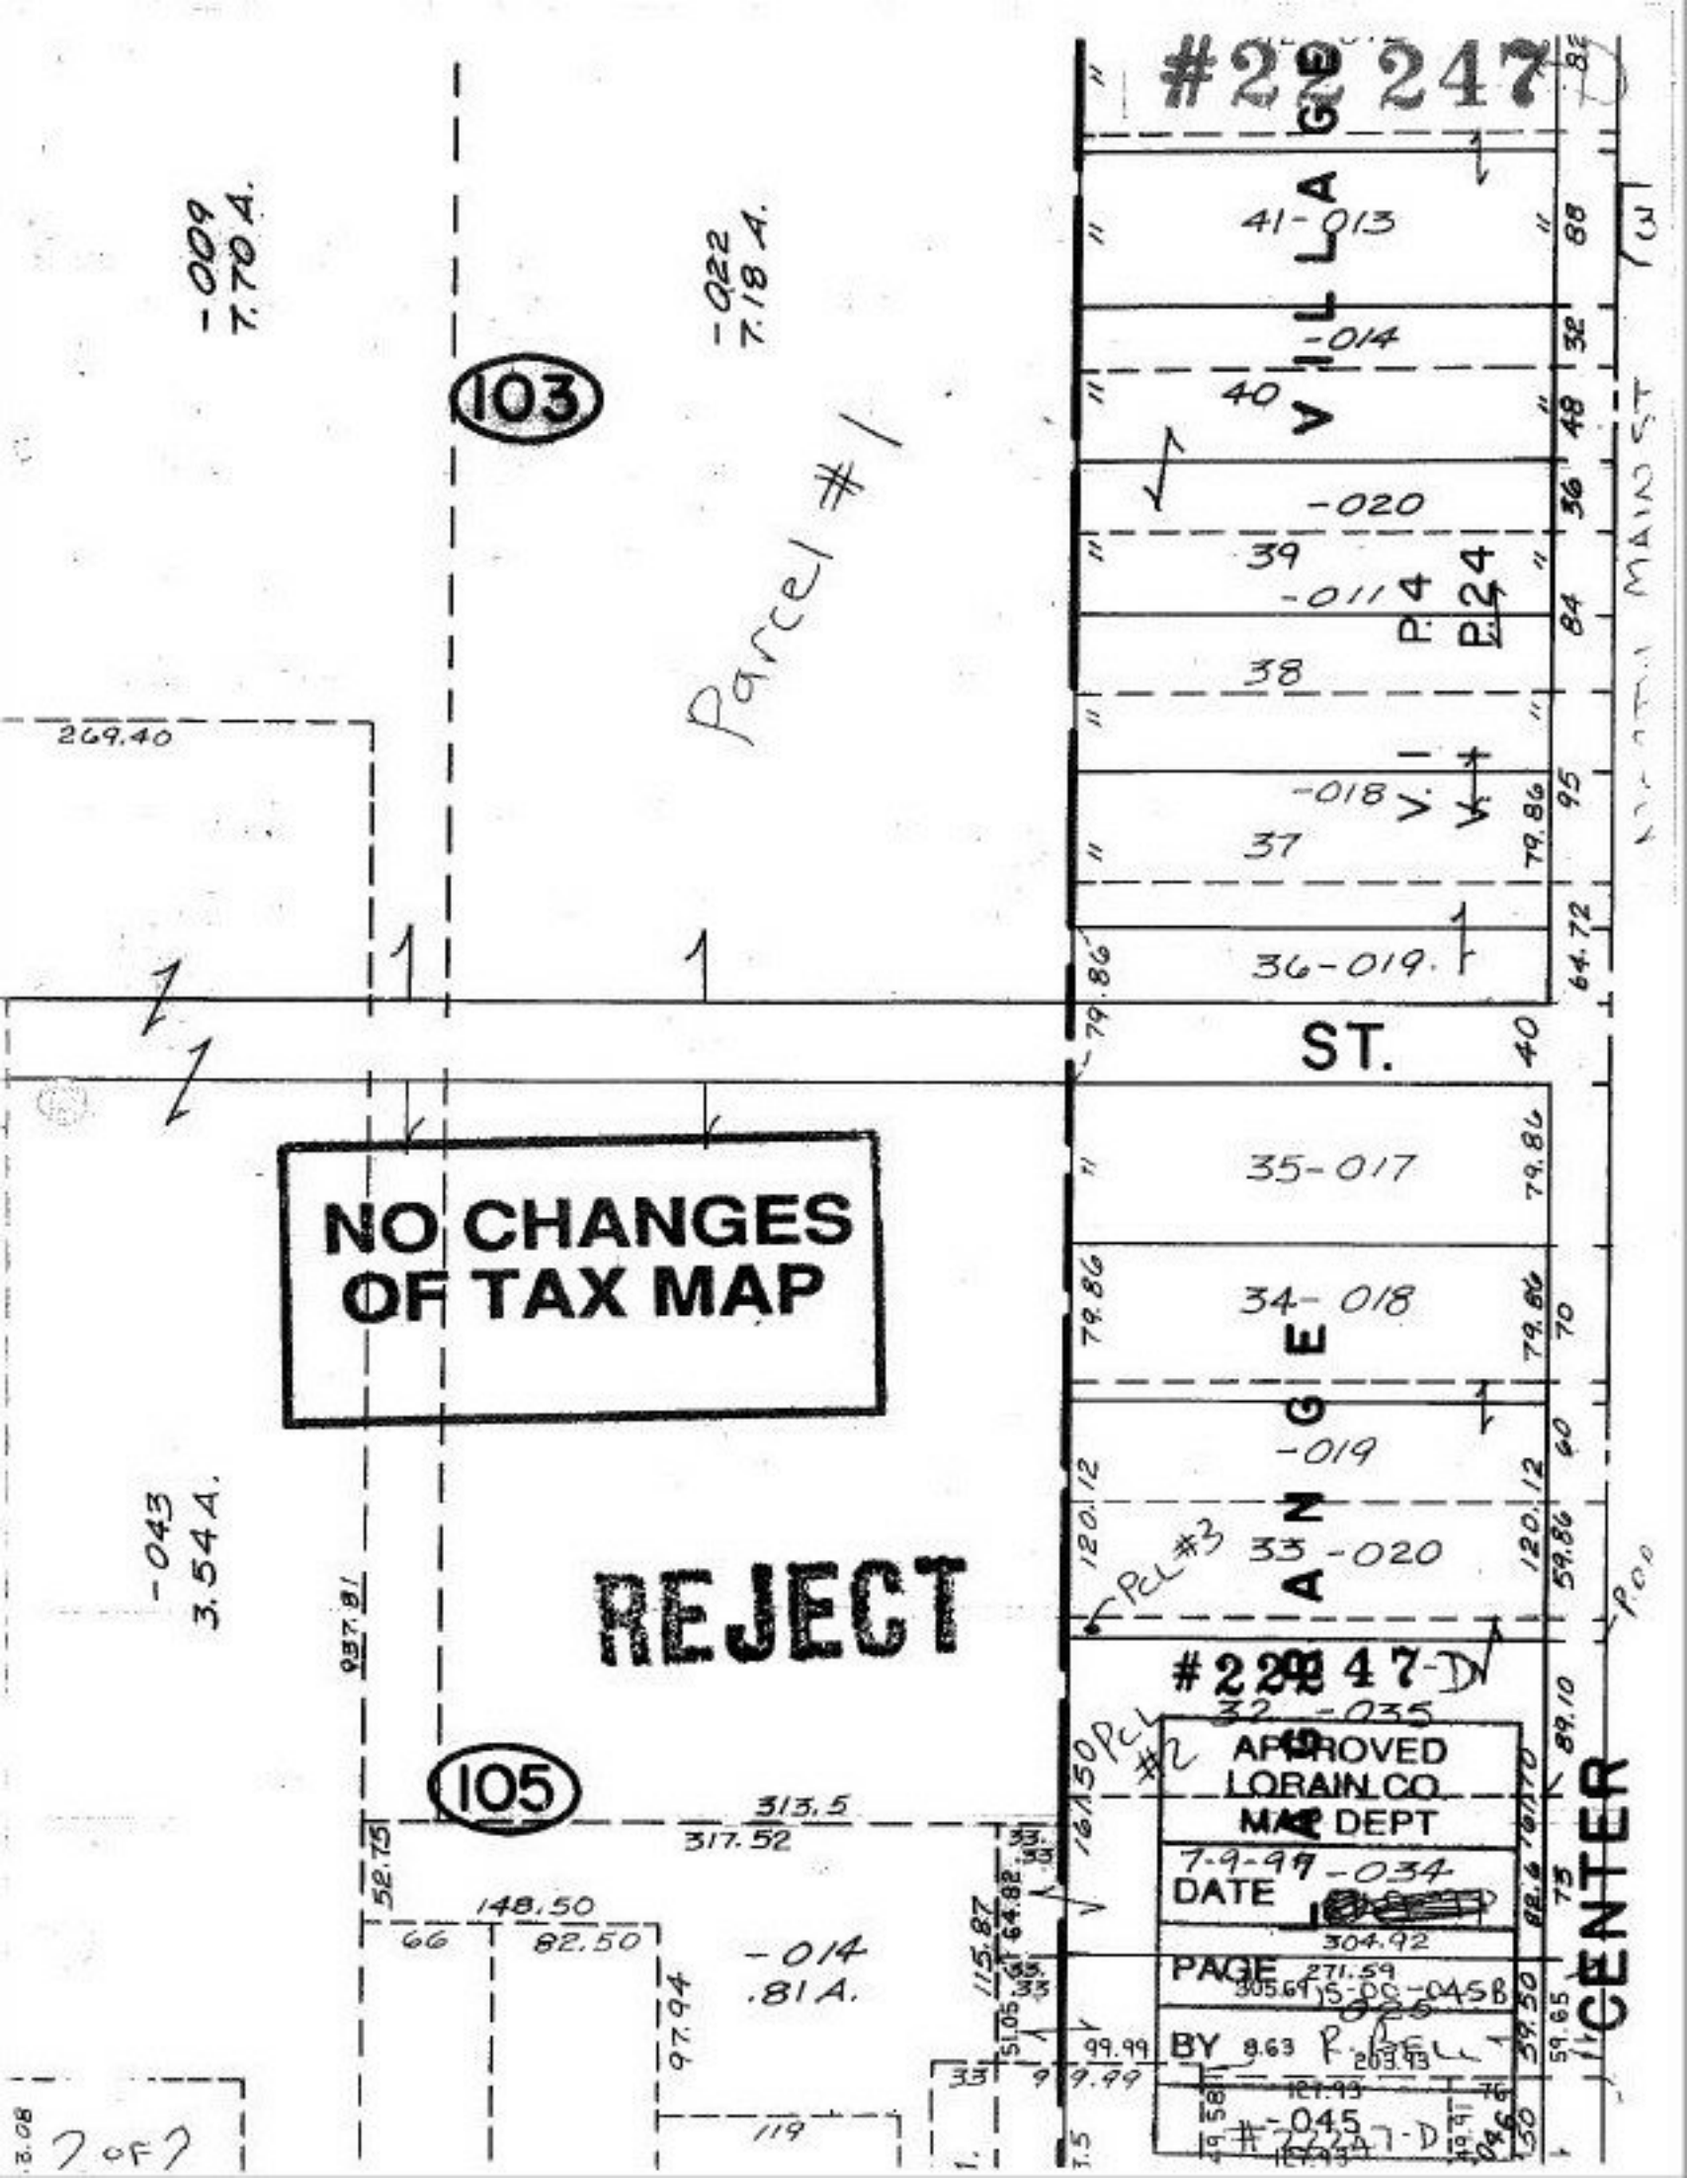
#22 247
VILLAGE
ST.
ANGE
CENTER
103
105
Parcel #1
-009
7.70 A.
-022
7.18 A.
-043
3.54 A.
-014
.81 A.
269.40
41-013
-014
40
-020
39
-011
38
-018
37
36-019
35-017
34-018
-019
33-020
32-035
-034
-045
P.4
P.24
V.1
PCL #3
PCL #2
NO CHANGES OF TAX MAP
REJECT
APPROVED
LORAIN CO
MAP DEPT
DATE 7-9-99
PAGE
BY
313.5
317.52
148.50
82.50
66
97.94
119
115.87
64.82
99.99
203.93
304.92
271.59
305.69
79.86
120.12
59.86
89.10
64.72
95
84
36
48
32
88
40
70
60
73
59.65
59.50
82.6
161.70
161.50
33
7 of 7