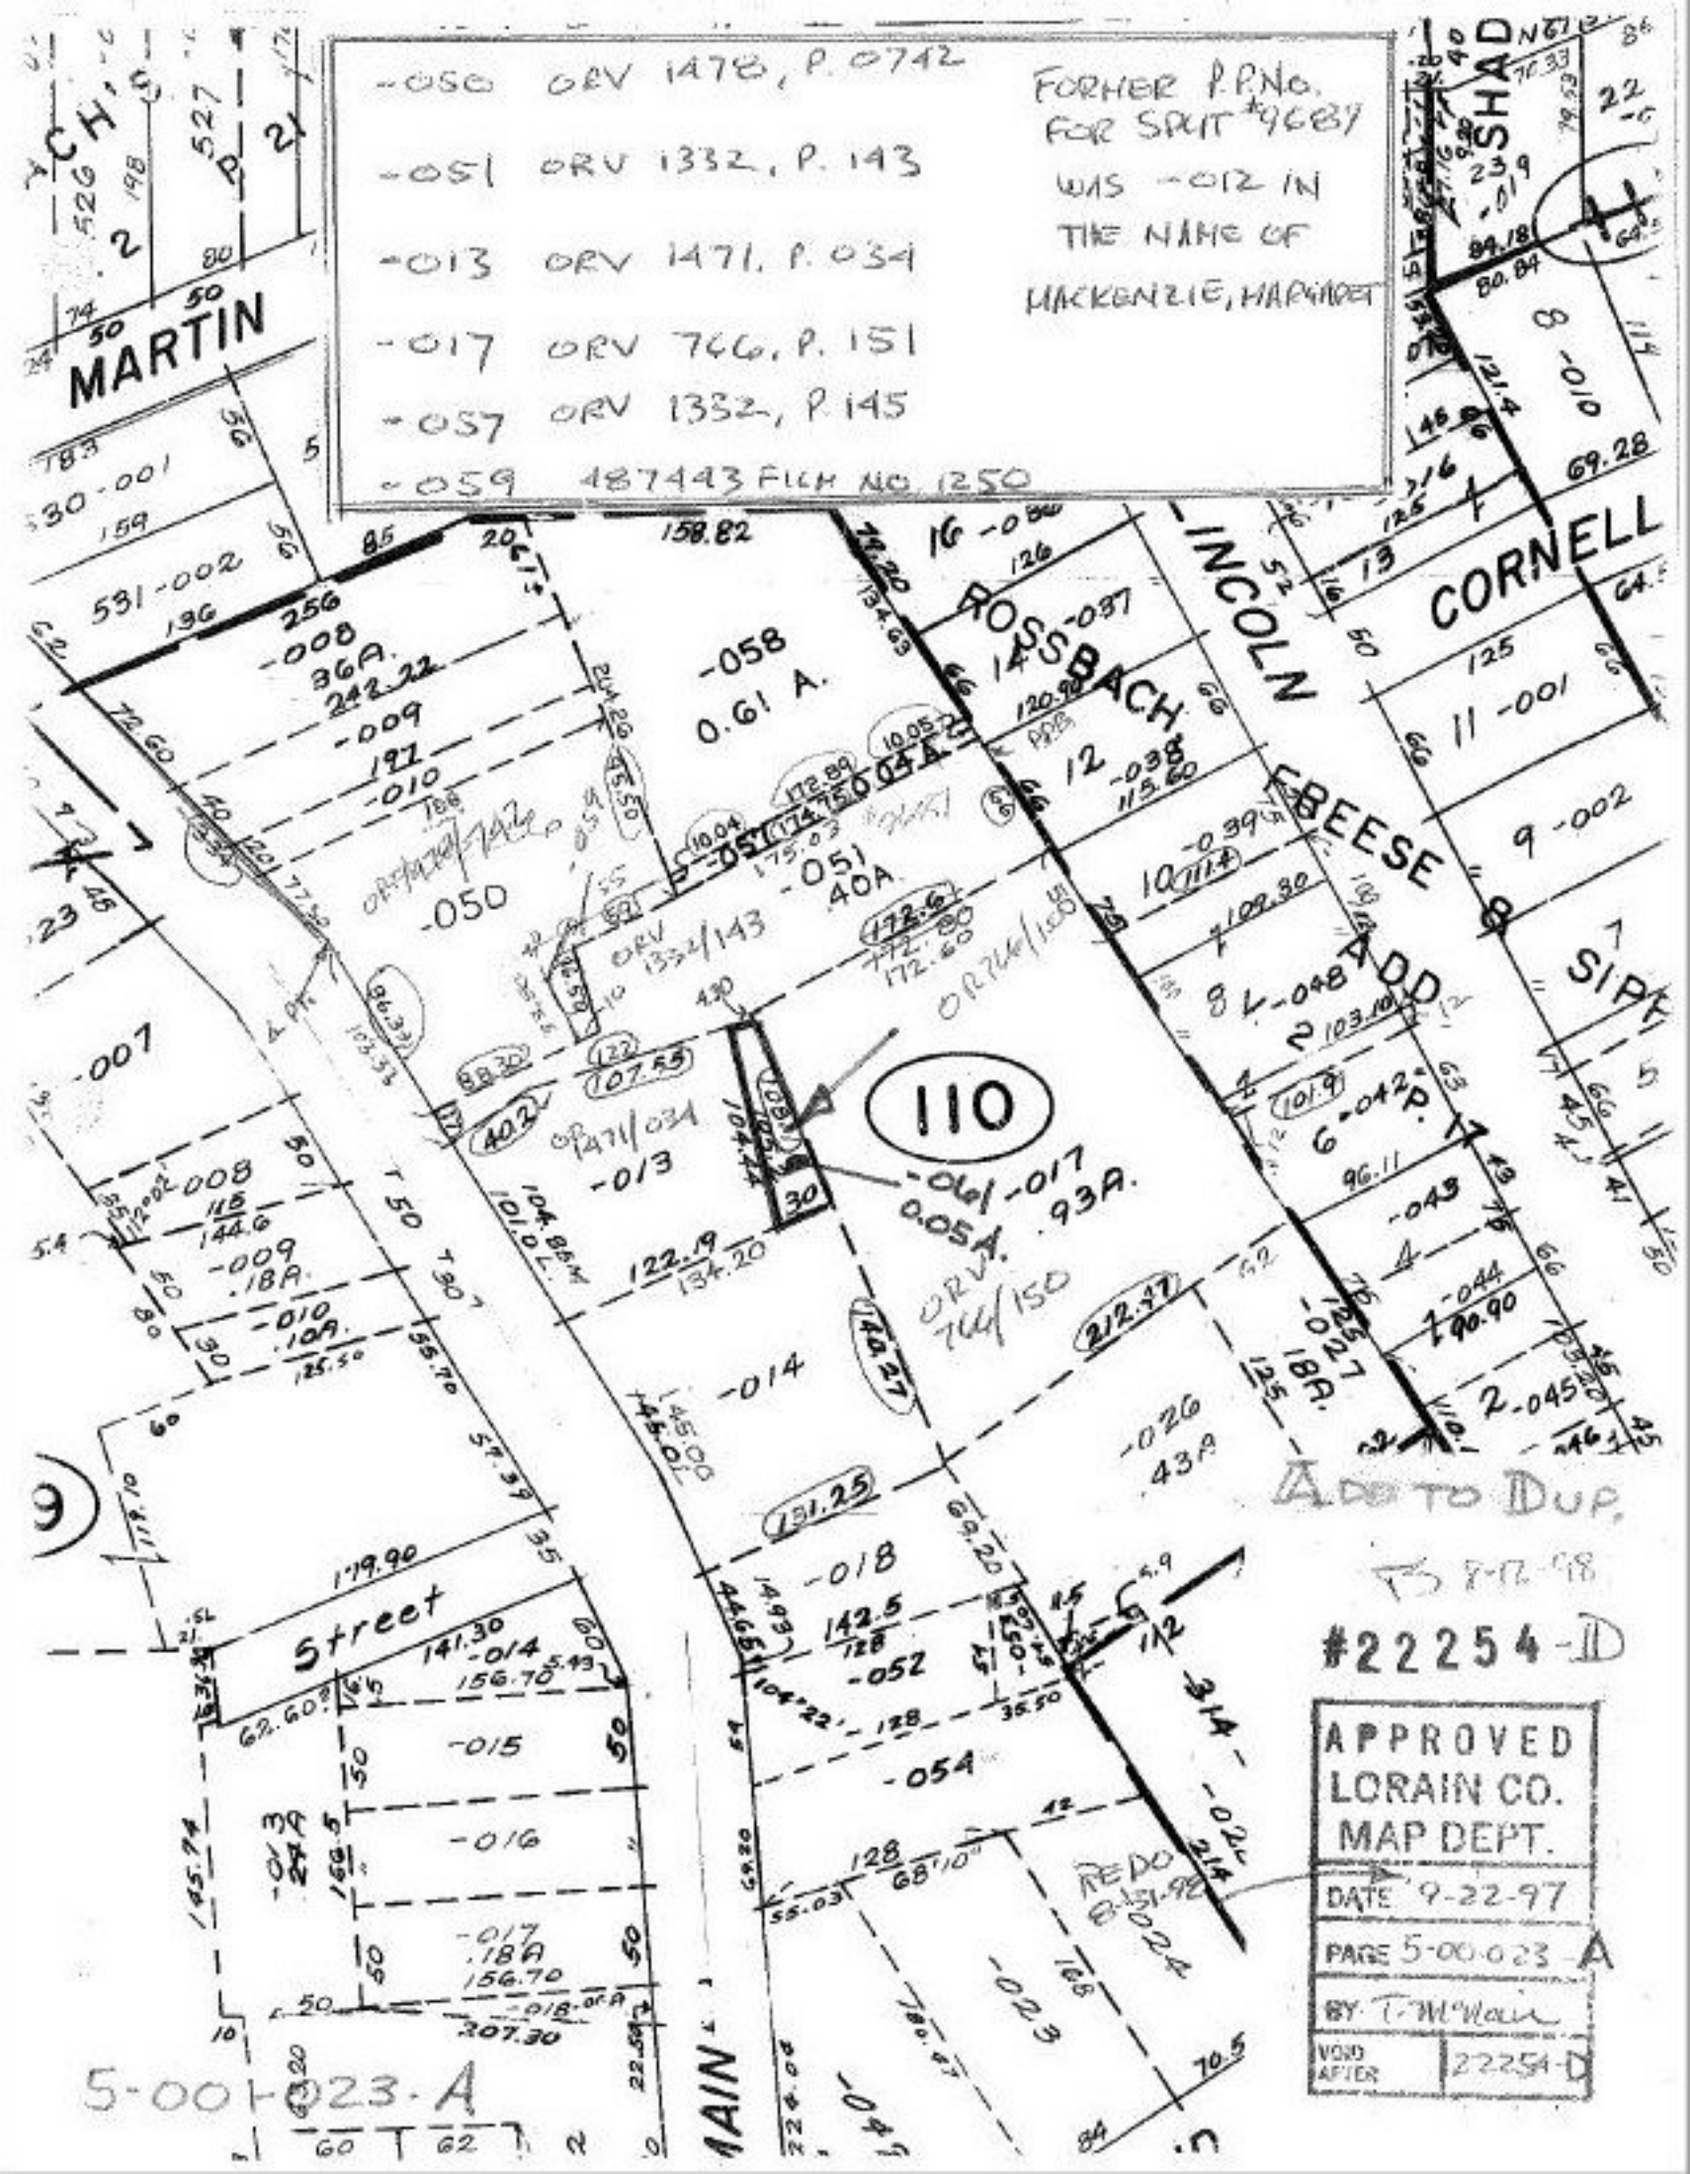
-050 ORV 1478, P. 0742
-051 ORV 1332, P. 143
-013 ORV 1471, P. 034
-017 ORV 766, P. 151
-057 ORV 1332, P. 145
-059 487443 FILM NO. 1250
FORMER P.P.No. FOR SPLIT #9687 WAS -012 IN THE NAME OF MACKENZIE, MARGARET
MARTIN
ROSSBACH
LINCOLN
FREESE
ADD
CORNELL
SHAD
Street
MAIN
110
ADD TO DUP.
#22254-D
APPROVED LORAIN CO. MAP DEPT.
DATE 9-22-97
PAGE 5-00-023-A
BY T. McNair
VOID AFTER 22254-D
5-001-023-A