#22256

(-080) 58.26A
(-011) 1.48A
(-018) 21.97A

Combo. - 81.71A

(150)

~~-080~~
~~58.26A~~

-081
81.71A
(Combo)

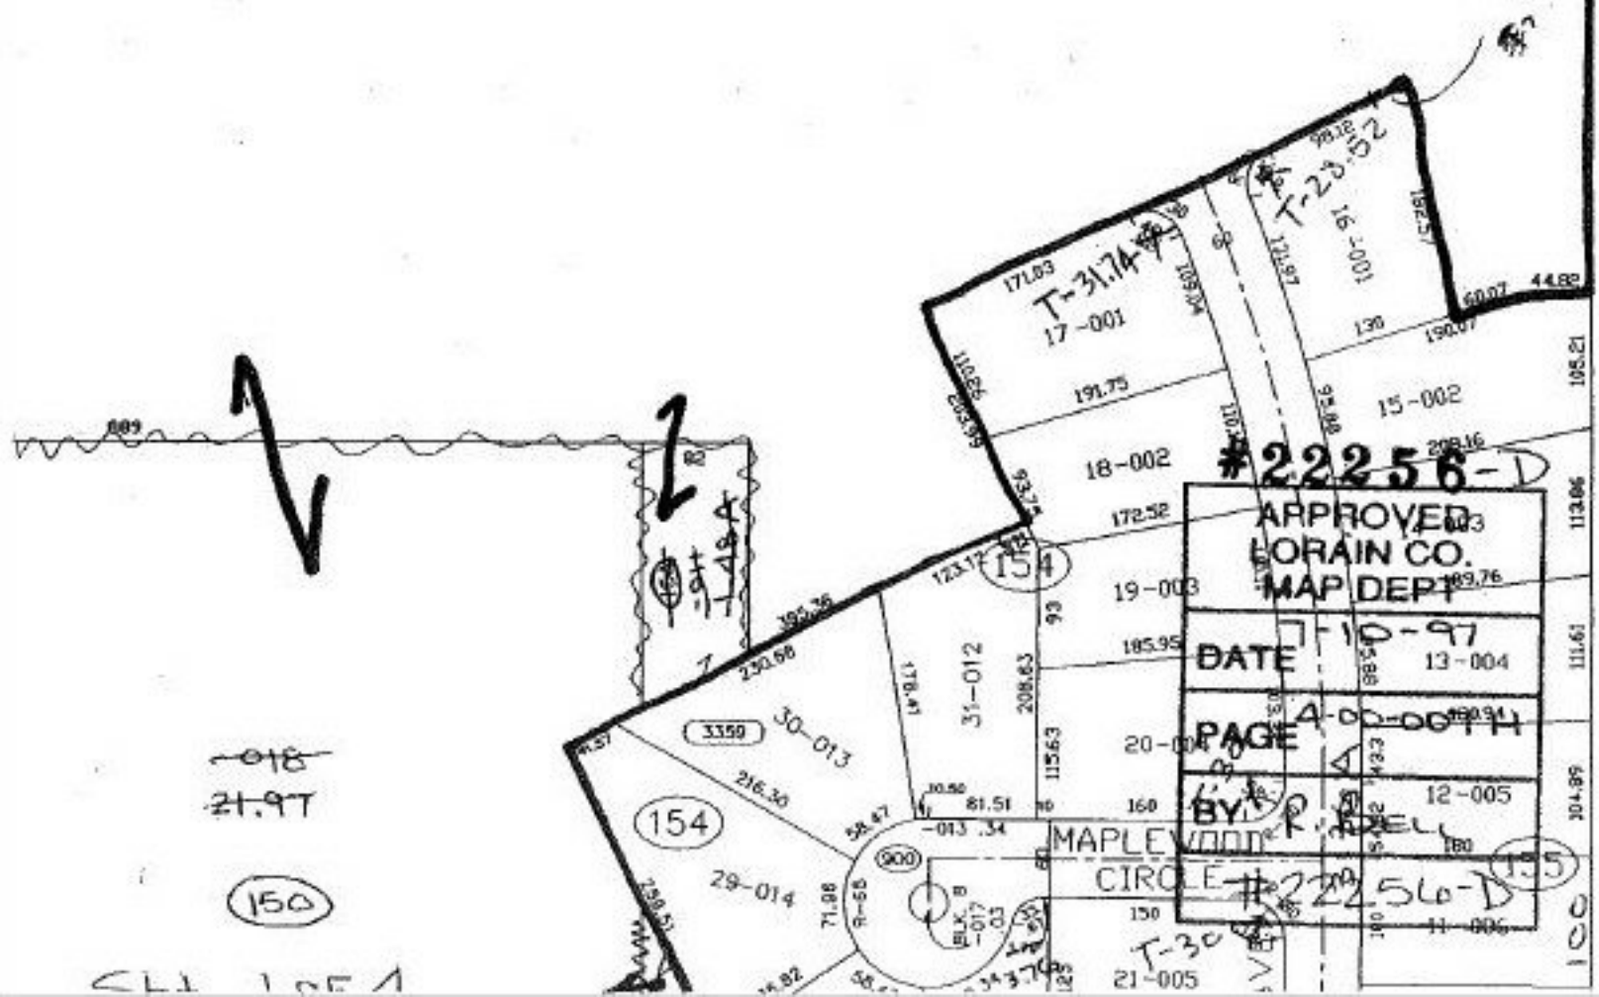

~~-018~~
~~21.97~~

(150)