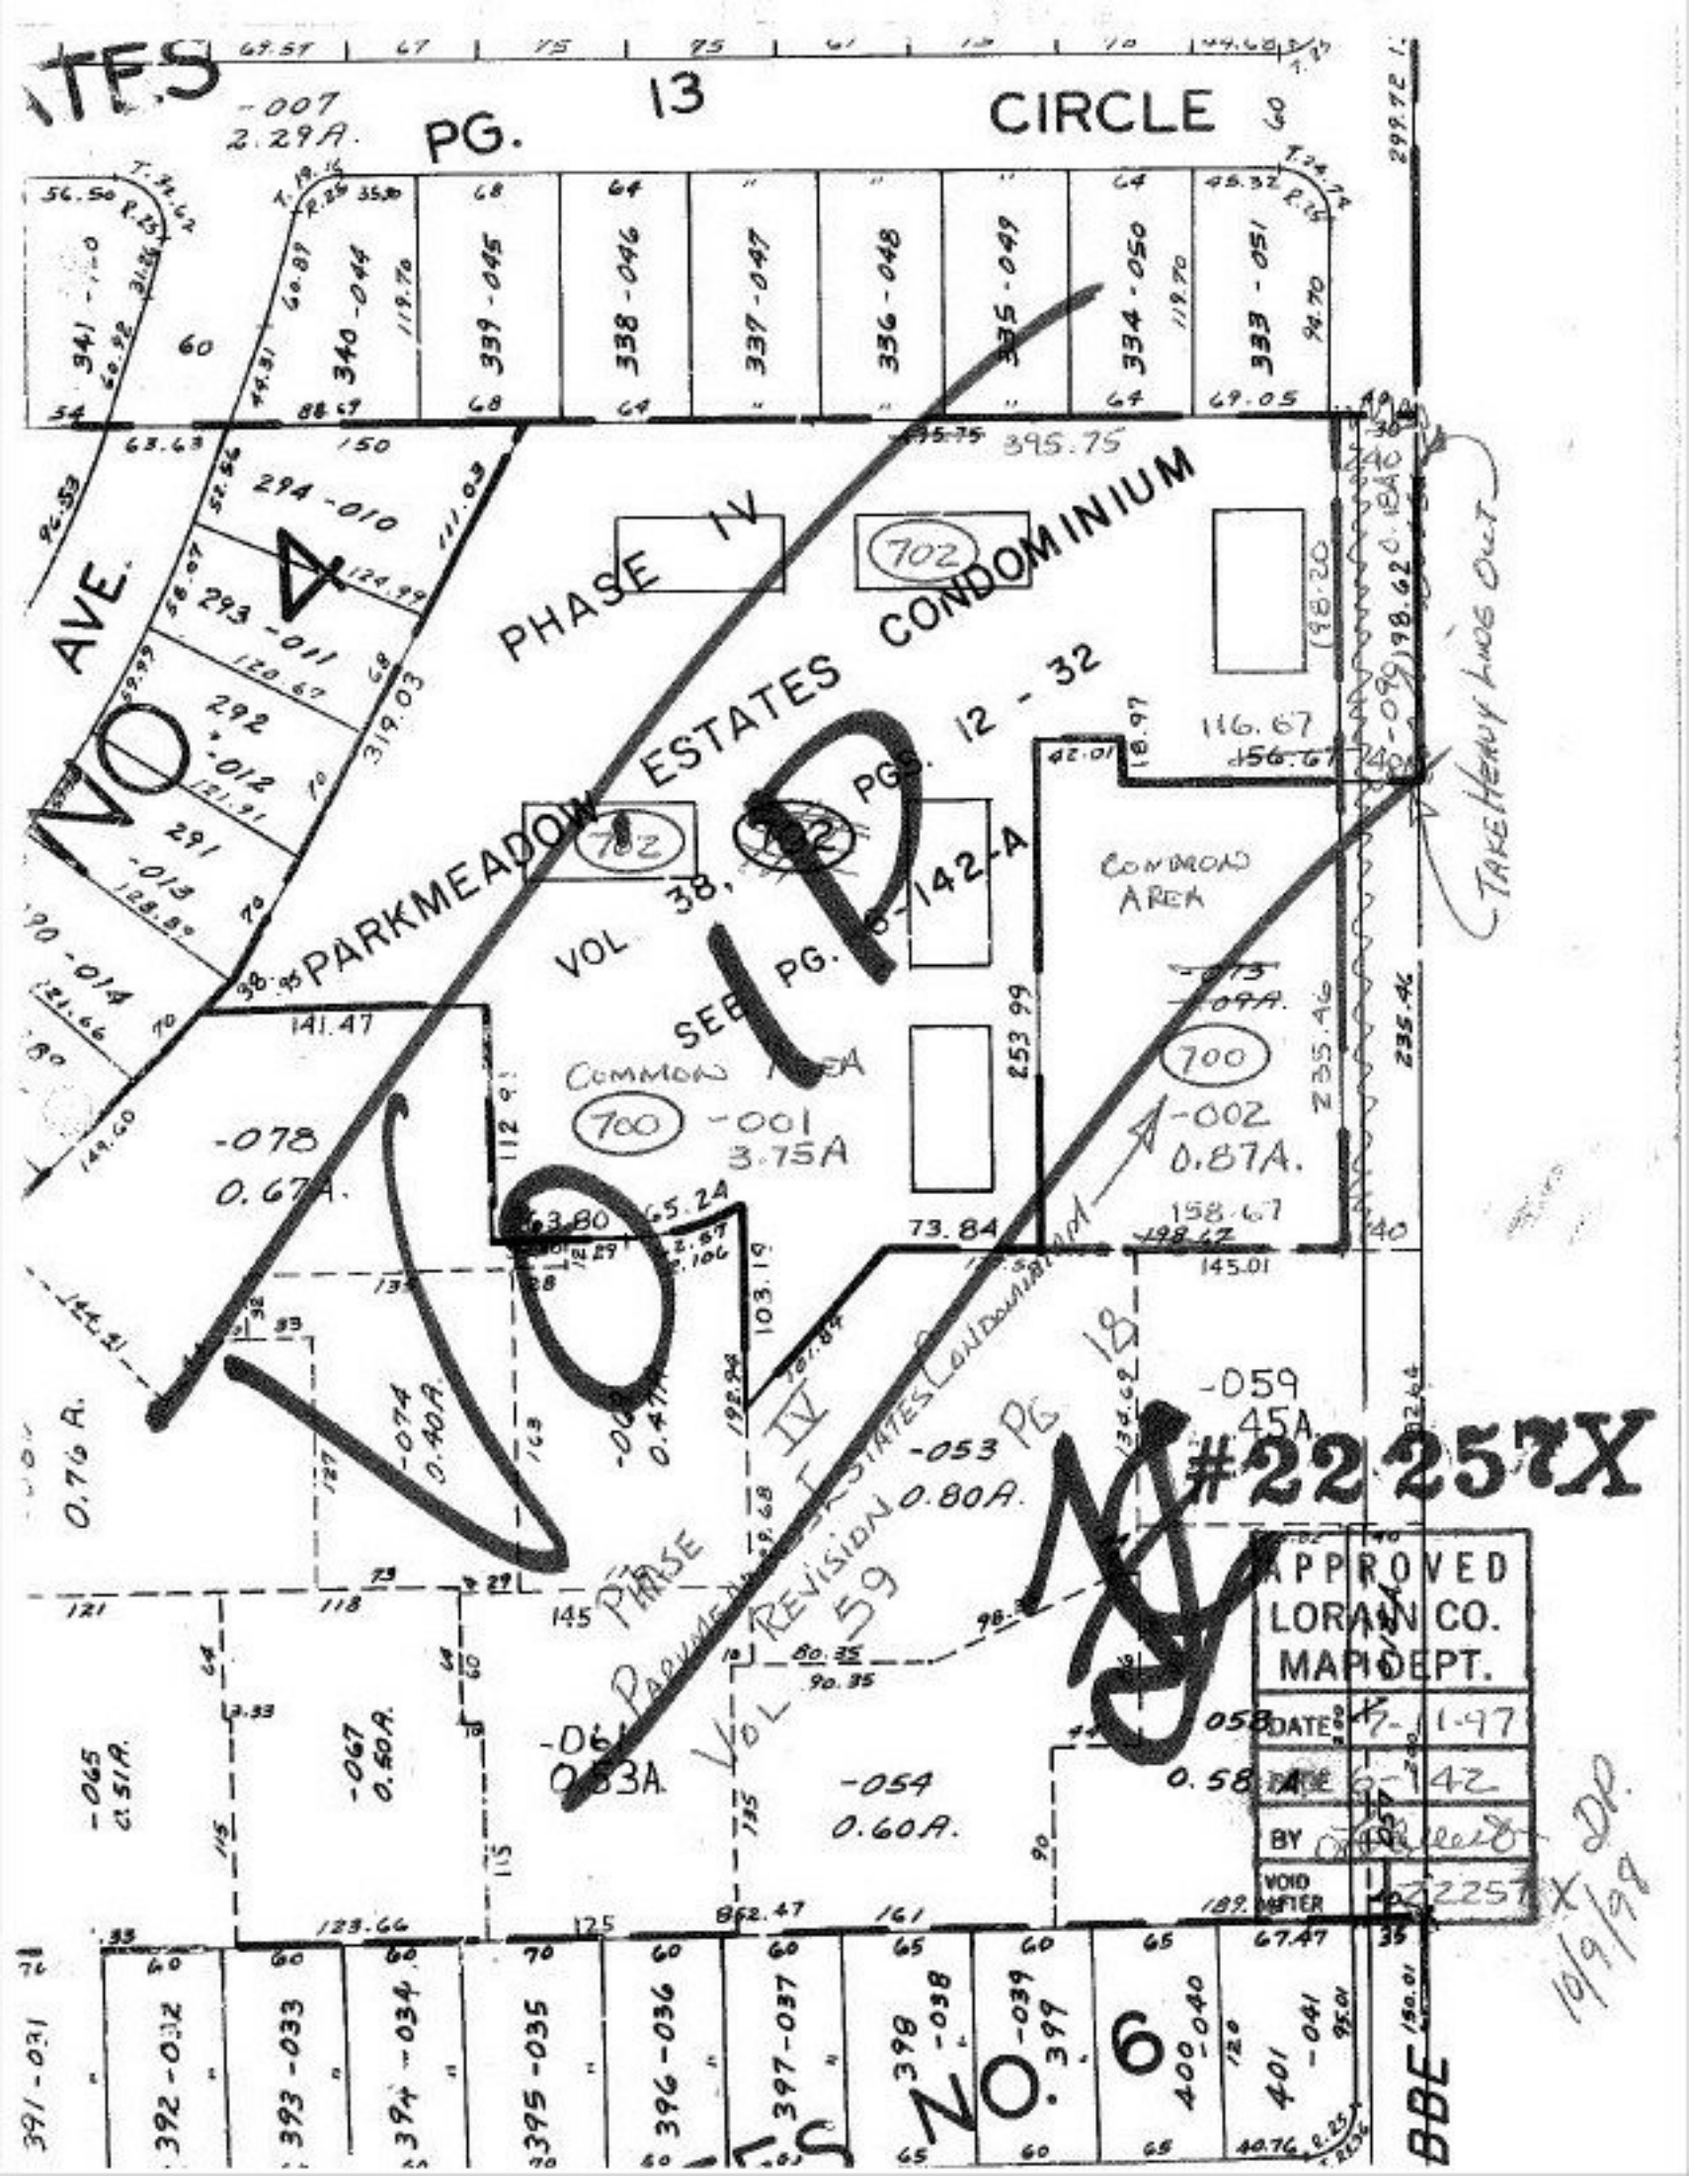

PG. 13
CIRCLE
PHASE IV
PARKMEADOW ESTATES CONDOMINIUM
VOL 38, PGS. 12 - 32
SEE PG. 6-142-A
COMMON AREA
COMMON AREA
TAKE HEAVY LINDS OUT
PHASE IV
PARKMEADOW ESTATES CONDOMINIUM
REVISION
VOL 59
PG 18
#22257X
APPROVED
LORAIN CO.
MAP DEPT.
DATE 7-11-97
PAGE 6-142
BY
VOID AFTER
10/9/98
NO. 6