#22260

NO. 22260

PARENT PARCEL: 12-00-062-000-003

CHILD PARCEL: 12-00-062-000-073, -074, -075

STARTING POINT: cL of Osborne Rd. & cl of Jaquay Rd.

~~-003~~

~~13.00 A.~~

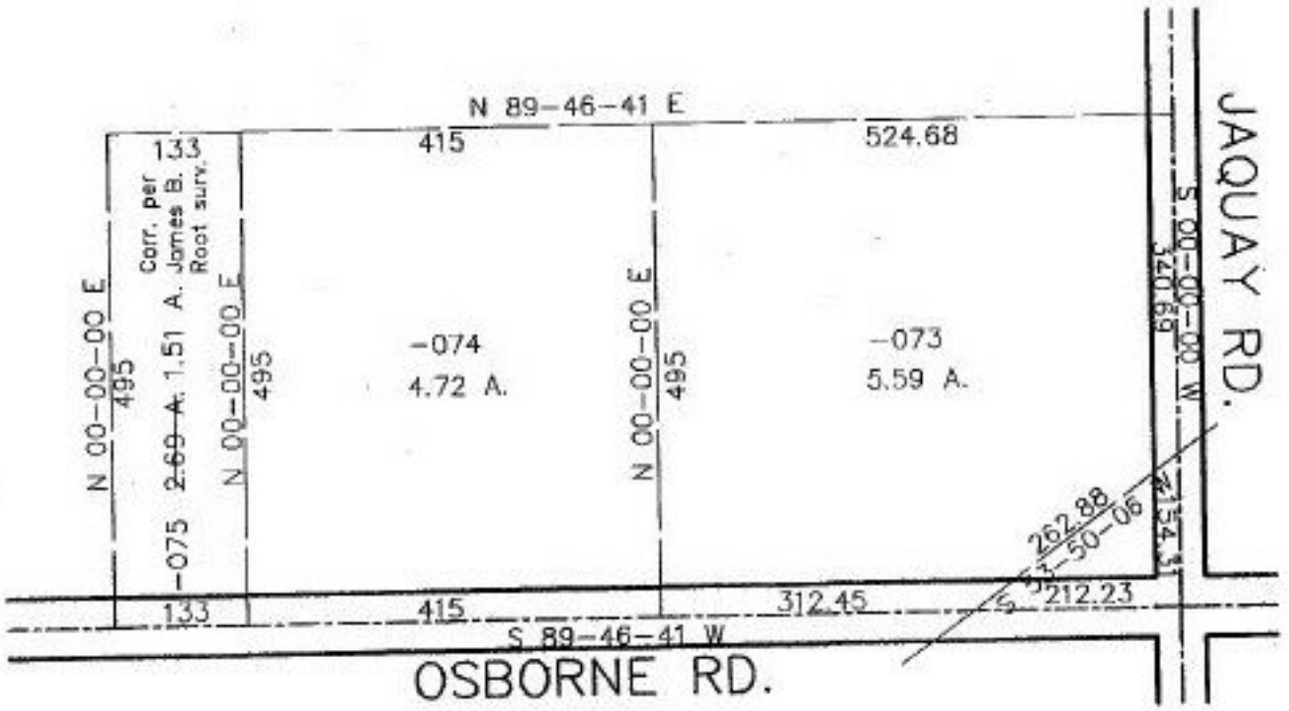

SPLITS/DEEDS PROCESSED

LORAIN COUNTY TAX MAP DEPARTMENT

226 MIDDLE AVE. ELYRIA, OHIO

SURVEYED BY: James B. Root

CLOSURE: 0.00 per 10,000

MAP PAGE(S): **12-00-062-B**

APPROVED BY: kac DATE: 8/14/97

SCALE: 1"= 200 PRIOR INSTRUMENT: 925/136