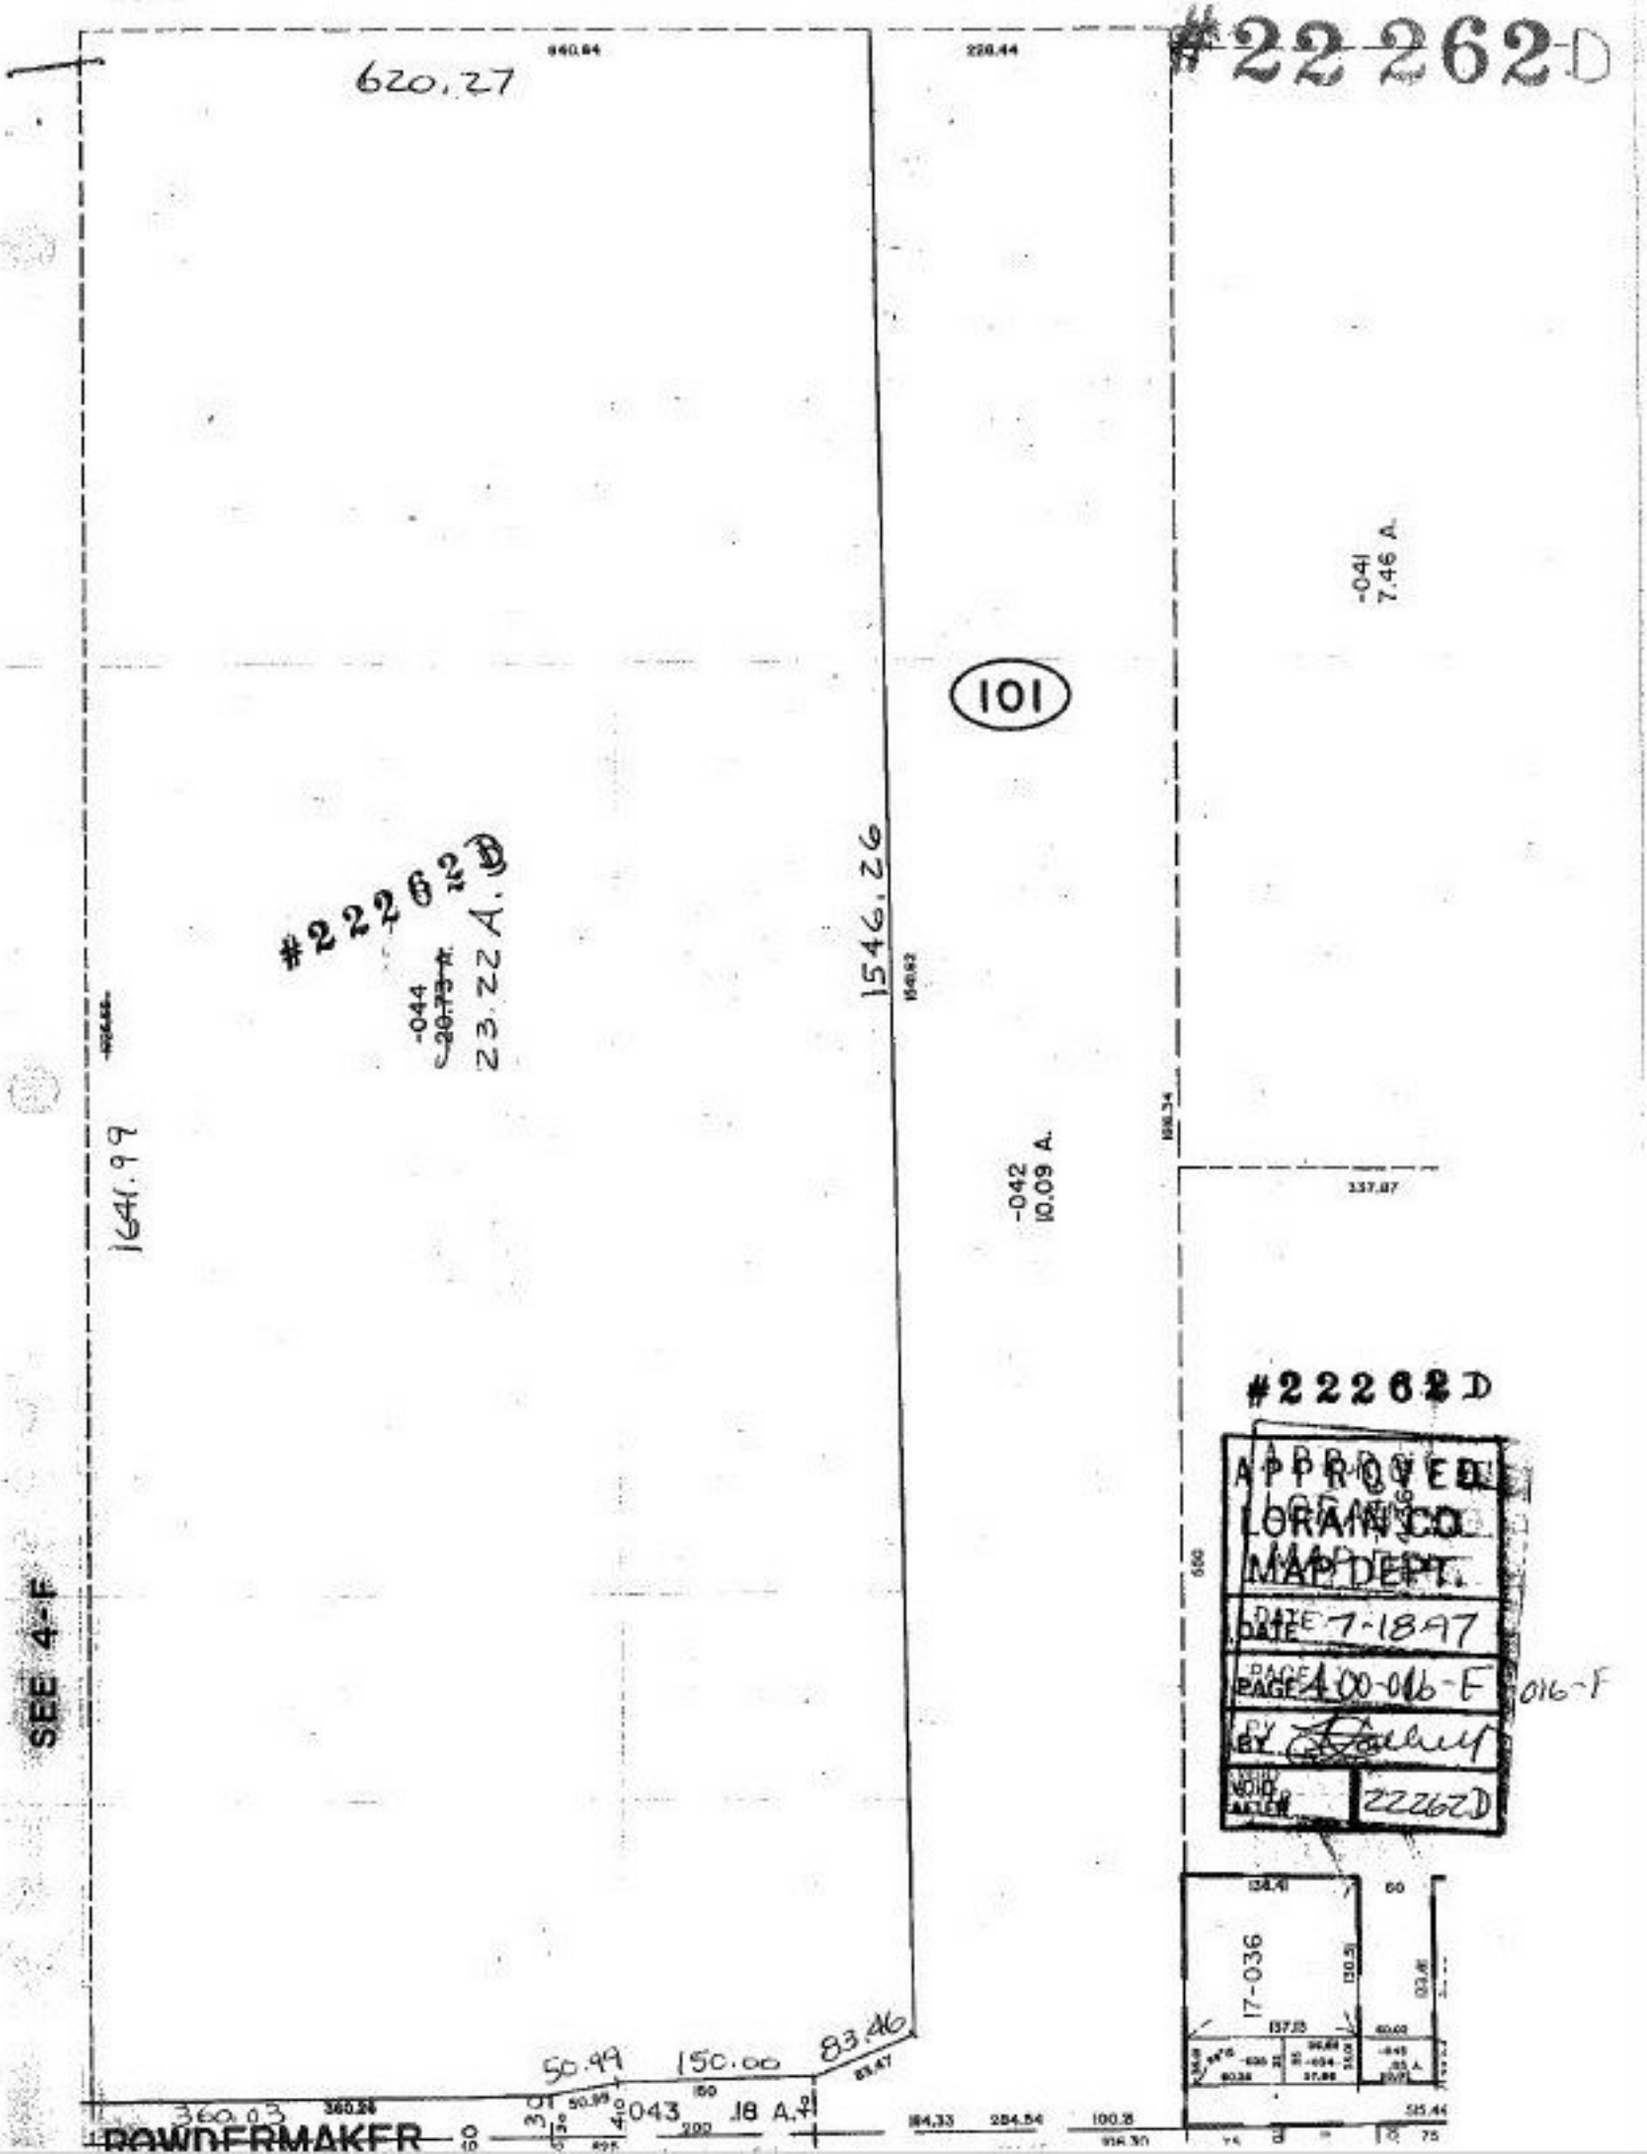

#22262D
620.27
101
-041
7.46 A.
1546.26
#22262D
-044
23.22 A.
1641.99
-042
10.09 A.
#22262D
APPROVED
LORAIN CO.
MAP DEPT.
DATE 7-18-97
PAGE 4 00-016-F
016-F
BY
VOID AFTER
22262D
17-036
SEE 4-F
50.99
150.00
83.46
360.03
.043
.18 A.
ROWDERMAKER