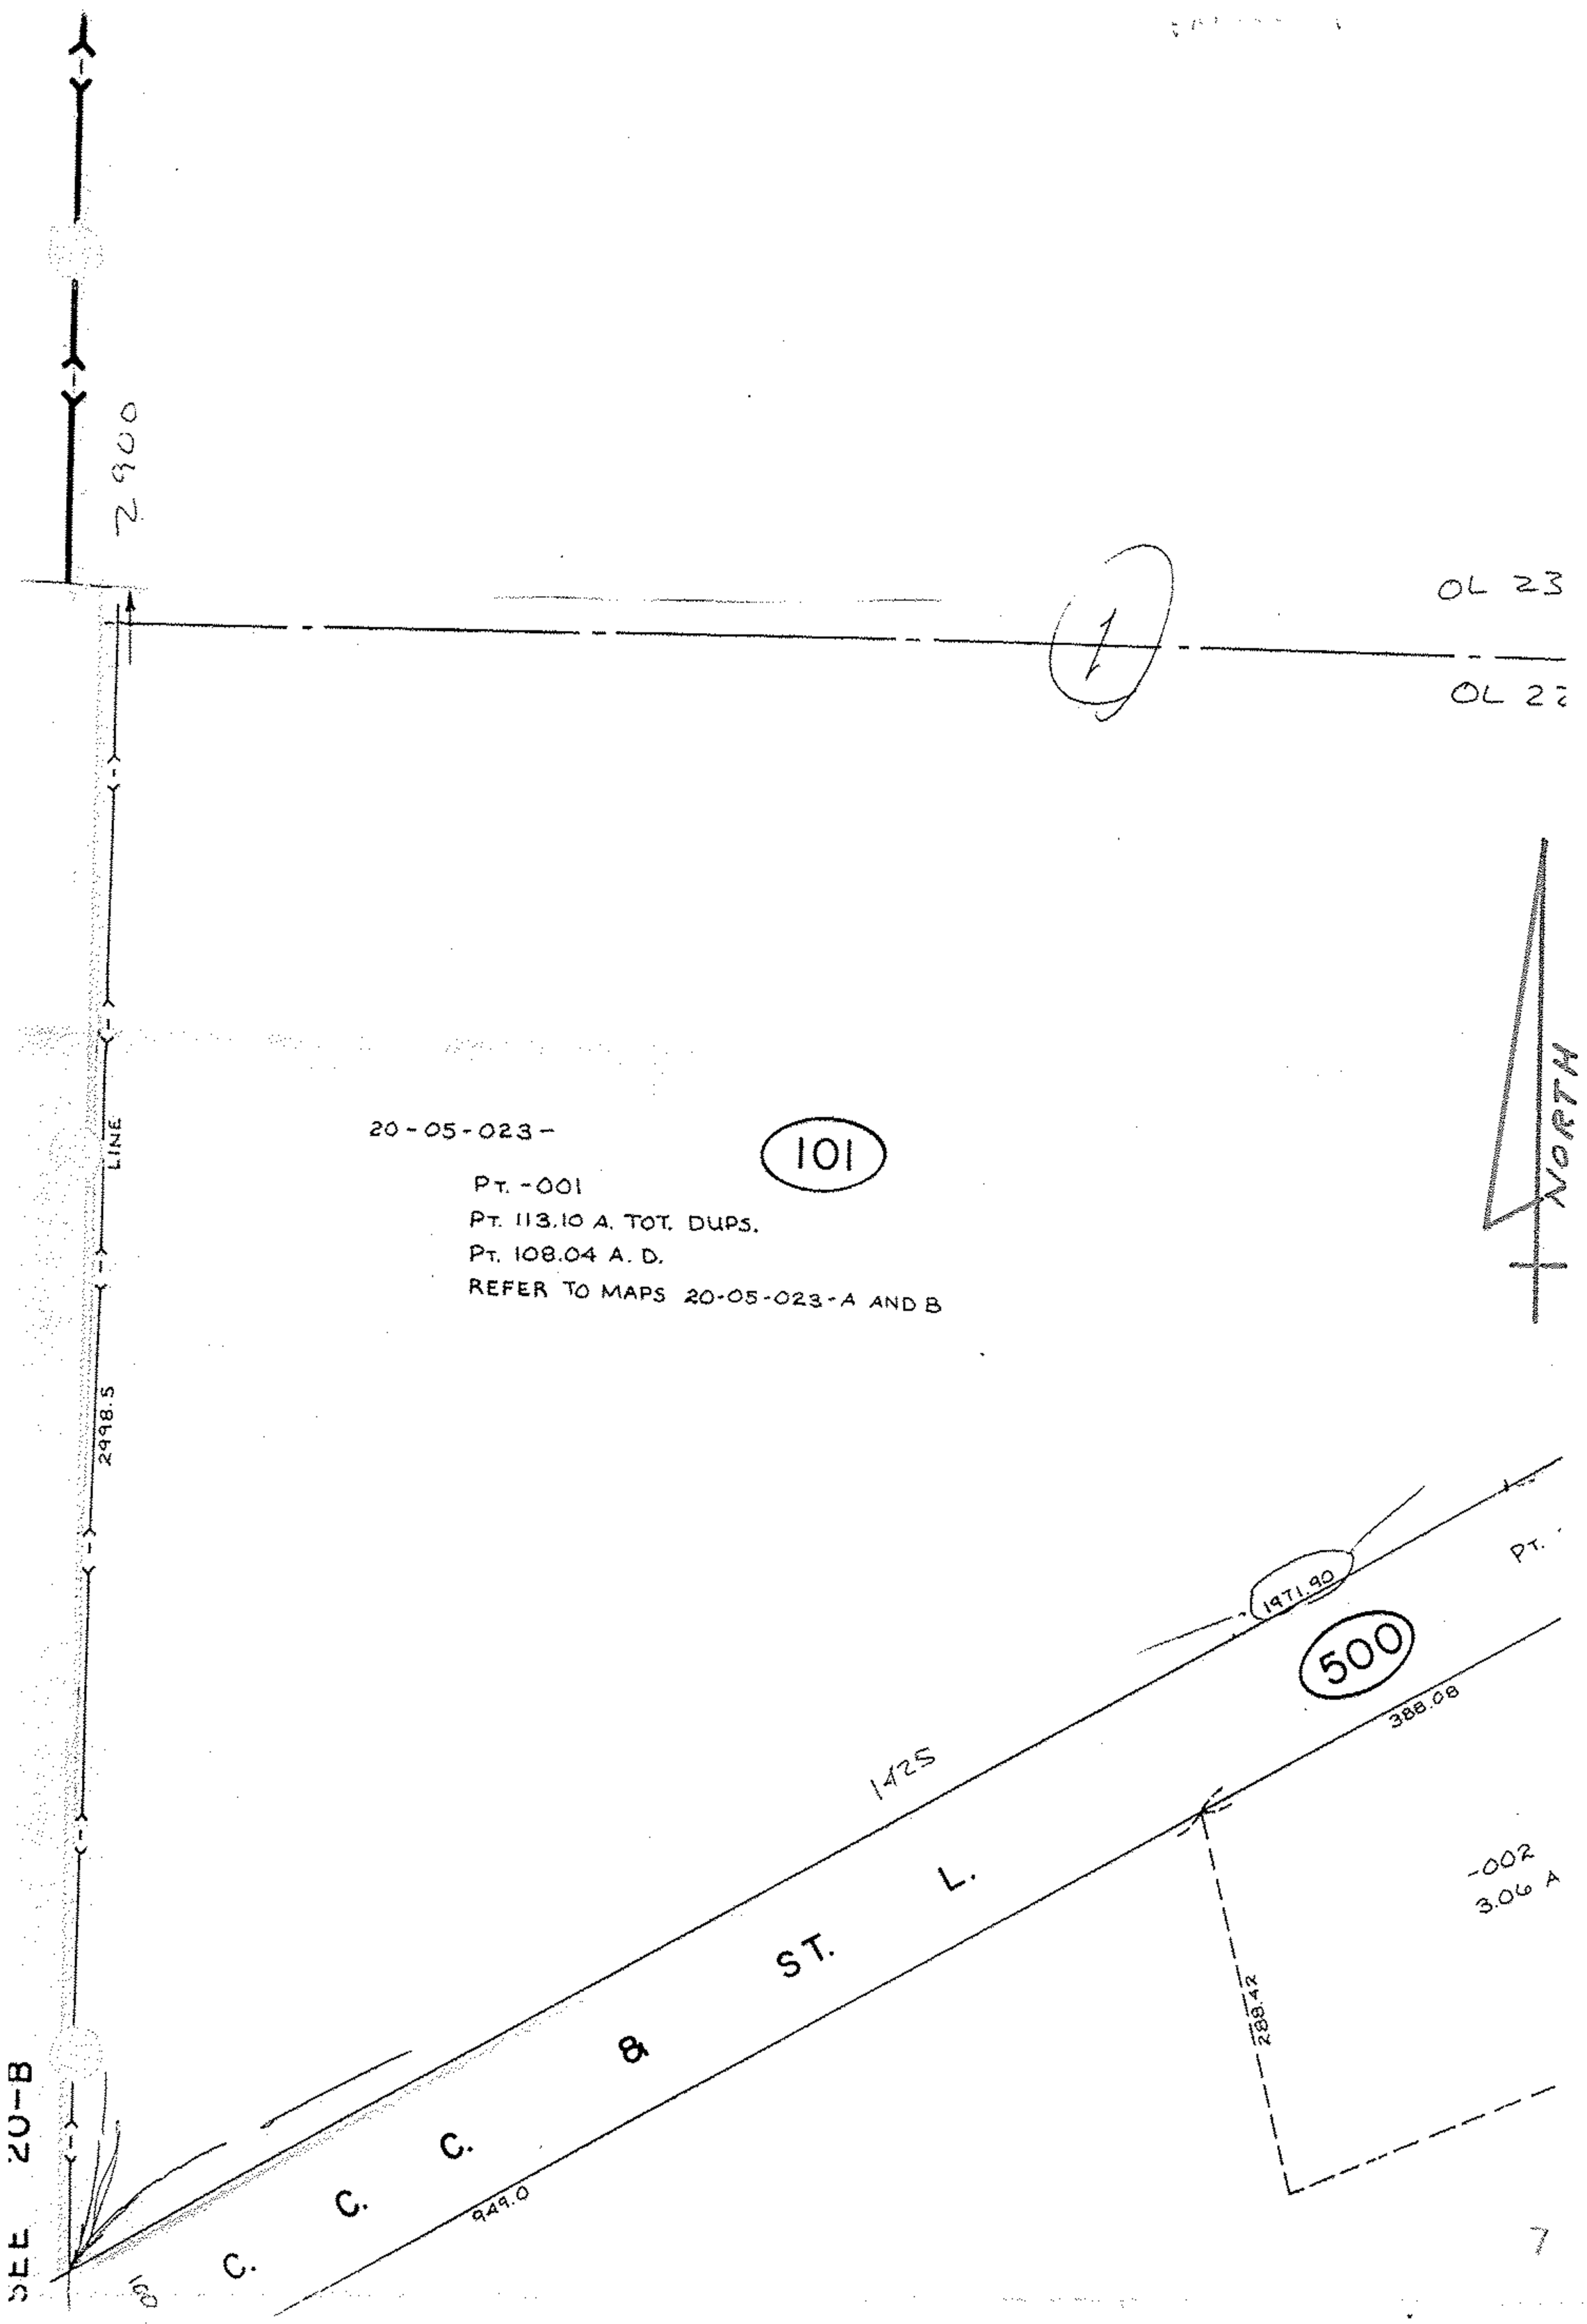

#22266-D

APPROVED
LORAIN CO.
MAP DEPT.
DATE 7-29-98
PAGE 20-05-022-A
BY T. McNair
VOID AFTER 22266-D