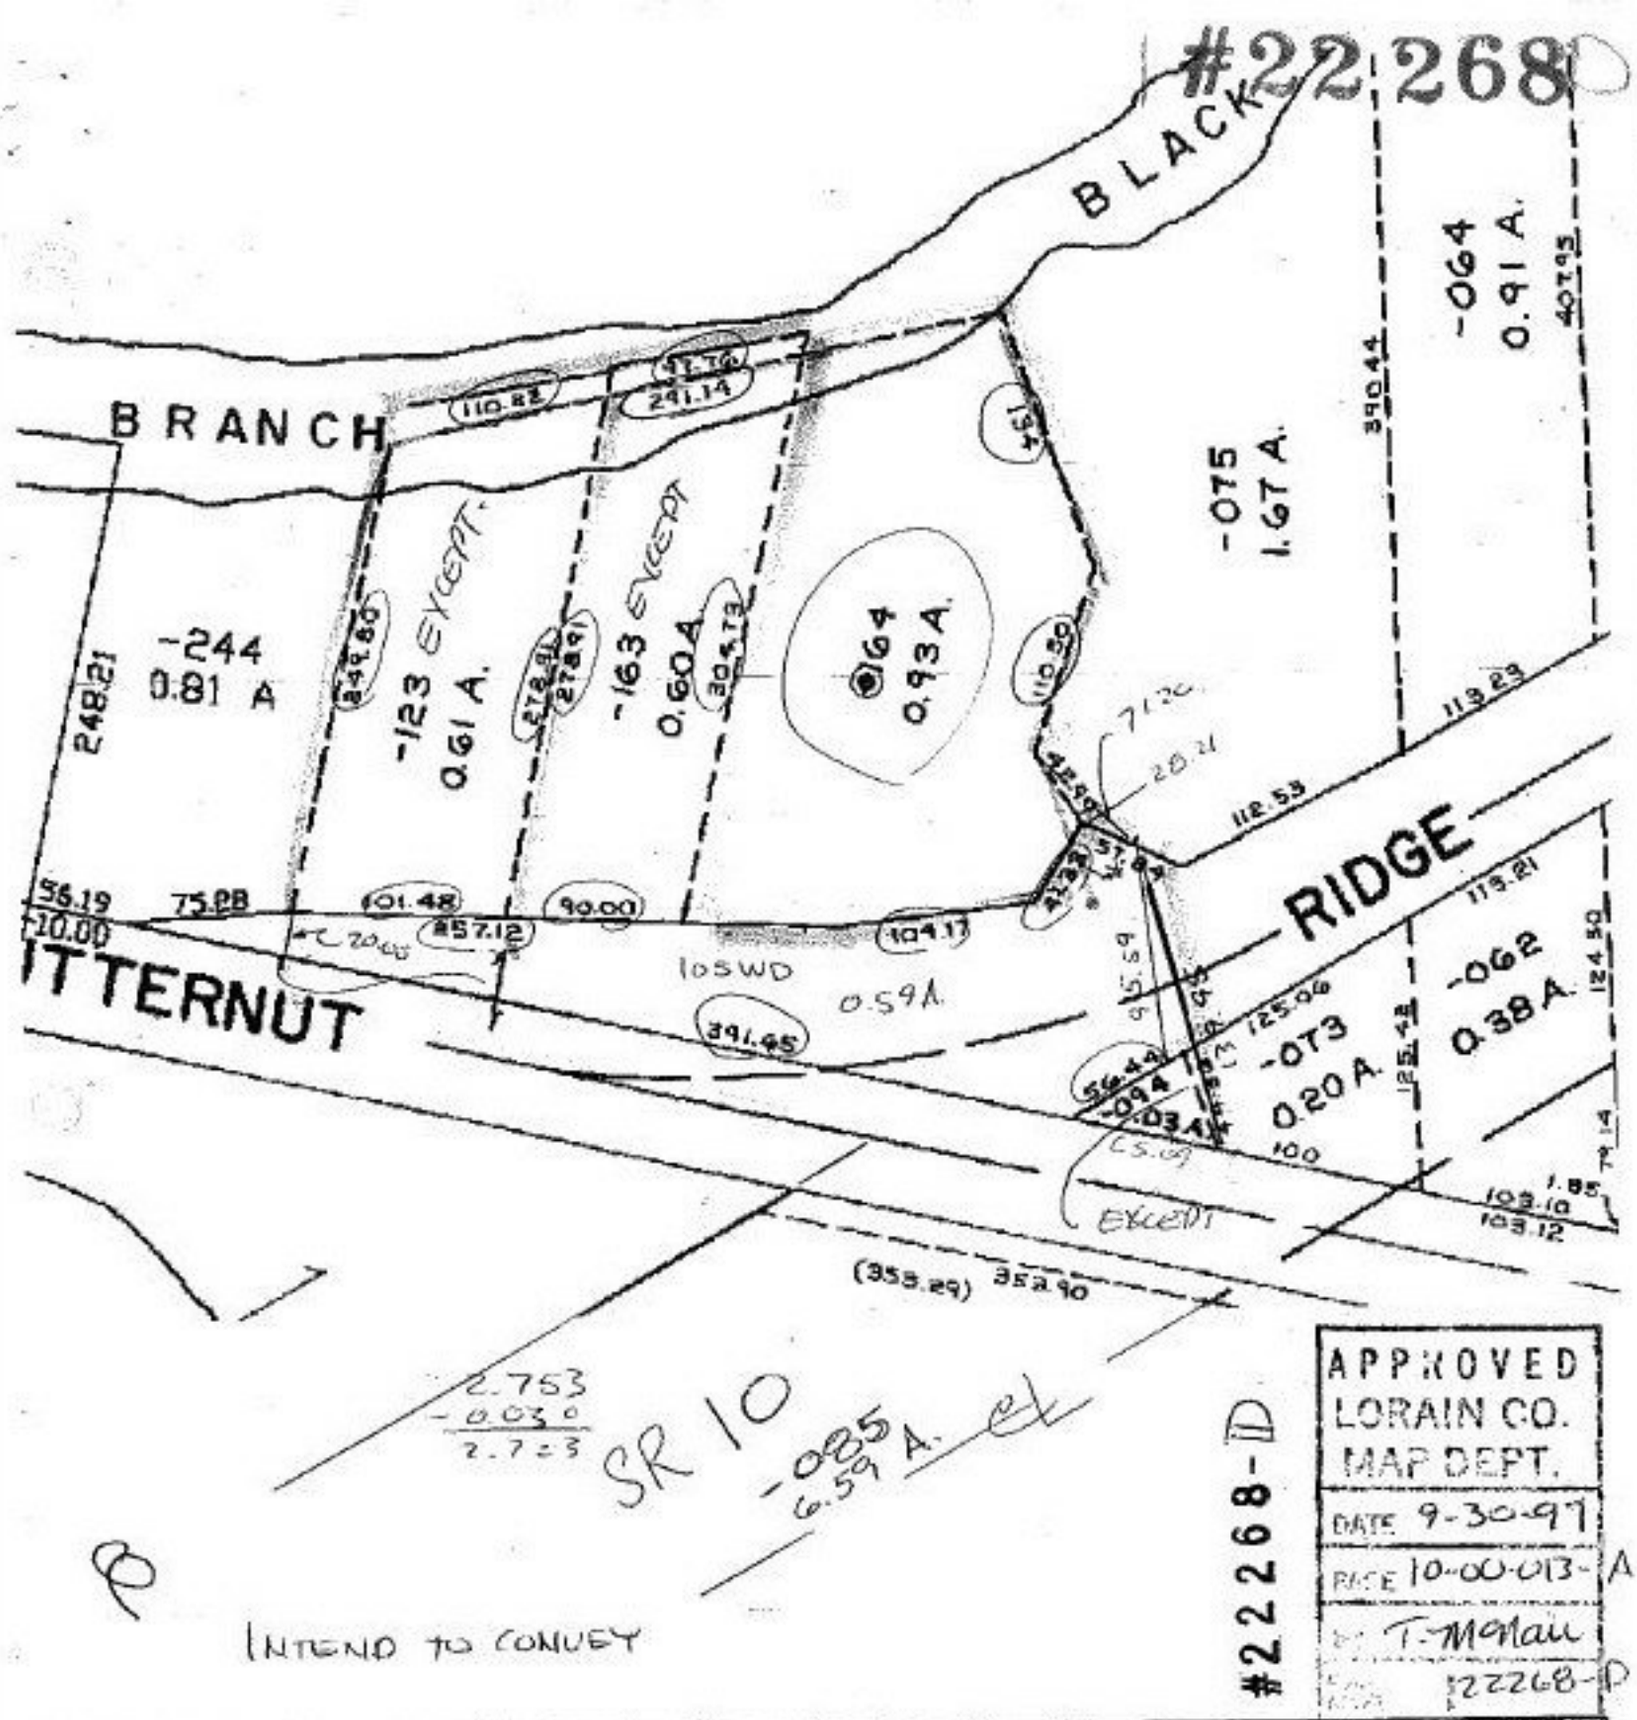

LORAIN COUNTY AUDITOR'S OFFICE
MARK R. STEWART
LORAIN COUNTY AUDITOR

LORAIN COUNTY ENGINEER'S OFFICE
KENNETH P. CARNEY SR.
LORAIN COUNTY ENGINEER

NOTE: TAX MAP NOT DRAWN TO SCALE