PARENT PARCEL: 08-12-009-000-018, 019

CHILD PARCEL: 08-12-009-000-025, 026, 027

STARTING POINT: cL of Becker Rd. & Gore-Orphanage Rd.

NO. 22271

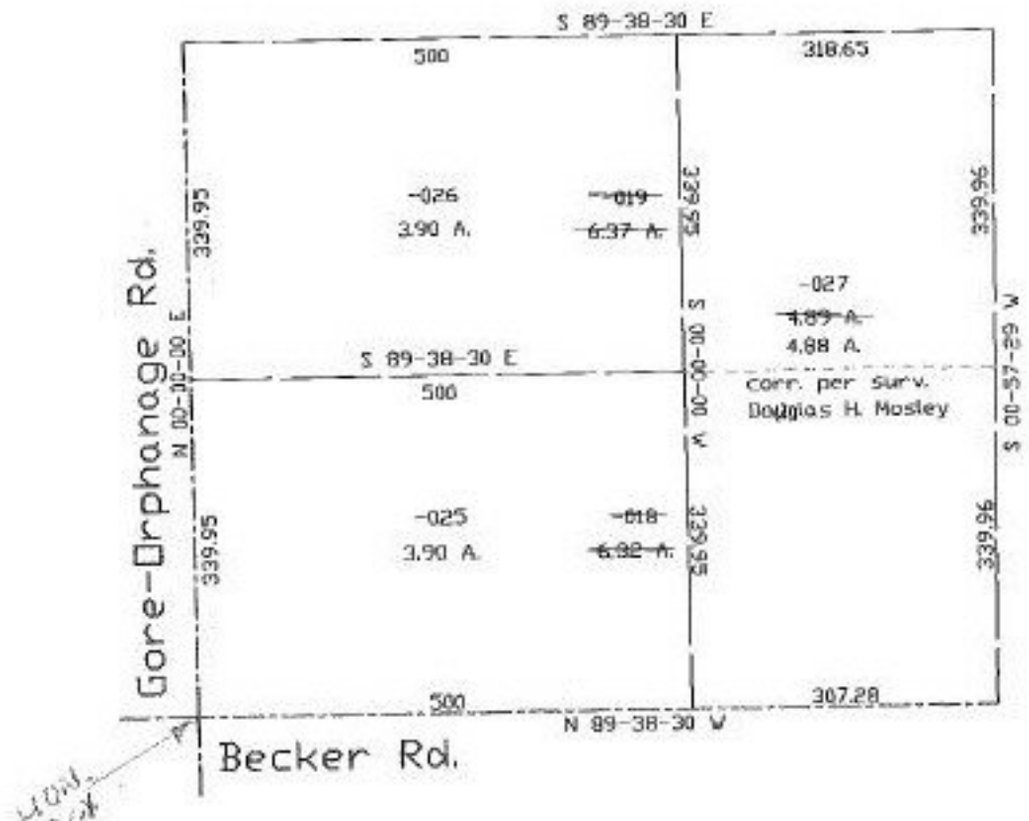

TS
2-18-98

SPLITS/DEEDS PROCESSED

LORAIN COUNTY TAX MAP DEPARTMENT
226 MIDDLE AVE. ELYRIA, OHIO

SURVEYED BY: Douglas H. Mosley

CLOSURE: 0.02 per 10,000

MAP PAGE(S): 8-E

APPROVED BY: kac DATE: 9/11/97

SCALE: 1" = 200 PRIOR INSTRUMENT: OR 1467/550