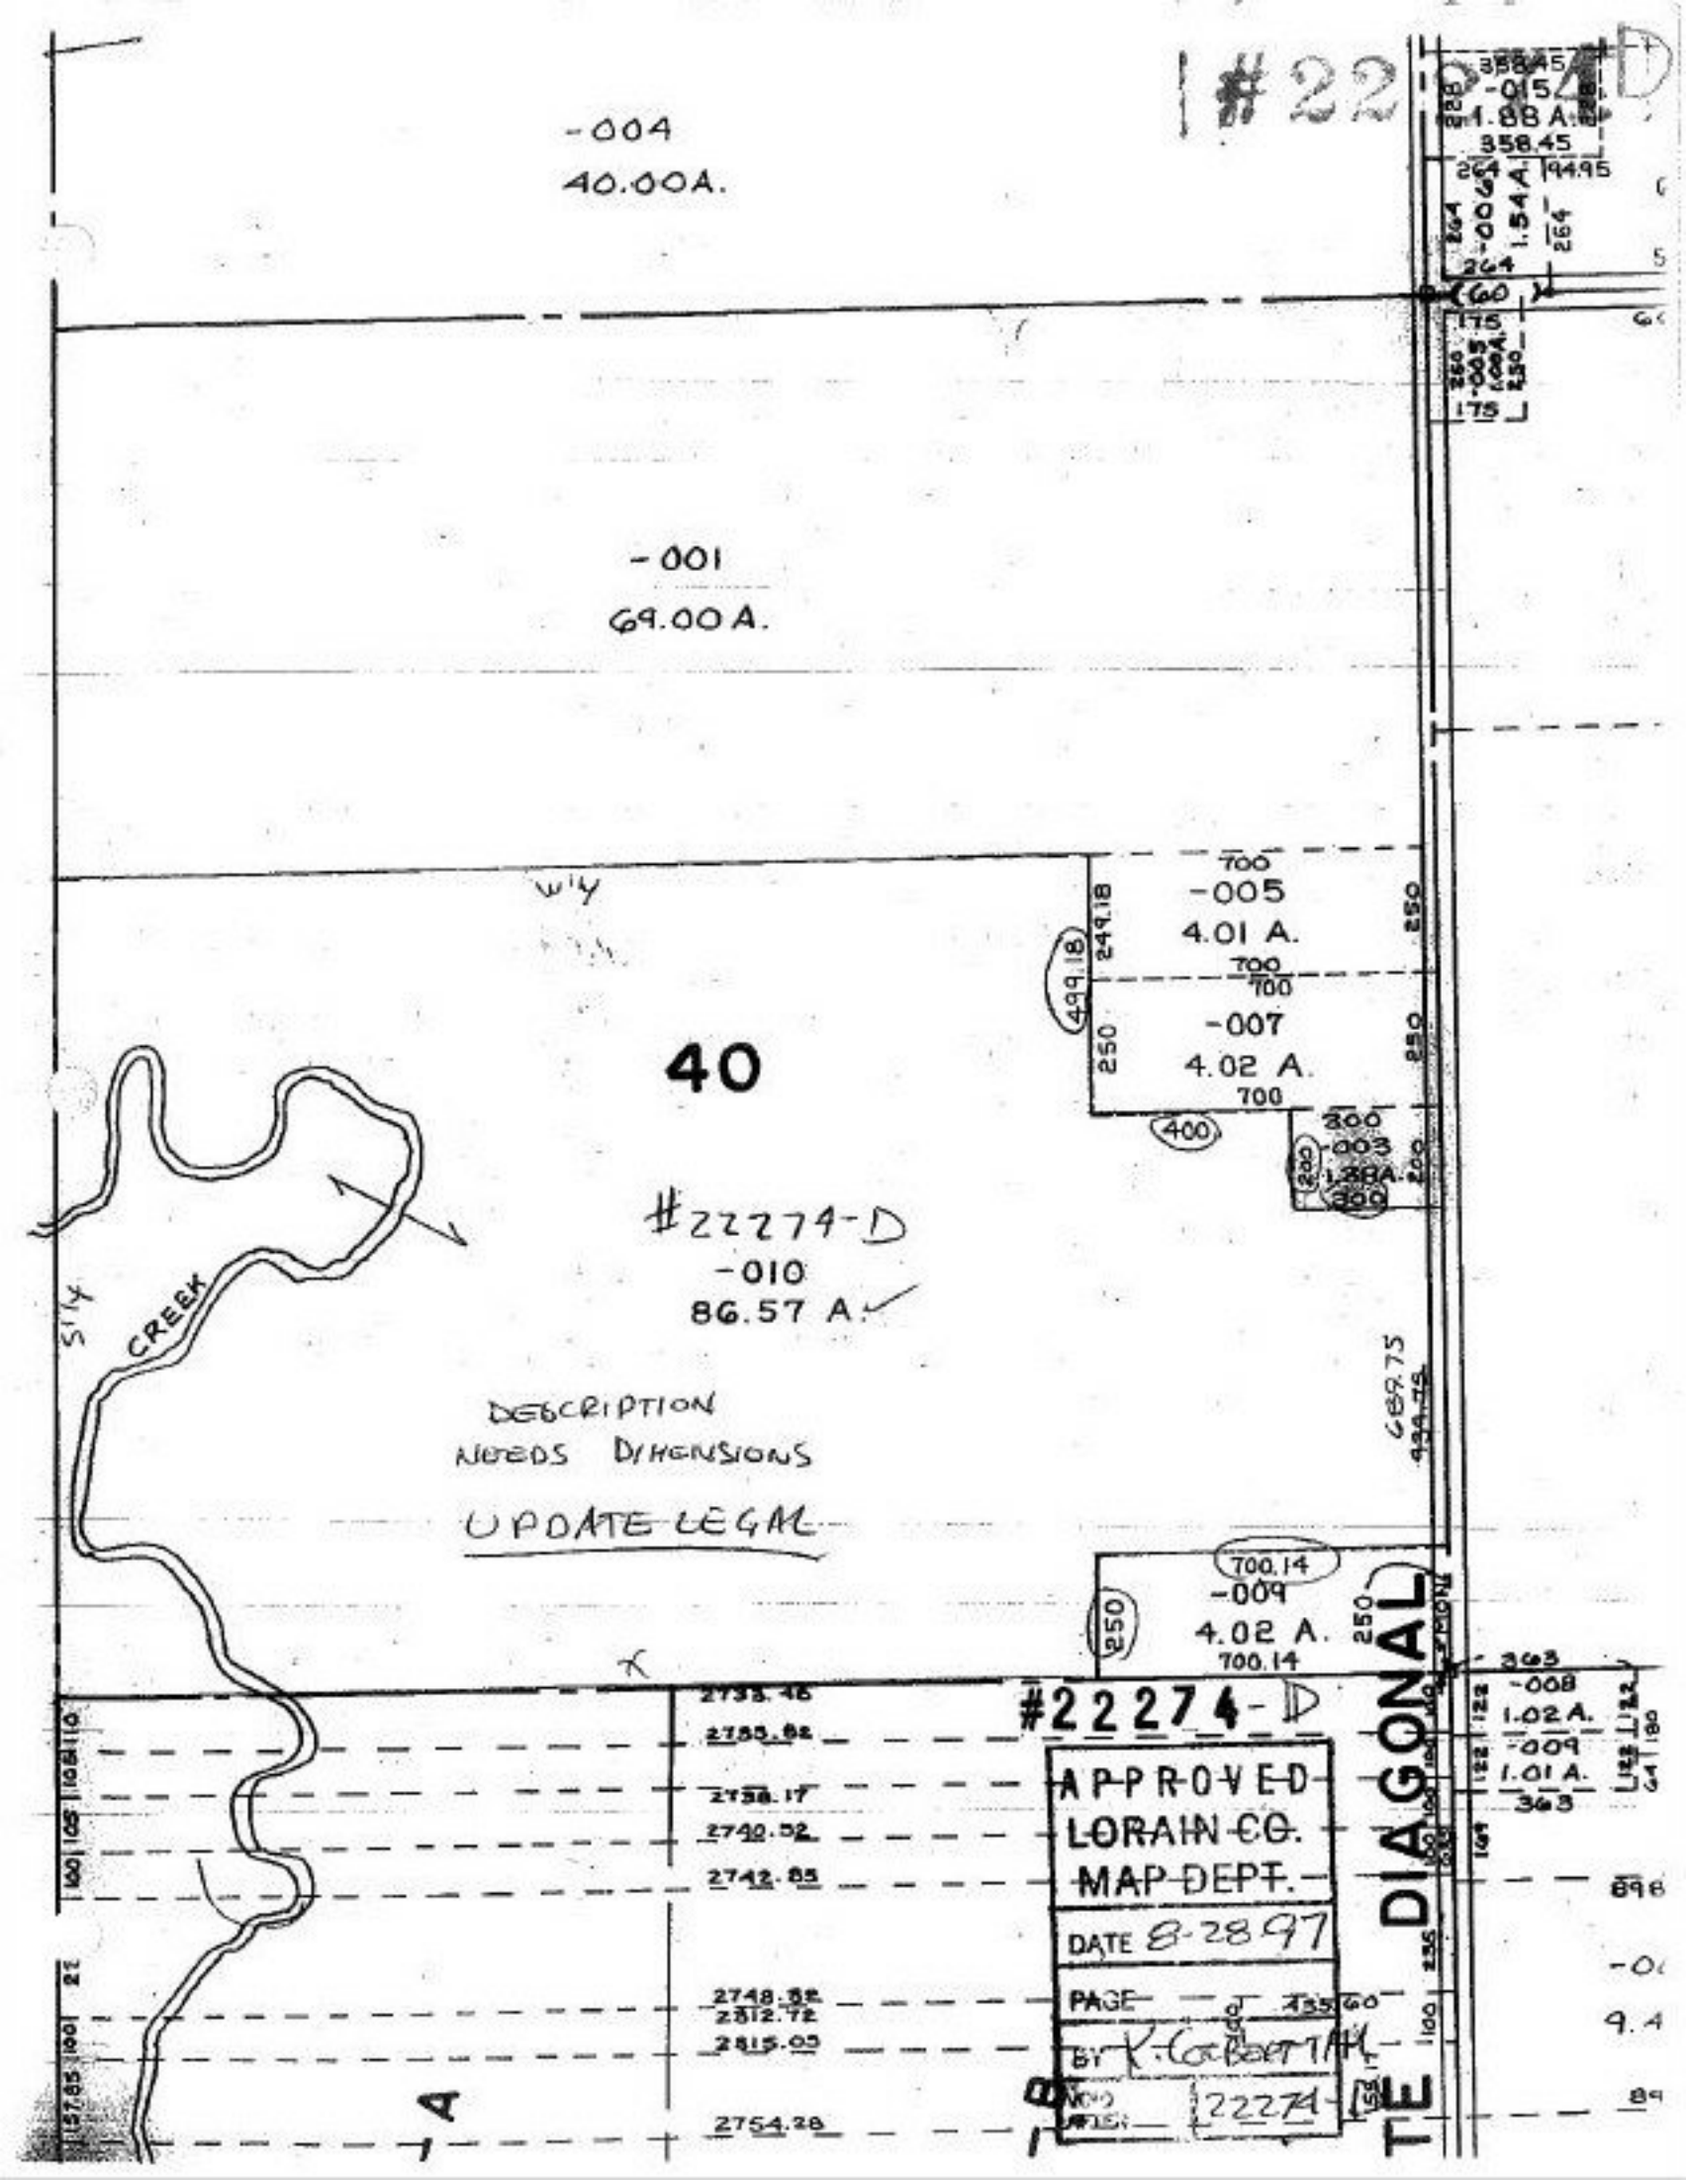
#22274-D
-004
40.00A.
-001
69.00 A.
40
-005
4.01 A.
-007
4.02 A.
-003
1.28A.
#22274-D
-010
86.57 A.
CREEK
DESCRIPTION
NEEDS DIMENSIONS
UPDATE LEGAL
-009
4.02 A.
#22274-D
APPROVED
LORAIN CO.
MAP DEPT.
DATE 8-28-97
PAGE
BY K. Gabbard
#22274
DIAGONAL