#22279-D

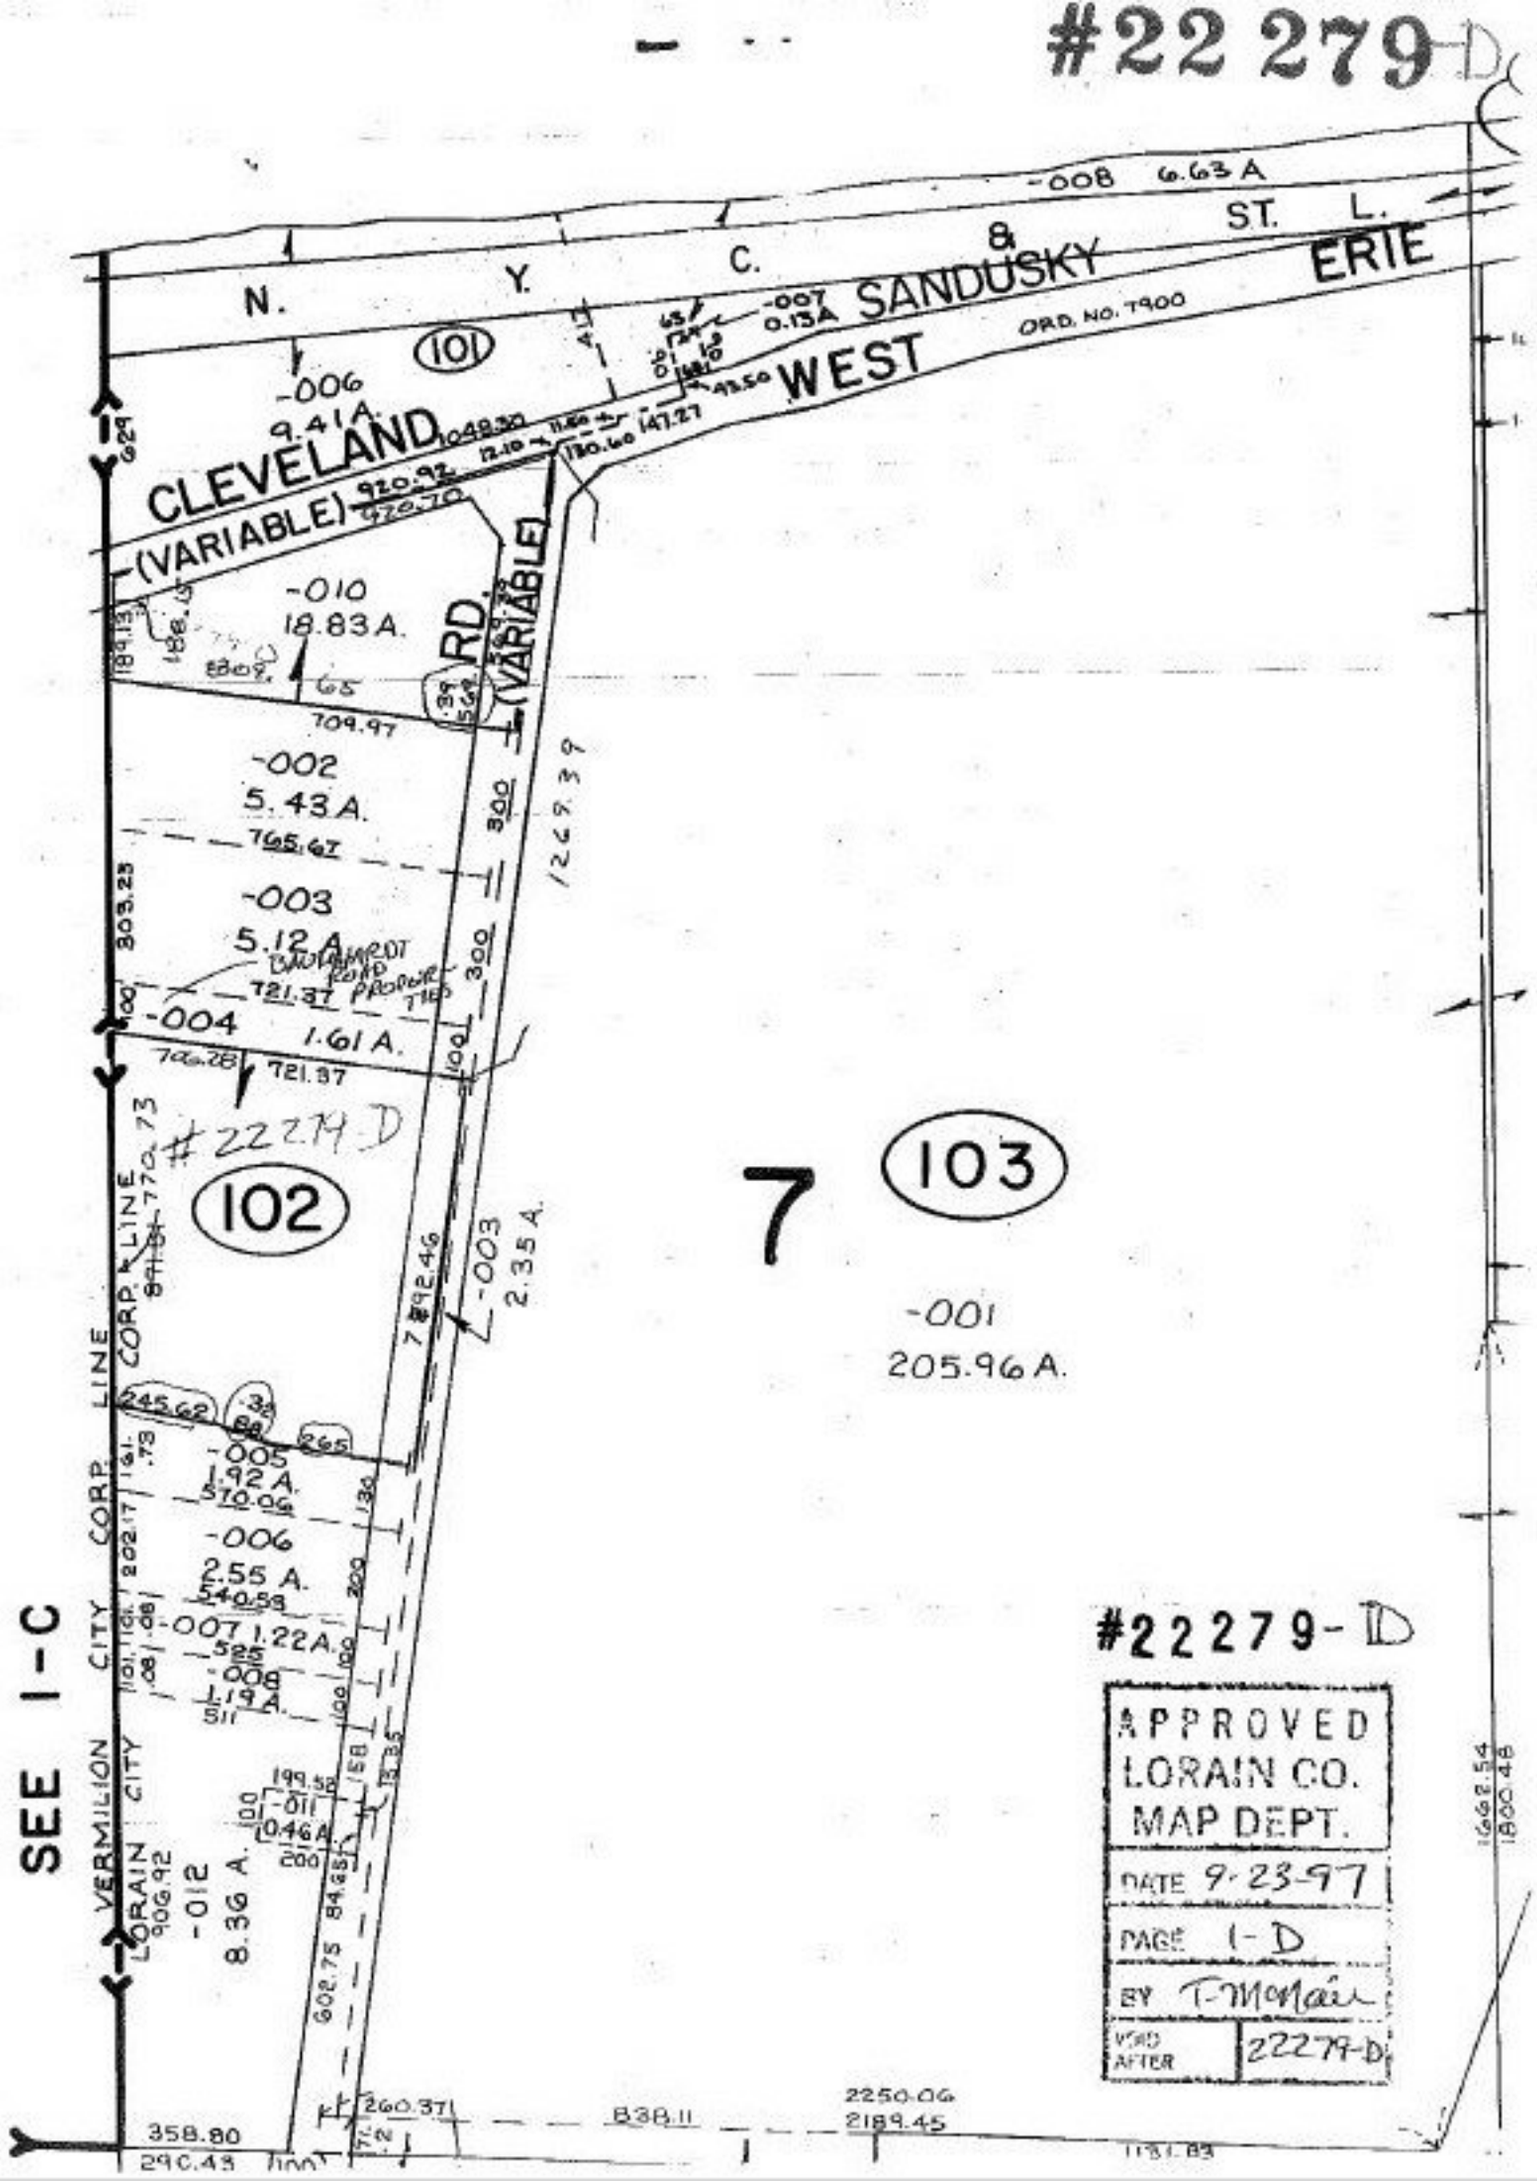

#22279-D

APPROVED
LORAIN CO.
MAP DEPT.
DATE 9-23-97
PAGE 1-D
BY T. McNair
VOID AFTER 22279-D