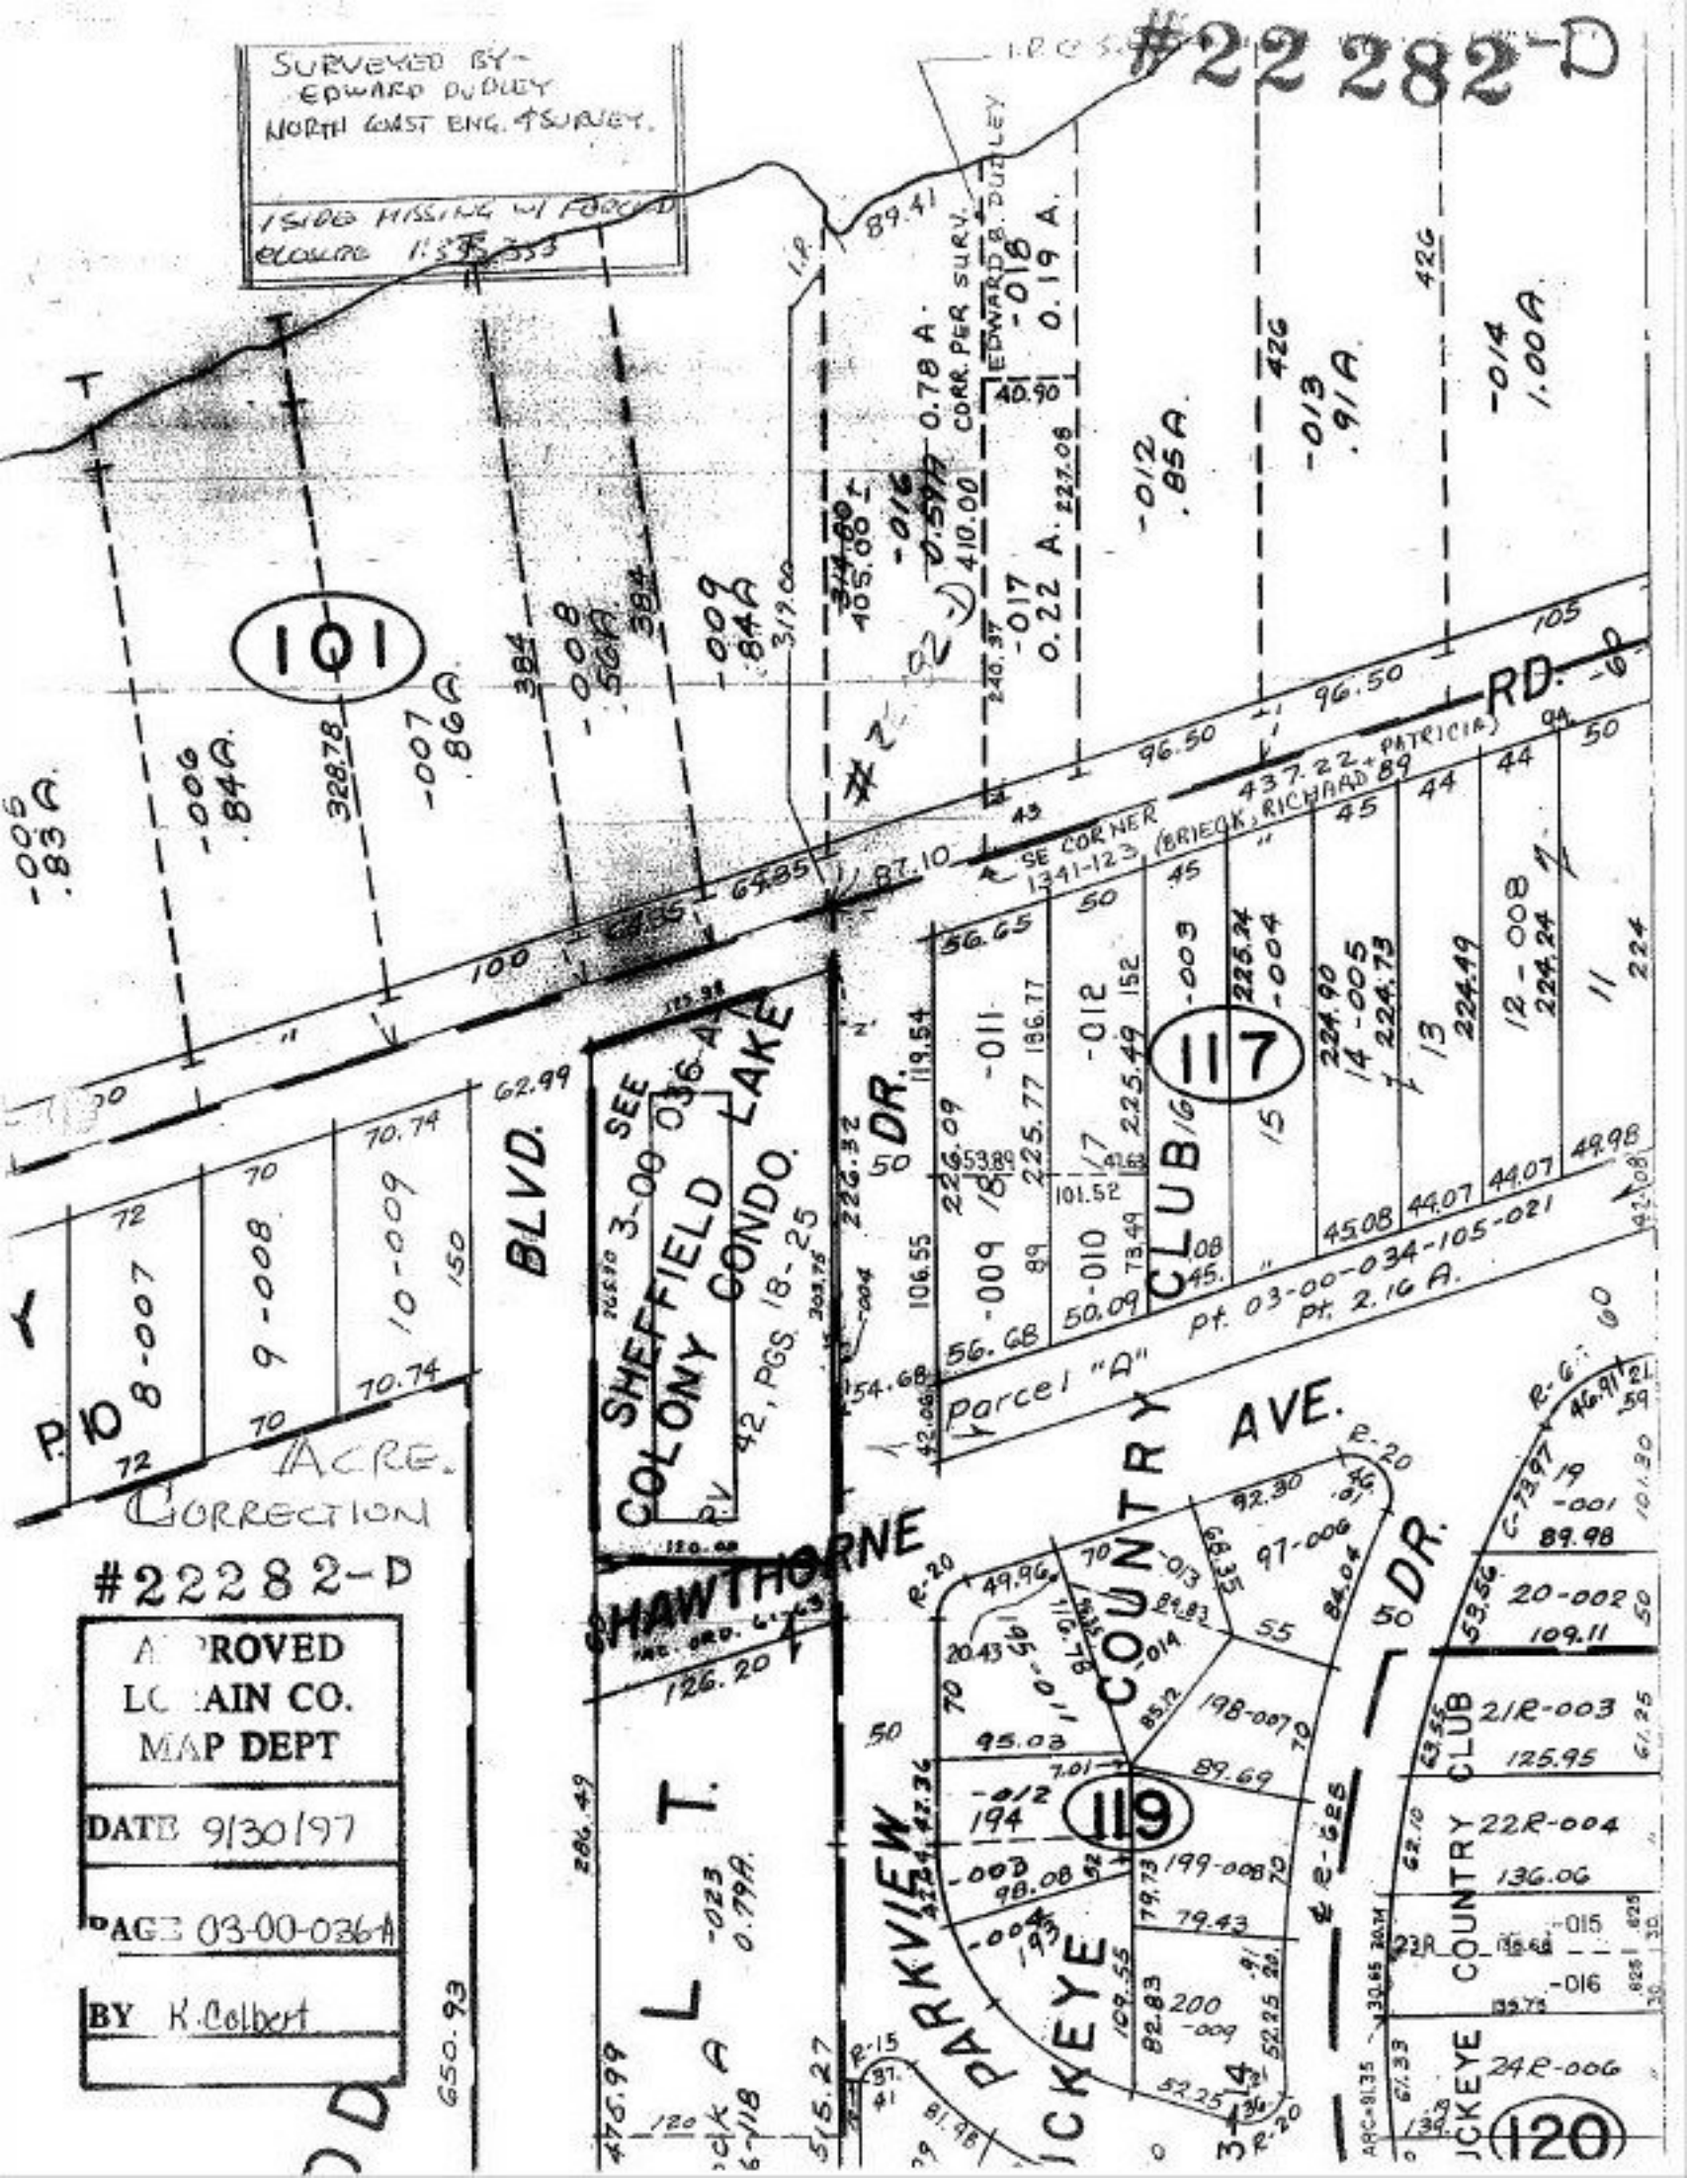

#22282-D
SURVEYED BY-
EDWARD DUDLEY
NORTH COAST ENG. & SURVEY.
1 SIDE MISSING W/ FORCED CLOSURE
101
117
119
120
SHEFFIELD LAKE
COLONY CONDO.
SEE 3-00-036-A
42, PGS. 18-25
SHAWTHORNE
BLVD.
DR.
RD.
AVE.
PARKVIEW
COUNTRY CLUB
JUCKEYE
SE CORNER 1341-123 (BRIECK, RICHARD & PATRICIA)
437.22
Parcel "A"
Pt. 03-00-034-105-021
Pt. 2.16 A.
ACRE. CORRECTION
#22282-D
APPROVED
LORAIN CO.
MAP DEPT
DATE 9/30/97
PAGE 03-00-036-A
BY K. Colbert