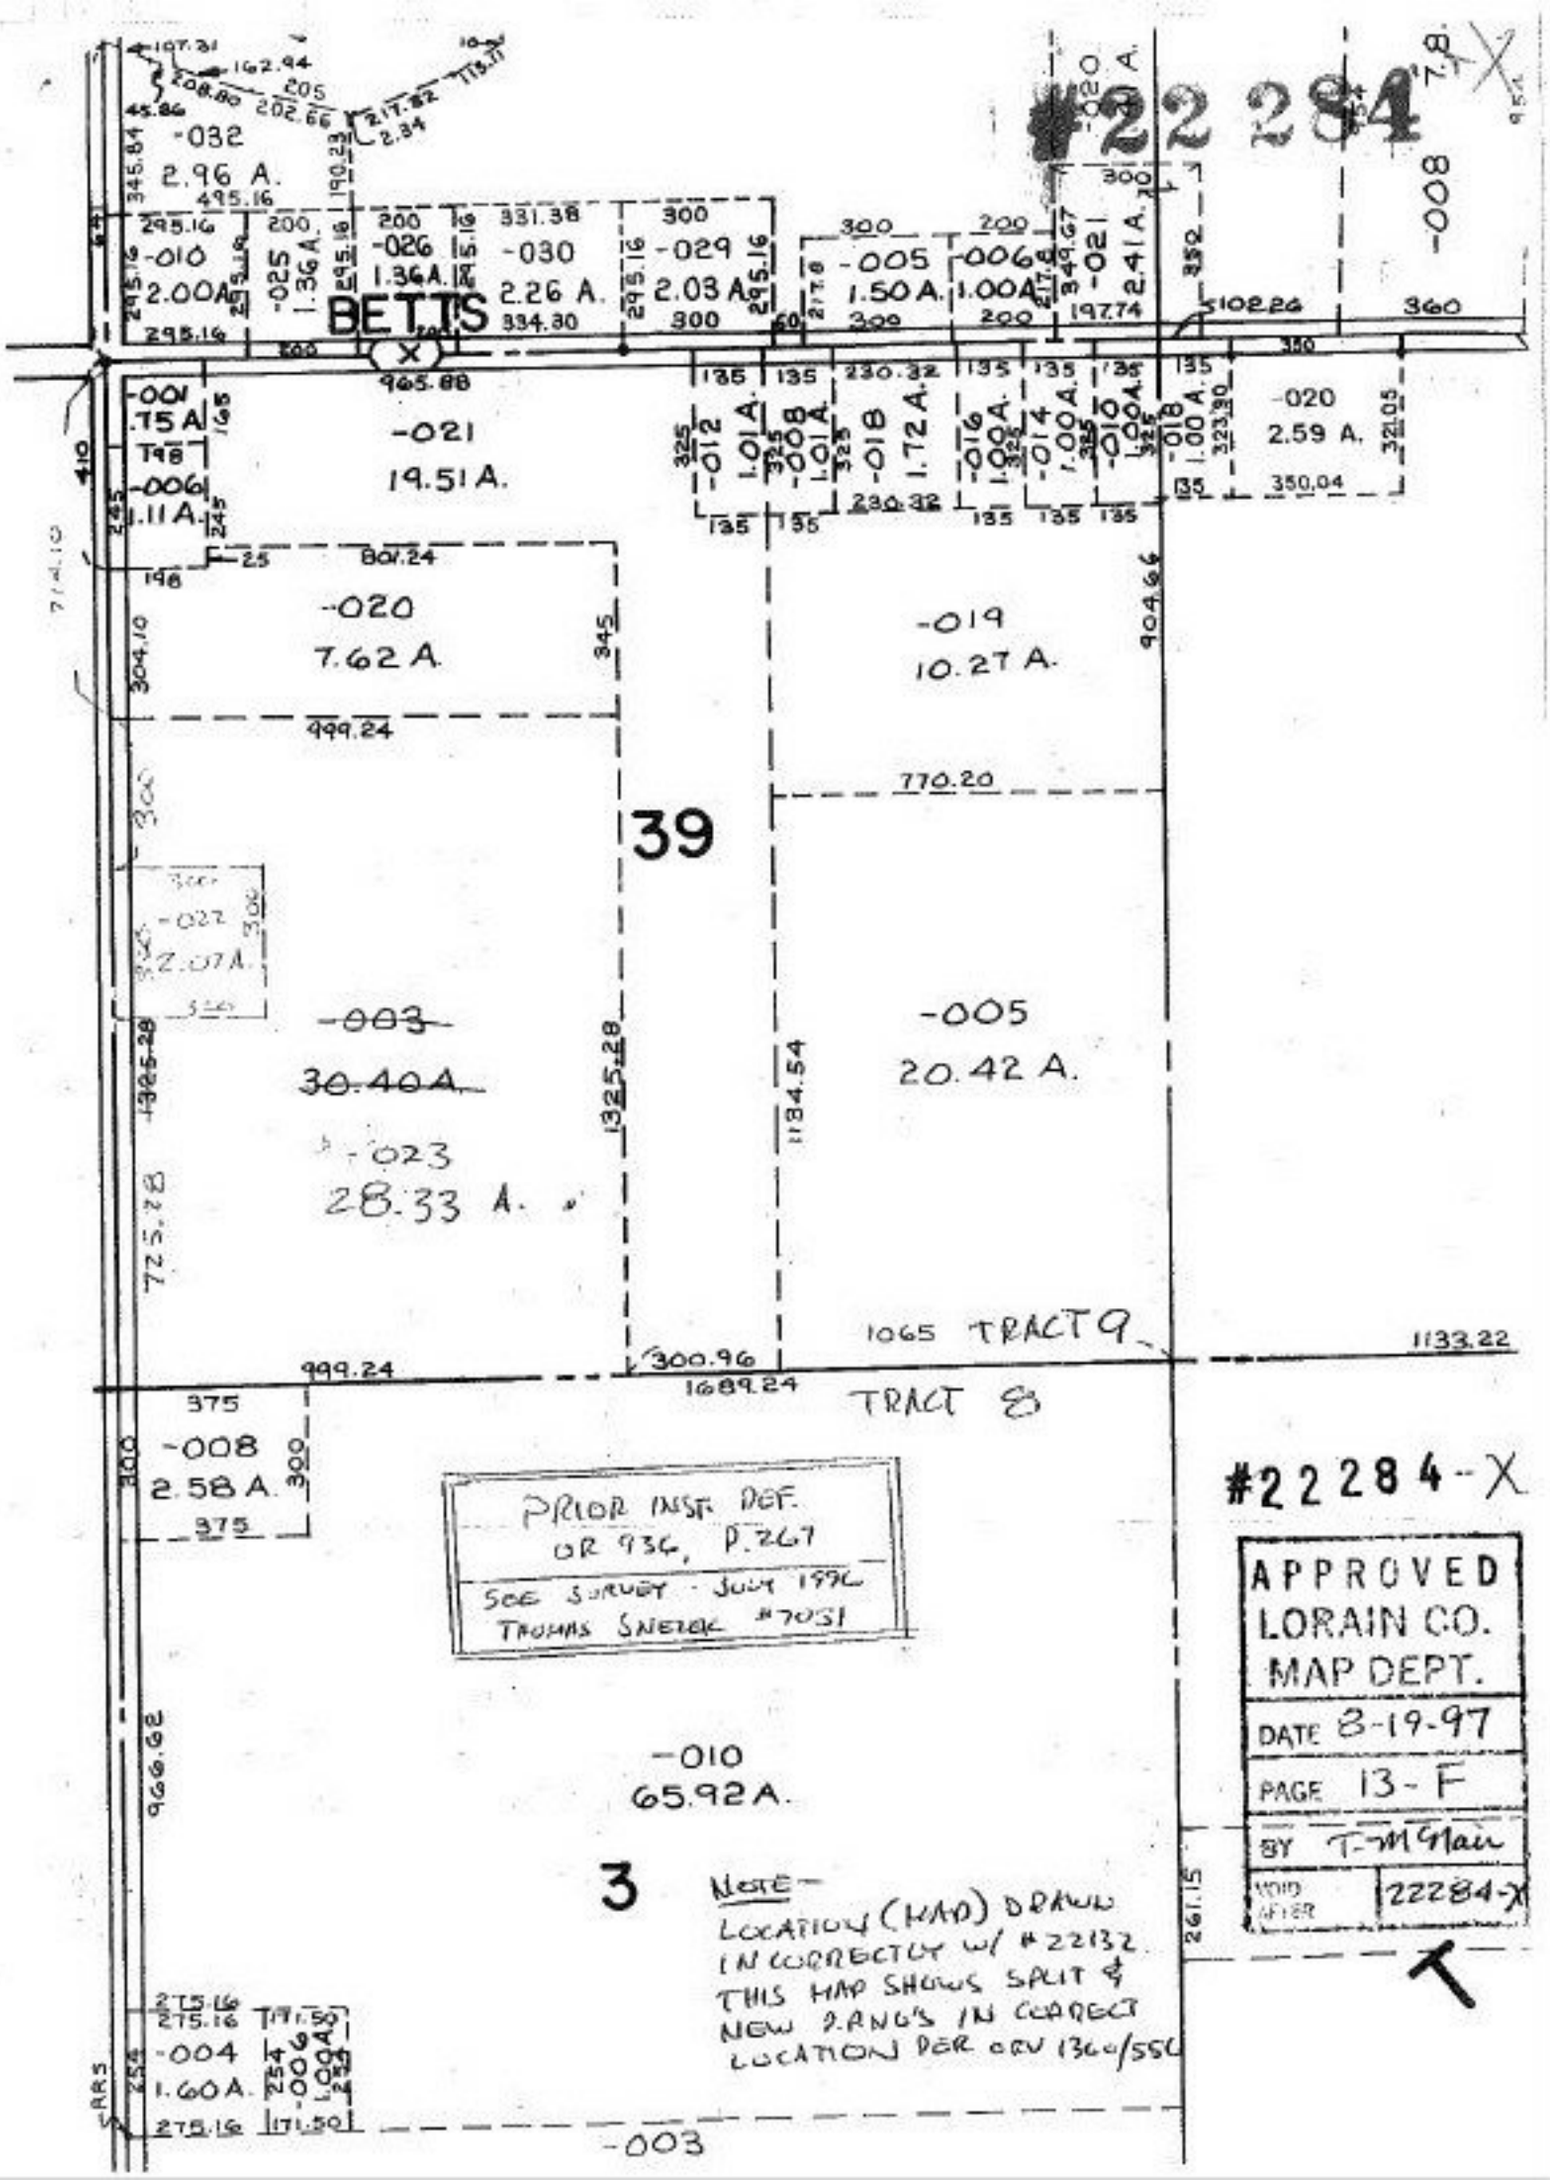
#22284
-032
2.96 A.
-010
2.00A.
-025
1.36 A.
-026
1.36A.
-030
2.26 A.
-029
2.03 A.
-005
1.50 A.
-006
1.00A.
-021
2.41 A.
-008
BETTS
-001
.75 A
T48
-006
1.11 A.
-021
19.51 A.
-012
1.01 A.
-008
1.01 A.
-018
1.72 A.
-016
1.00 A.
-014
1.00 A.
-010
1.00 A.
-018
1.00 A.
-020
2.59 A.
-020
7.62 A.
-019
10.27 A.
39
-022
2.07 A.
-003
30.40 A.
-023
28.33 A.
-005
20.42 A.
1065 TRACT 9
TRACT 8
-008
2.58 A.
PRIOR INST. REF.
OR 936, P. 267
SEE SURVEY - JULY 1996
THOMAS SNIEDER #7051
#22284-X
APPROVED
LORAIN CO.
MAP DEPT.
DATE 8-19-97
PAGE 13-F
BY T-McMain
VOID AFTER 22284-X
-010
65.92A.
3
NOTE-
LOCATION (MAP) DRAWN
INCORRECTLY W/ #22132.
THIS MAP SHOWS SPLIT &
NEW D.ANG'S IN CORRECT
LOCATION PER ORV 1360/550
-004
1.60A.
-006
1.00A.
-003