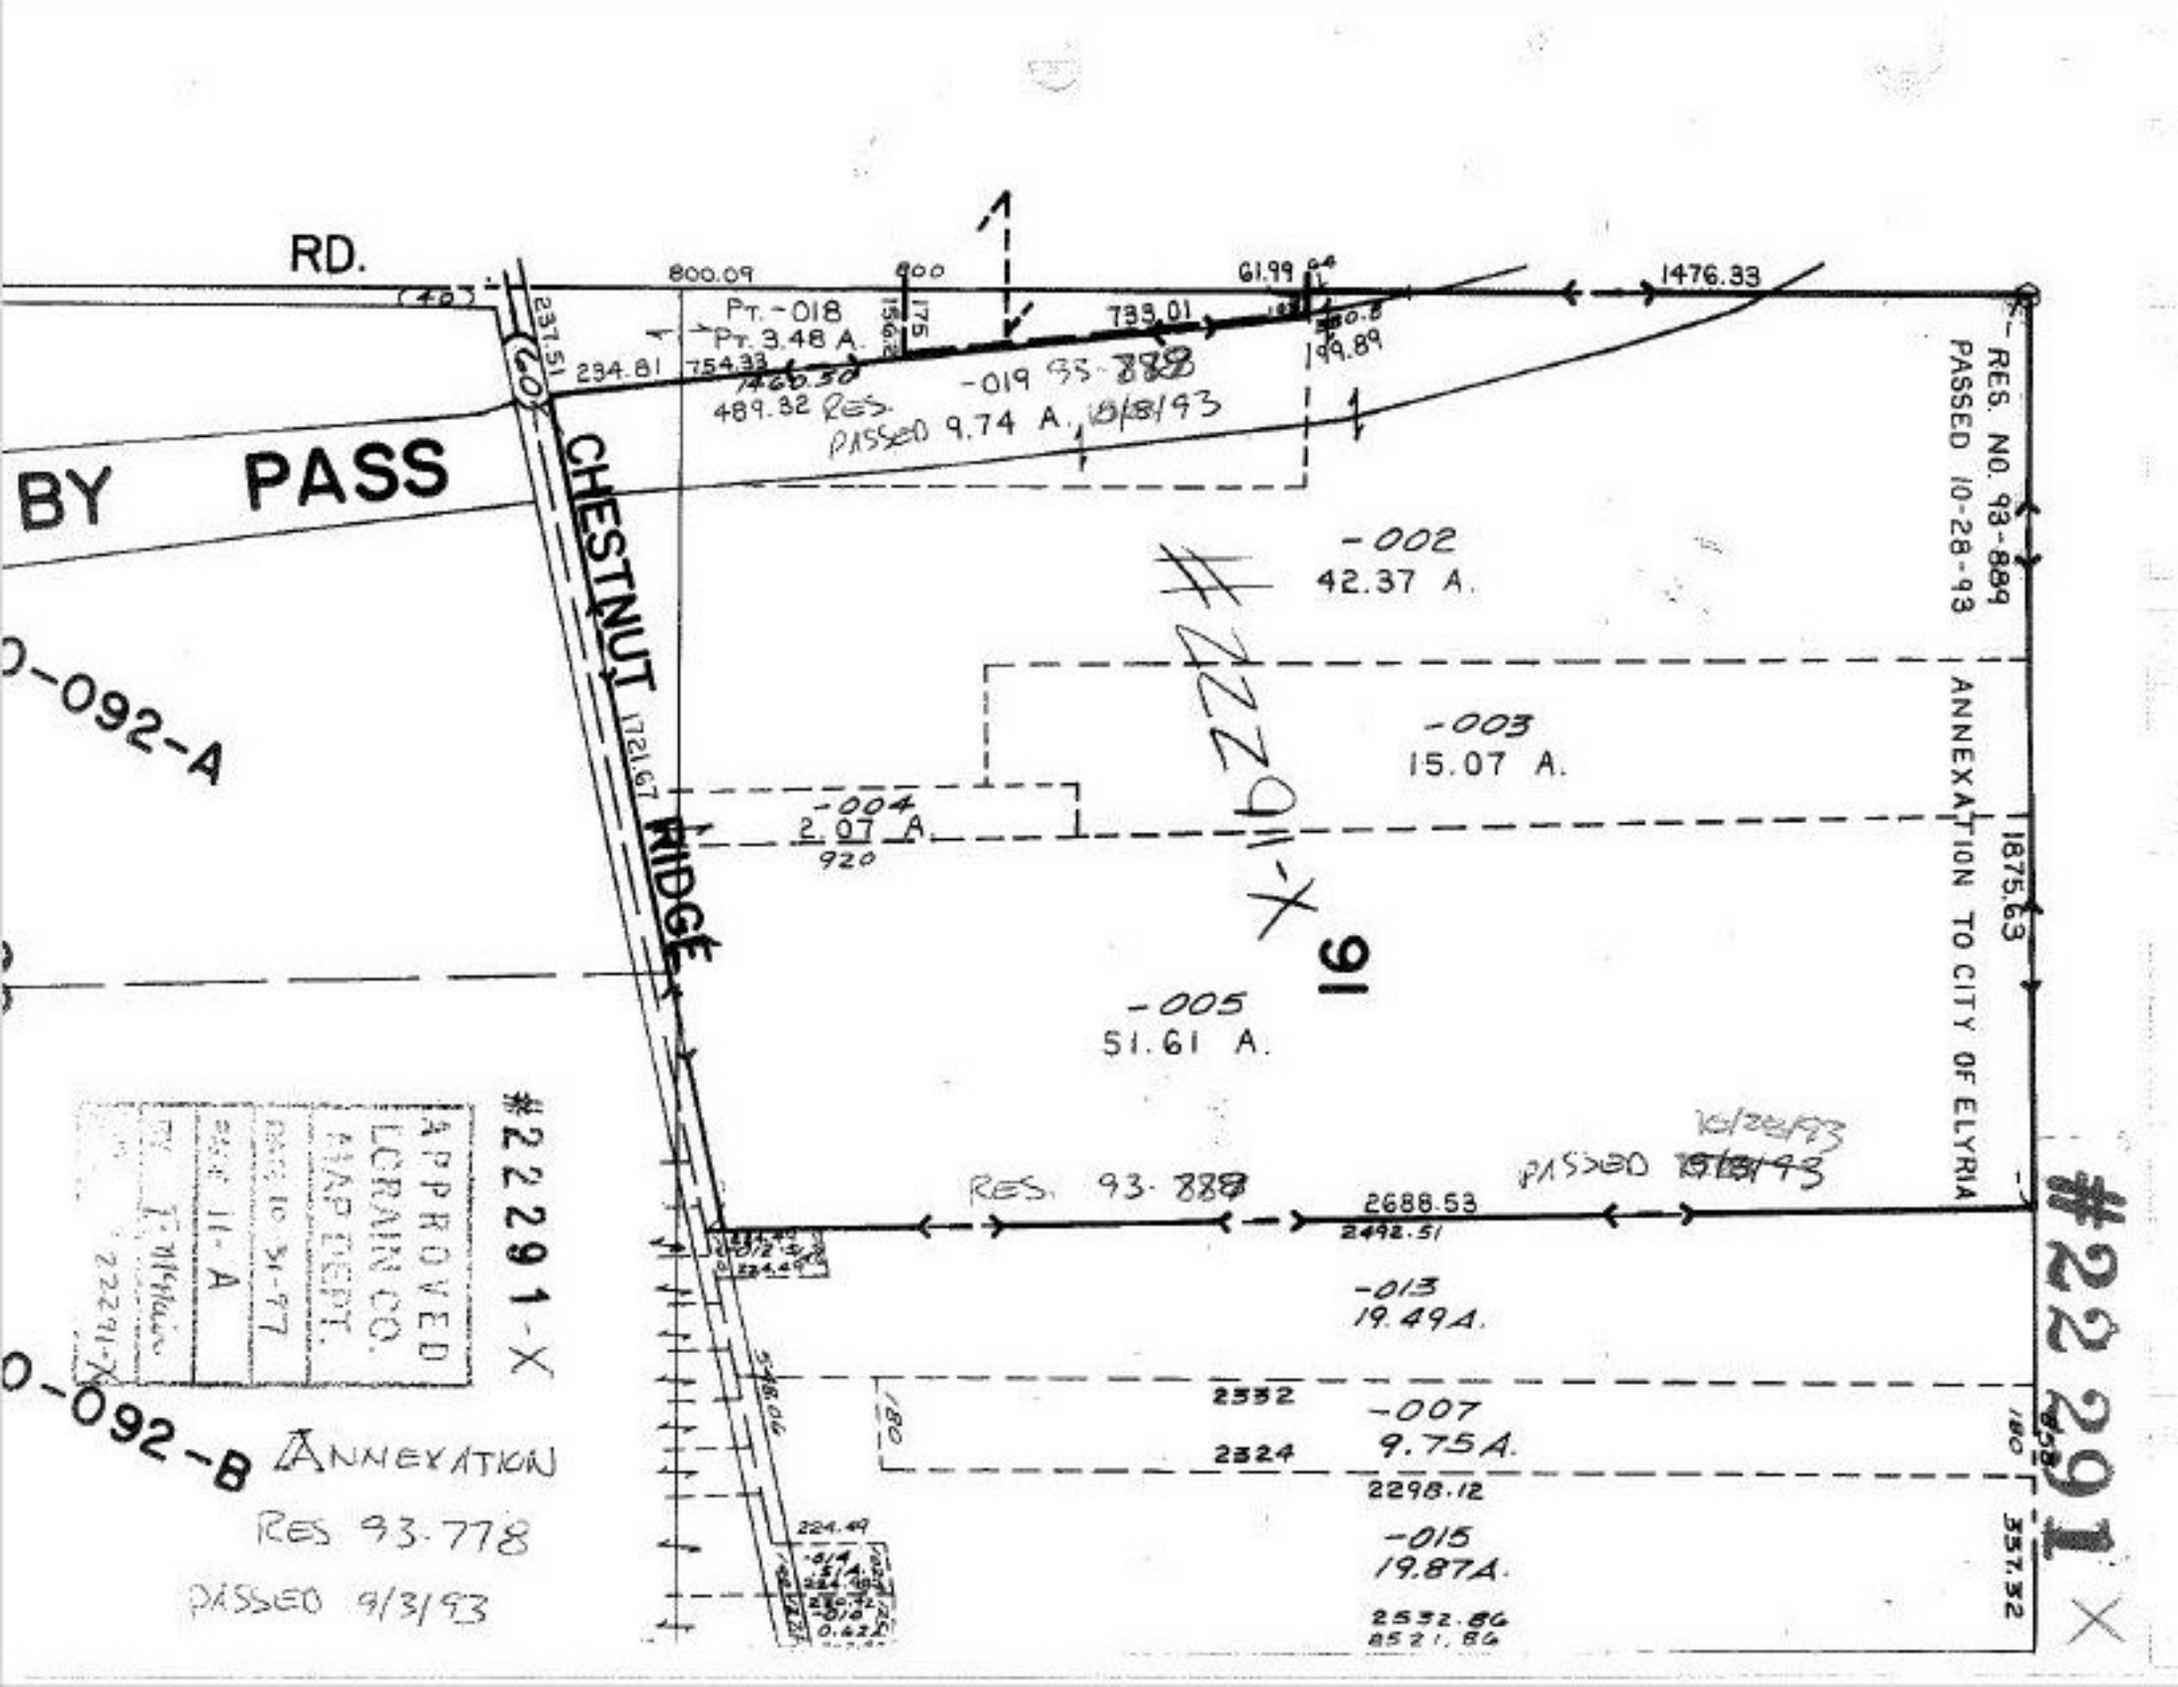
RD.
800.09
900
61.99
1476.33
Pt. - 018
Pt. 3.48 A.
739.01
754.33
466.30
489.32 RES.
PASSED 9.74 A. 8/8/93
-019 93-888
BY PASS
CHESTNUT RIDGE
1721.67
-002
42.37 A.
-003
15.07 A.
-004
2.07 A.
920
-005
51.61 A.
RES. NO. 93-889
PASSED 10-28-93
ANNEXATION TO CITY OF ELYRIA
1875.63
#22291-X
RES. 93-888
PASSED 10/28/93
2688.53
2492.51
-013
19.49A.
2532
2324
-007
9.75A.
2298.12
-015
19.87A.
2532.86
8521.86
357.32
#22291-X
APPROVED
LCRAIN CO.
MAP DEPT.
DATE 10-31-97
PAGE 11-A
BY T. McMahon
22291-X
0-092-A
0-092-B
ANNEXATION
RES 93-778
PASSED 9/3/93