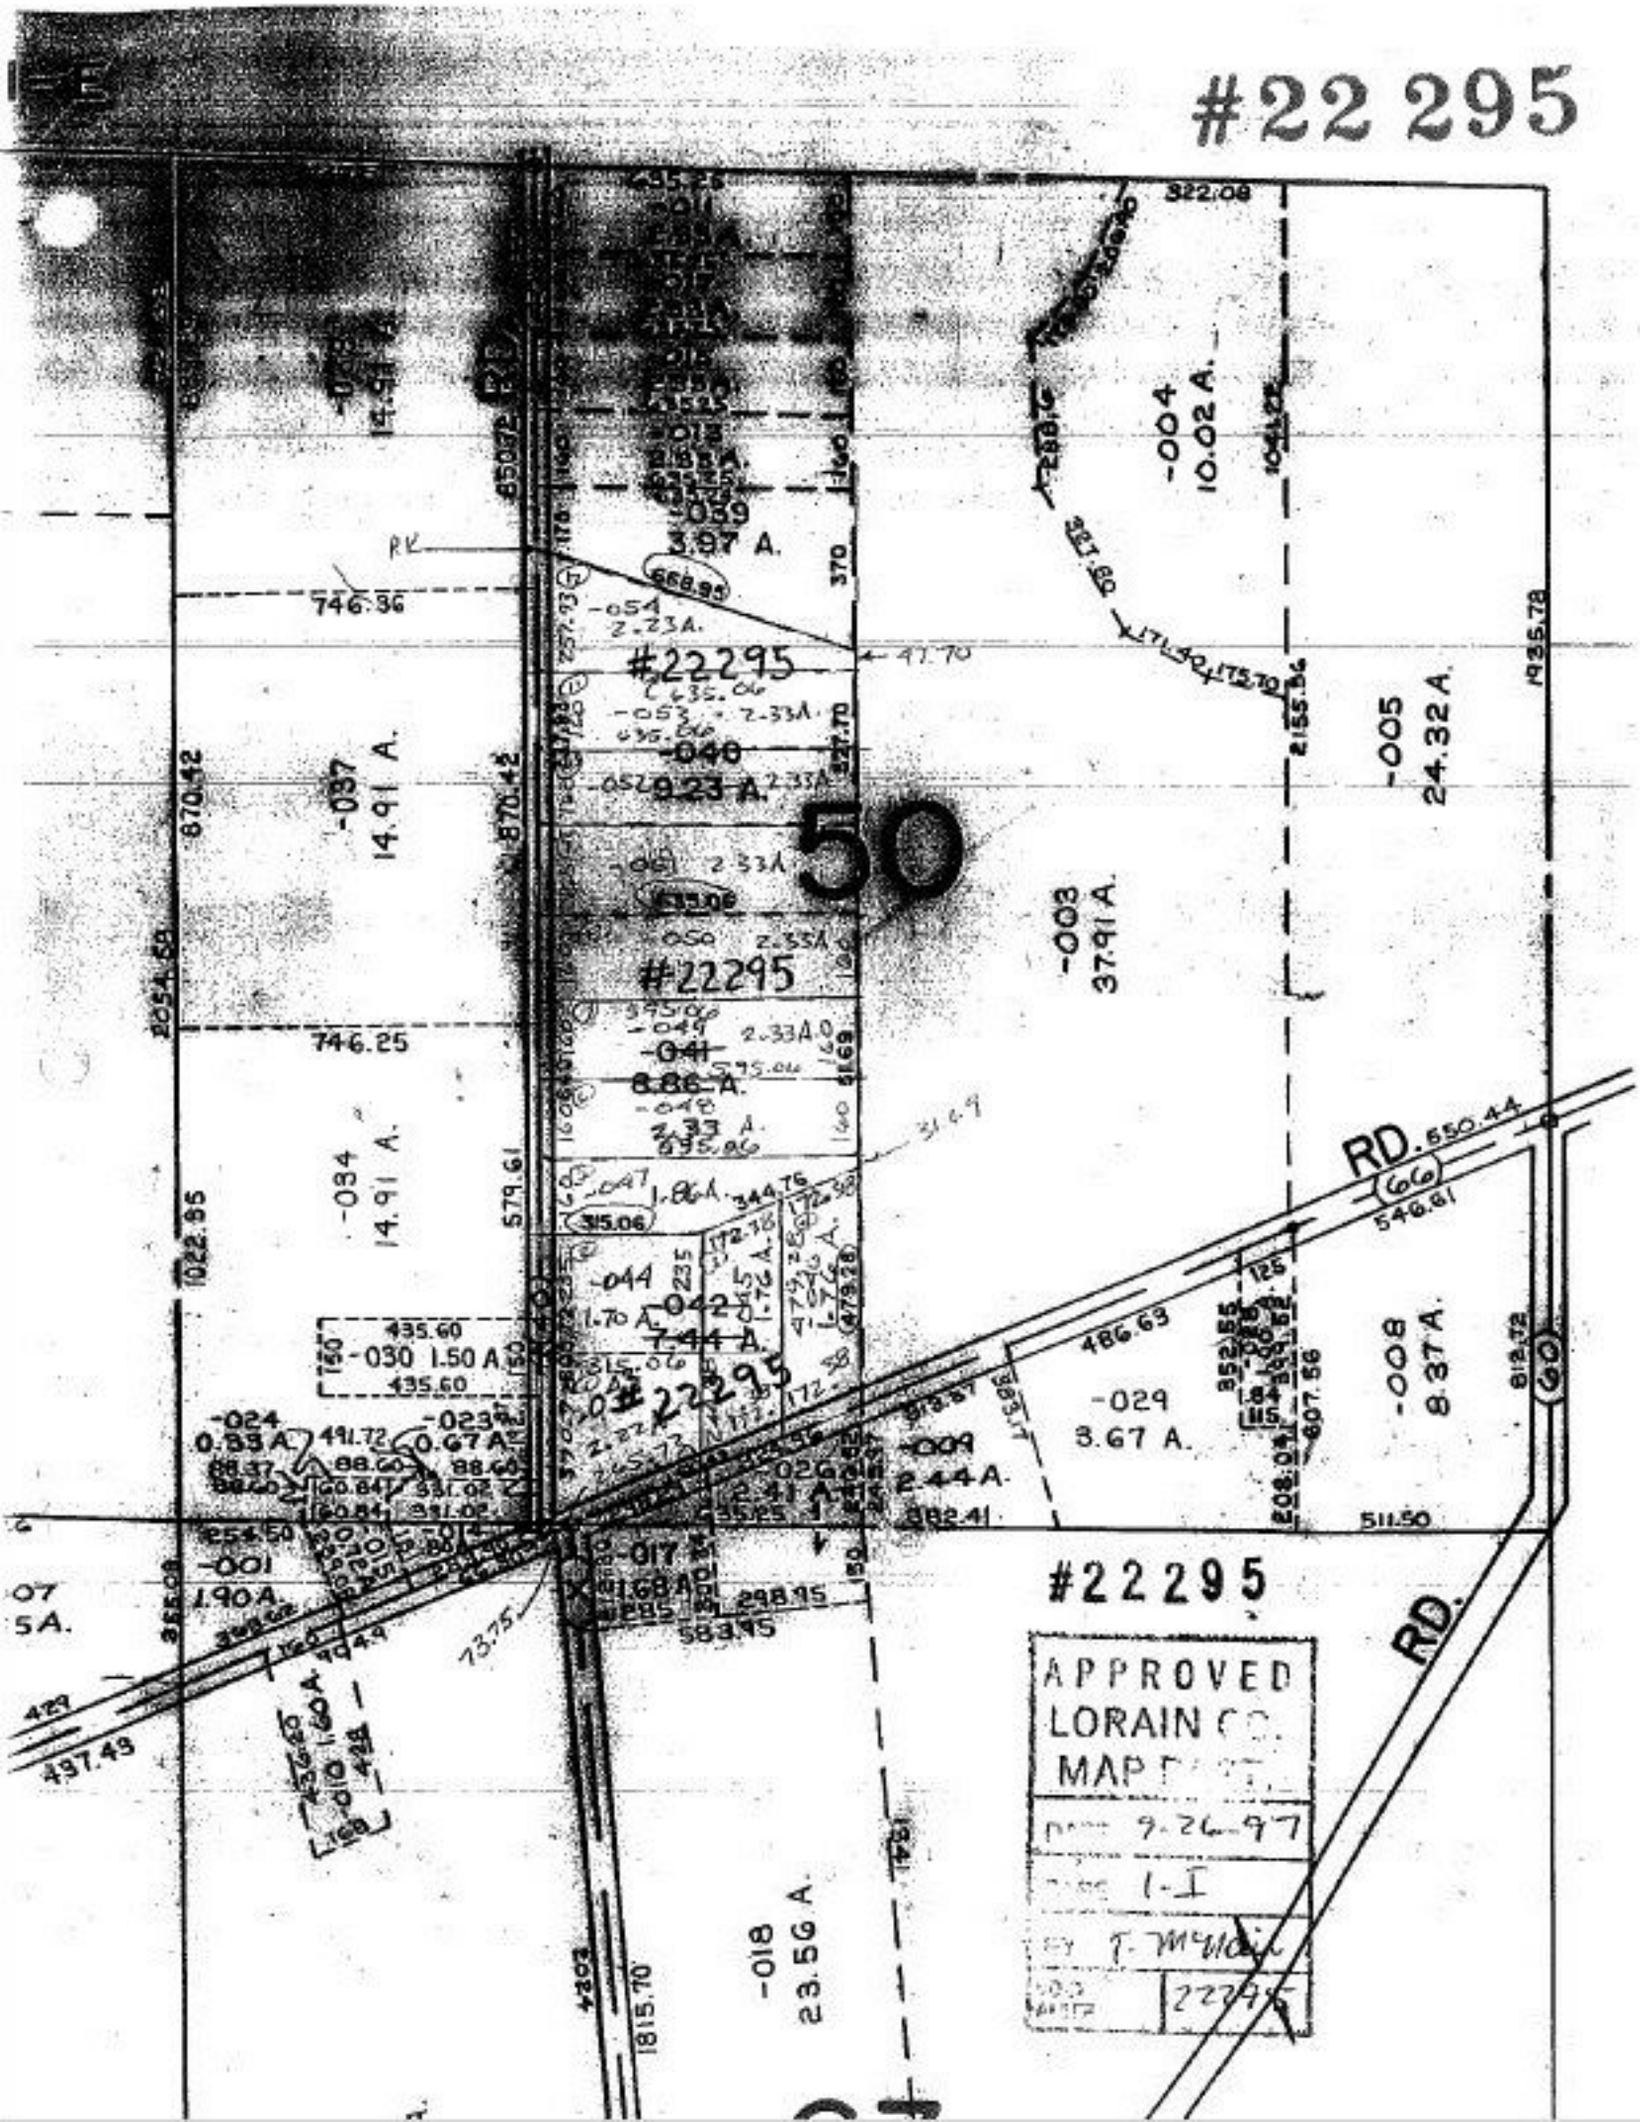
#22 295
#22295
#22295
#22295
#22295
50
-037
14.91 A.
-034
14.91 A.
-039
3.97 A.
-004
10.02 A.
-005
24.32 A.
-003
37.91 A.
-041
8.86 A.
-042
7.44 A.
-029
3.67 A.
-008
8.37 A.
-009
2.44 A.
-018
23.56 A.
-001
1.90 A.
-030 1.50 A
-024
0.83 A.
-023
0.67 A.
-017
1.68 A.
-010 1.60 A.
RD.
APPROVED
LORAIN CO.
MAP DEPT.
DATE 9-26-97
BY T. McNeil
22295