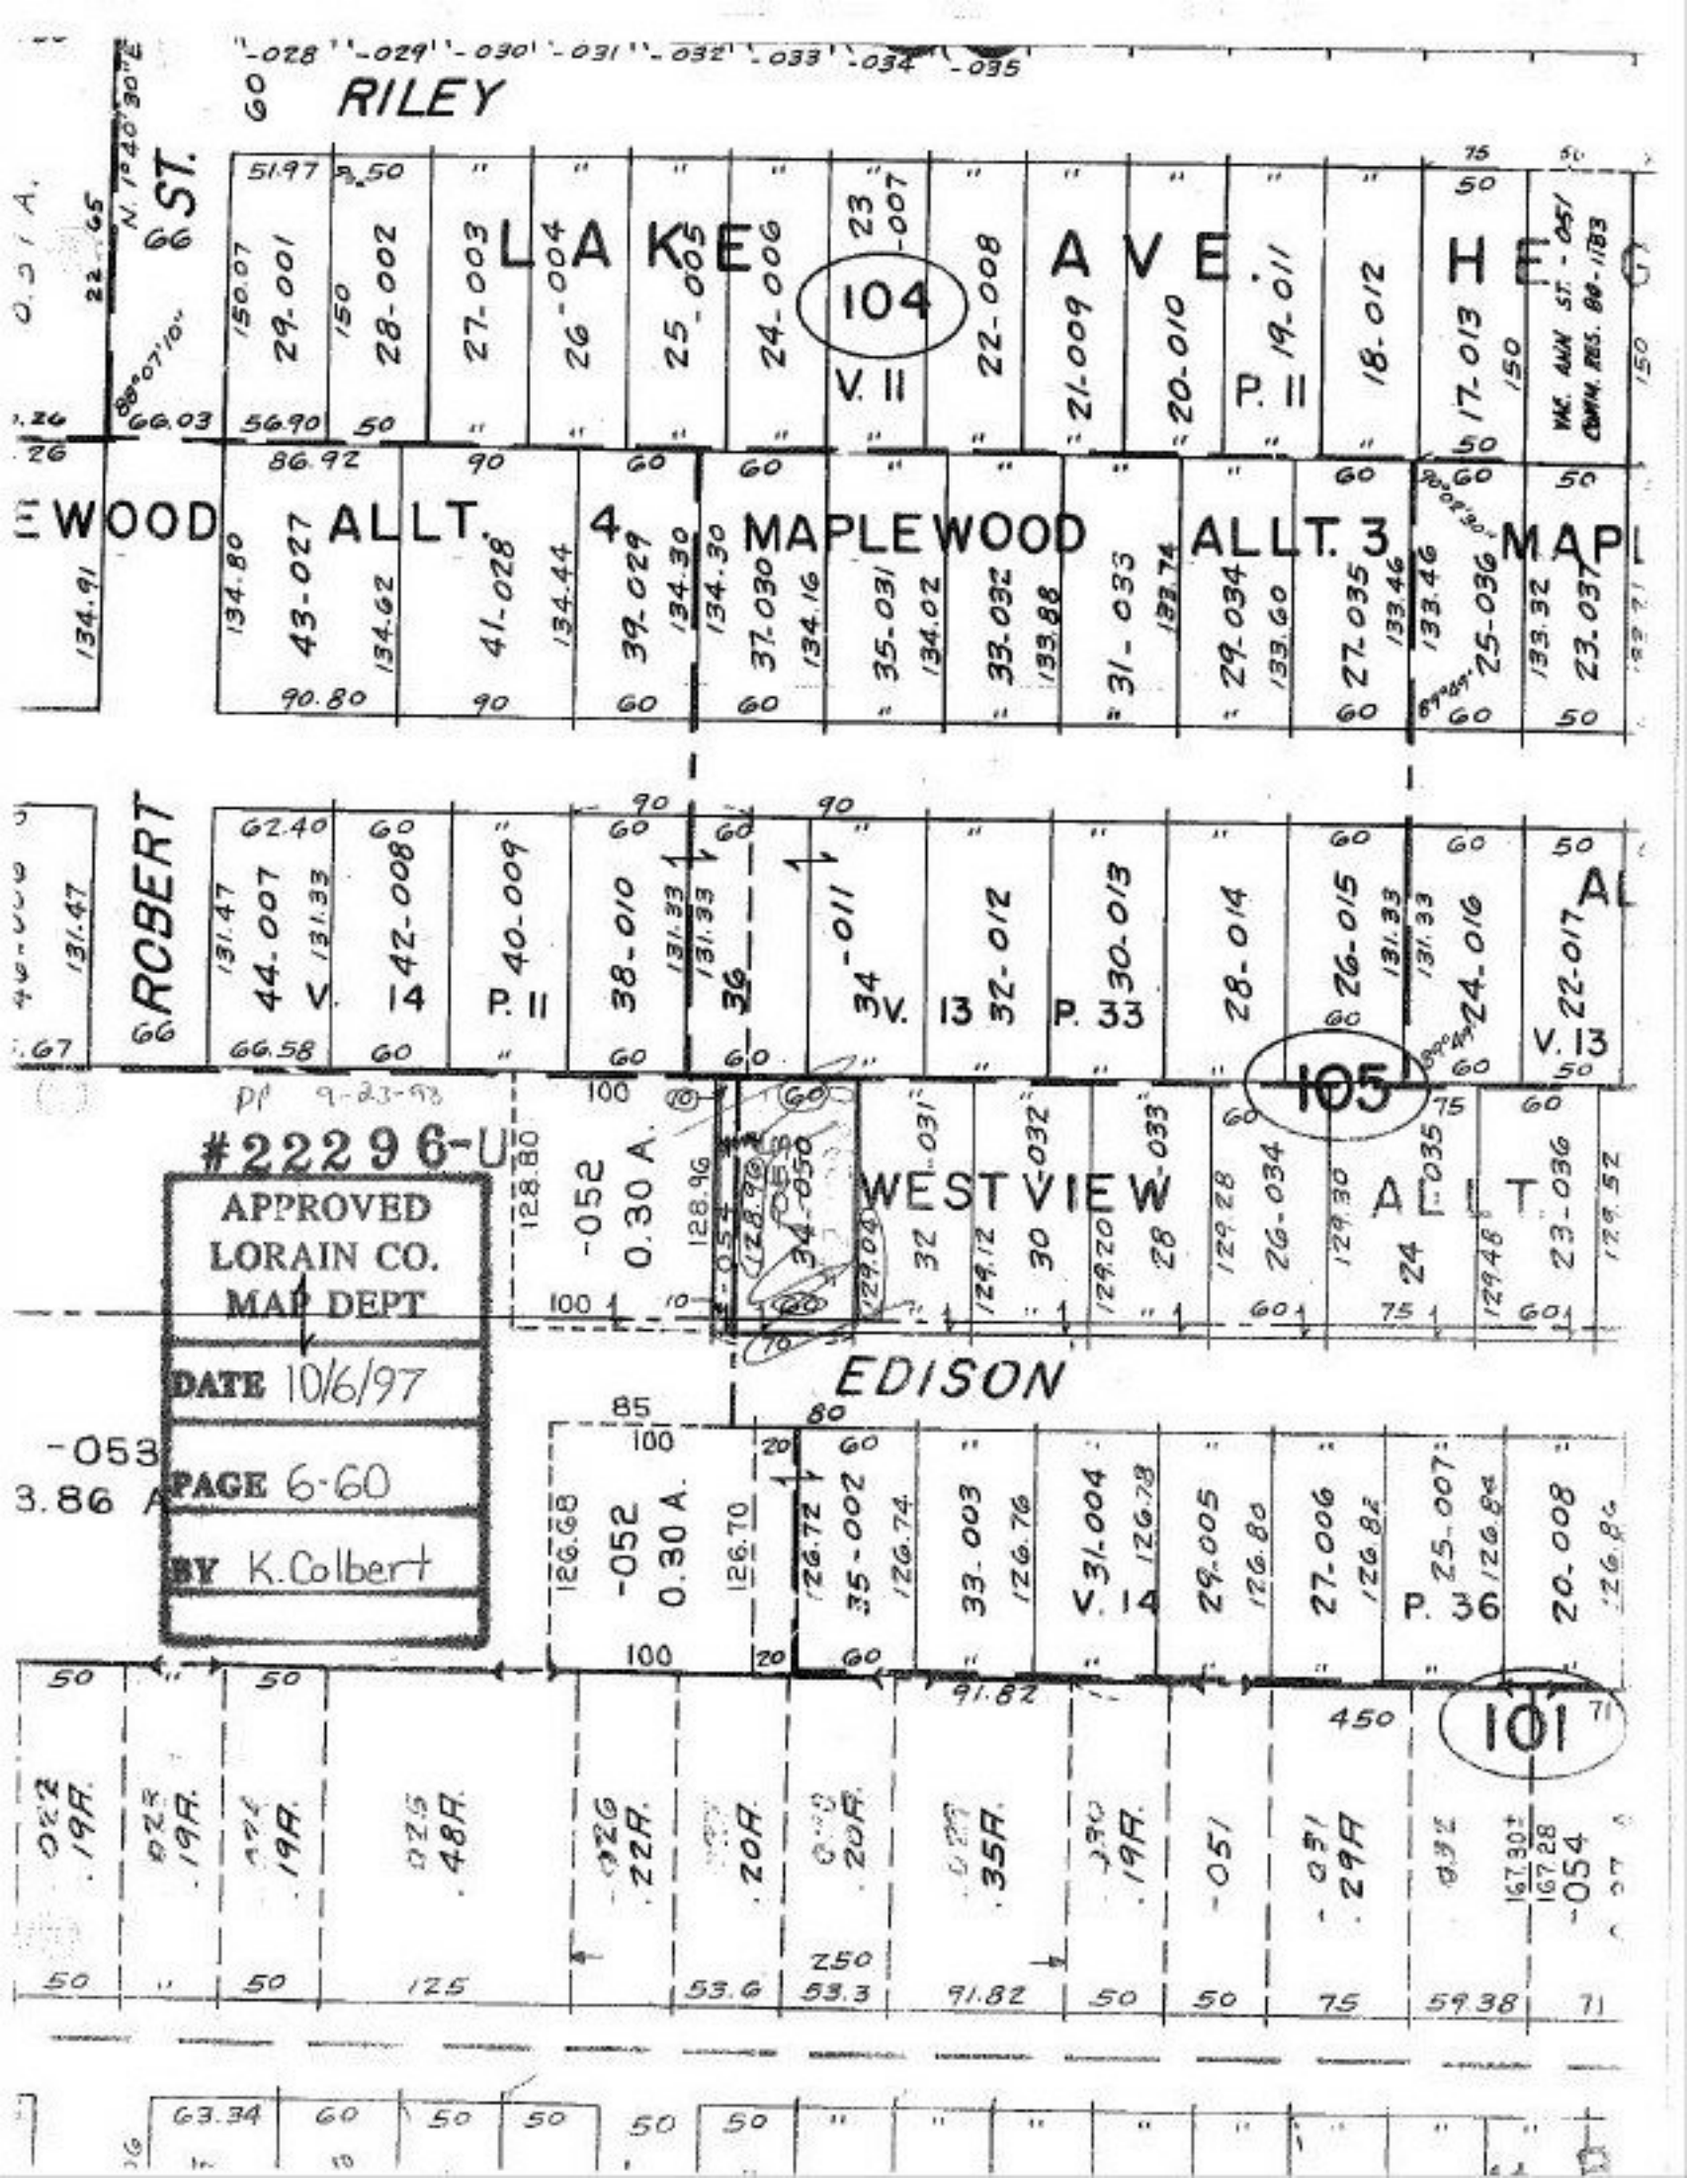
RILEY
ST.
LAKE
AVE
104
MAPLEWOOD ALLT. 4
MAPLEWOOD ALLT. 3
ROBERT
105
WEST VIEW
EDISON
101
#22296-U
APPROVED
LORAIN CO.
MAP DEPT
DATE 10/6/97
PAGE 6-60
BY K.Colbert