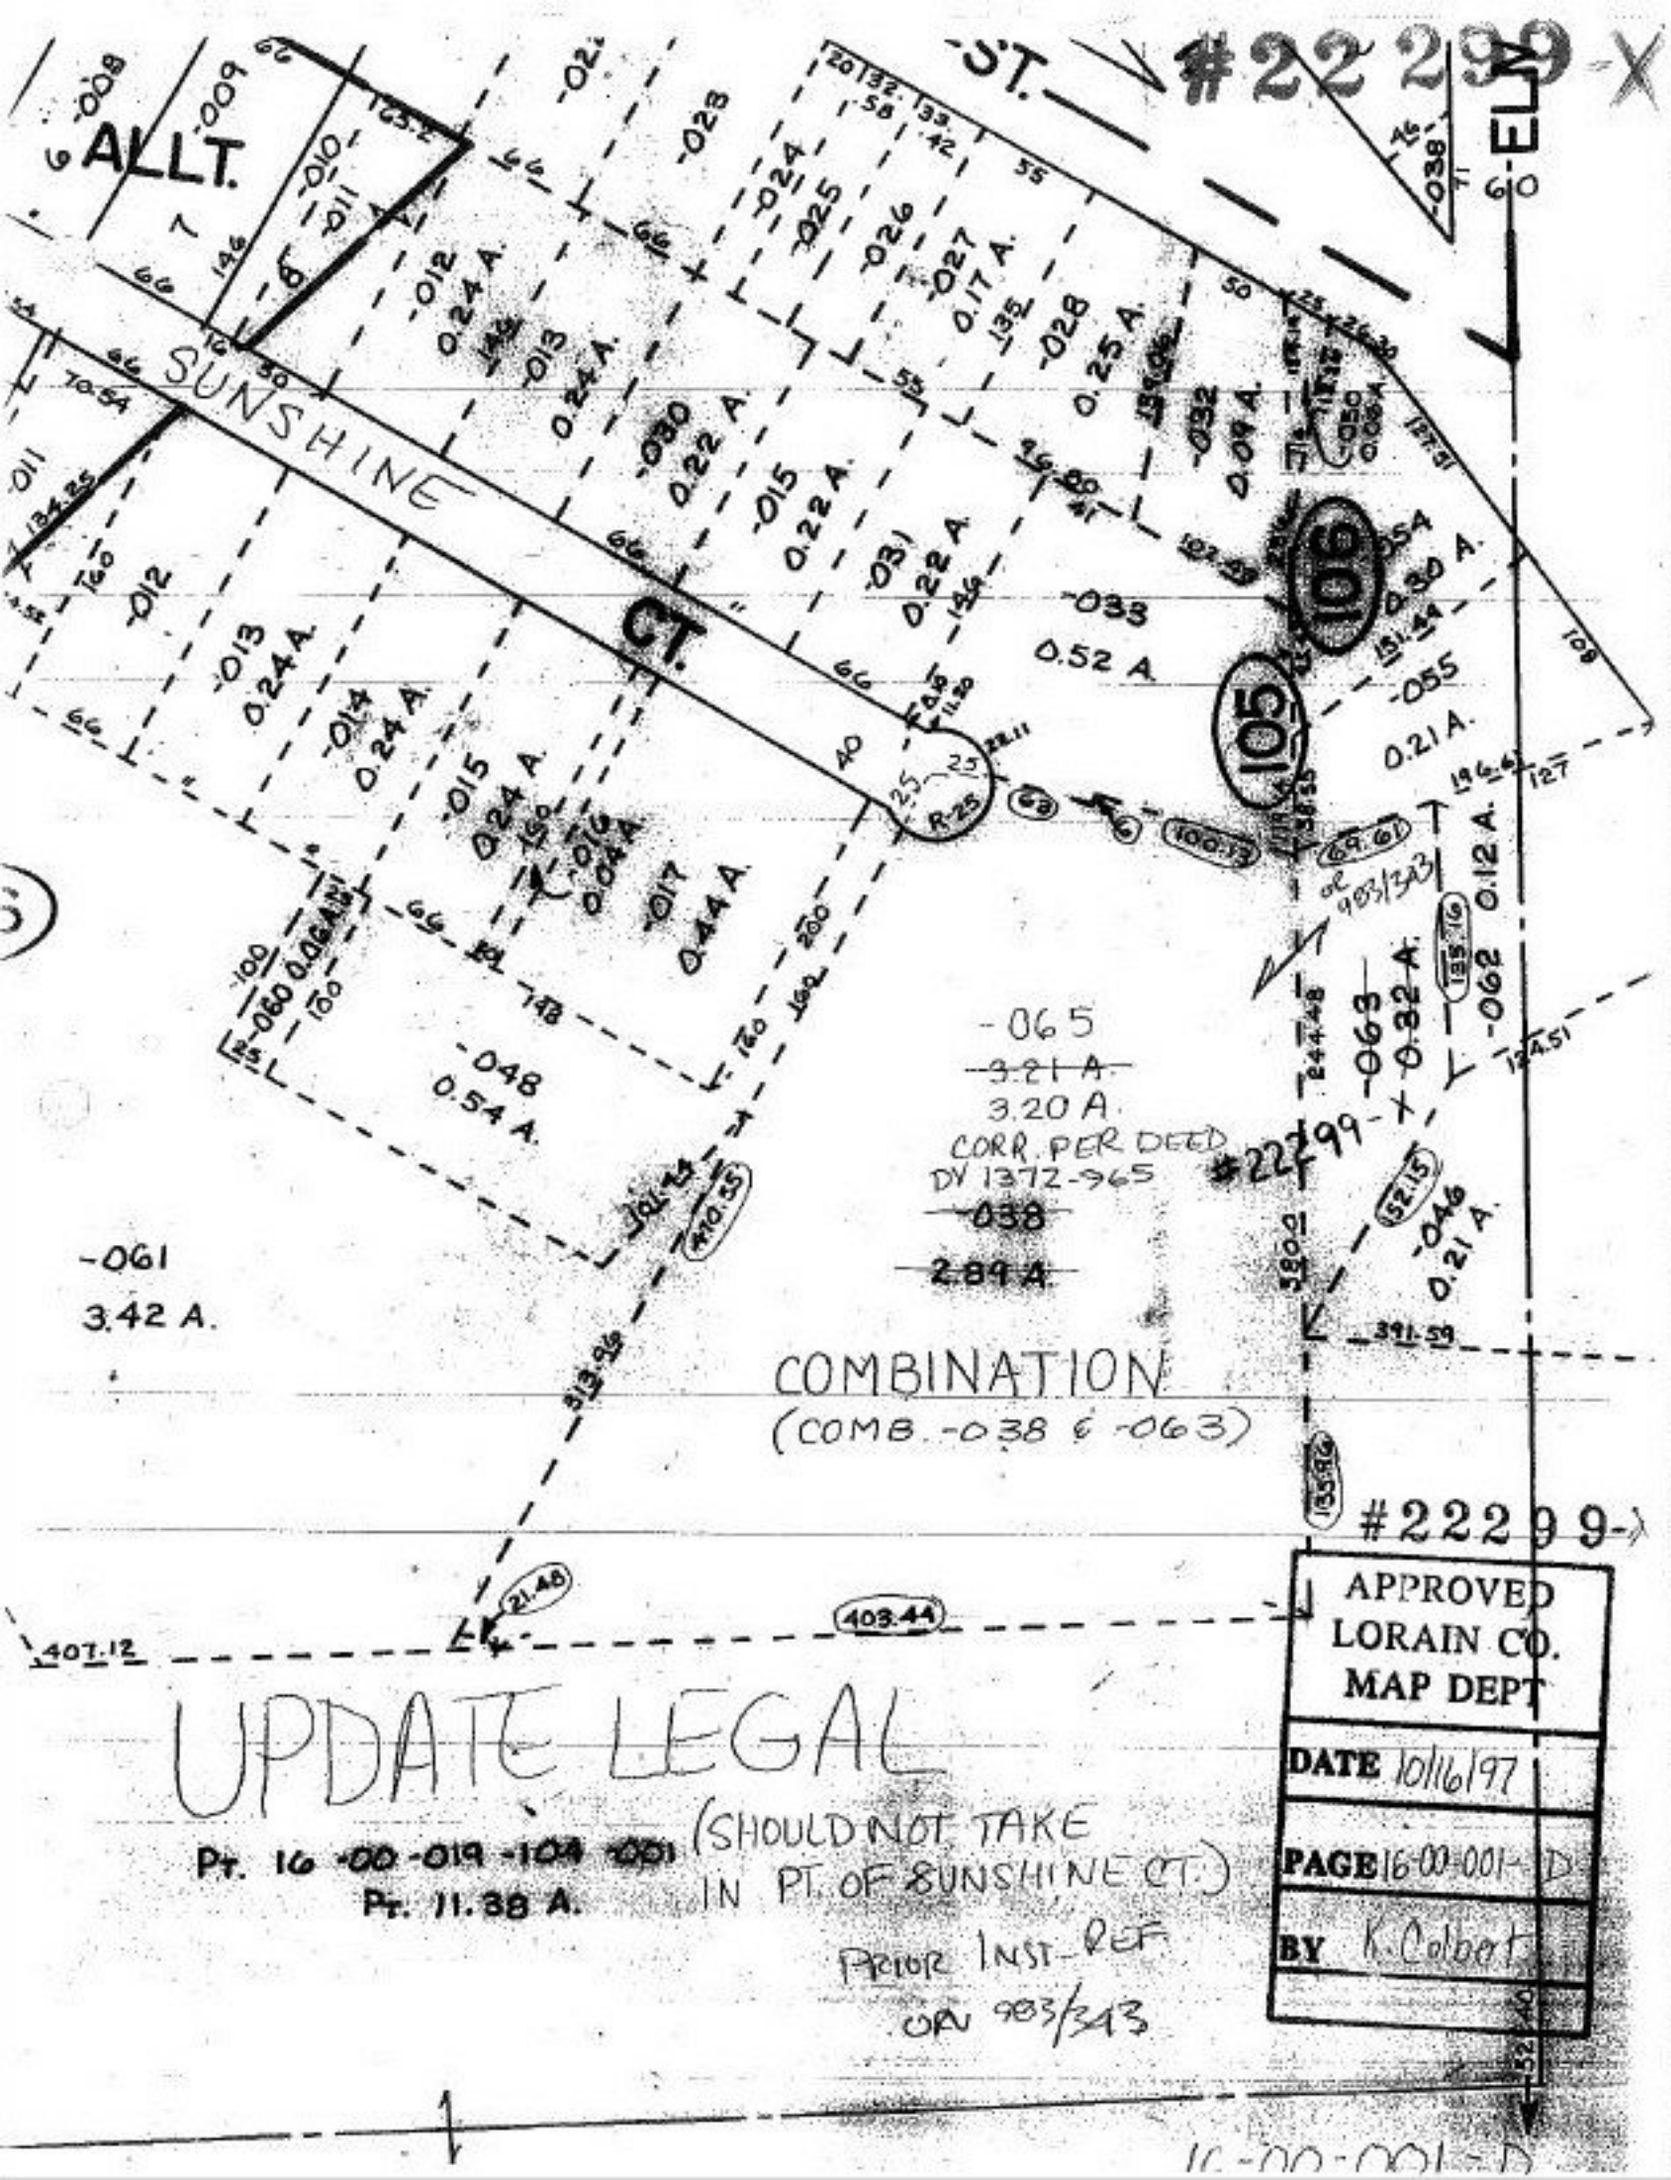
#22299-X
ALLT.
ST.
ELM
SUNSHINE
CT.
106
105
-033
0.52 A.
-055
0.21 A.
-062
0.12 A.
-063
0.32 A.
-065
~~3.21 A.~~
3.20 A.
CORR. PER DEED
DV 1372-965
~~-038~~
~~2.89 A.~~
-048
0.54 A.
-061
3.42 A.
COMBINATION
(COMB. -038 & -063)
#22299-X
APPROVED
LORAIN CO.
MAP DEPT
DATE 10/16/97
PAGE 16-00-001-D
BY K. Colbert
UPDATE LEGAL
Pt. 16-00-019-104-001
Pt. 11.38 A.
(SHOULD NOT TAKE
IN PT. OF SUNSHINE CT.)
PRIOR INST. REF
ORV 983/343
16-00-001-D