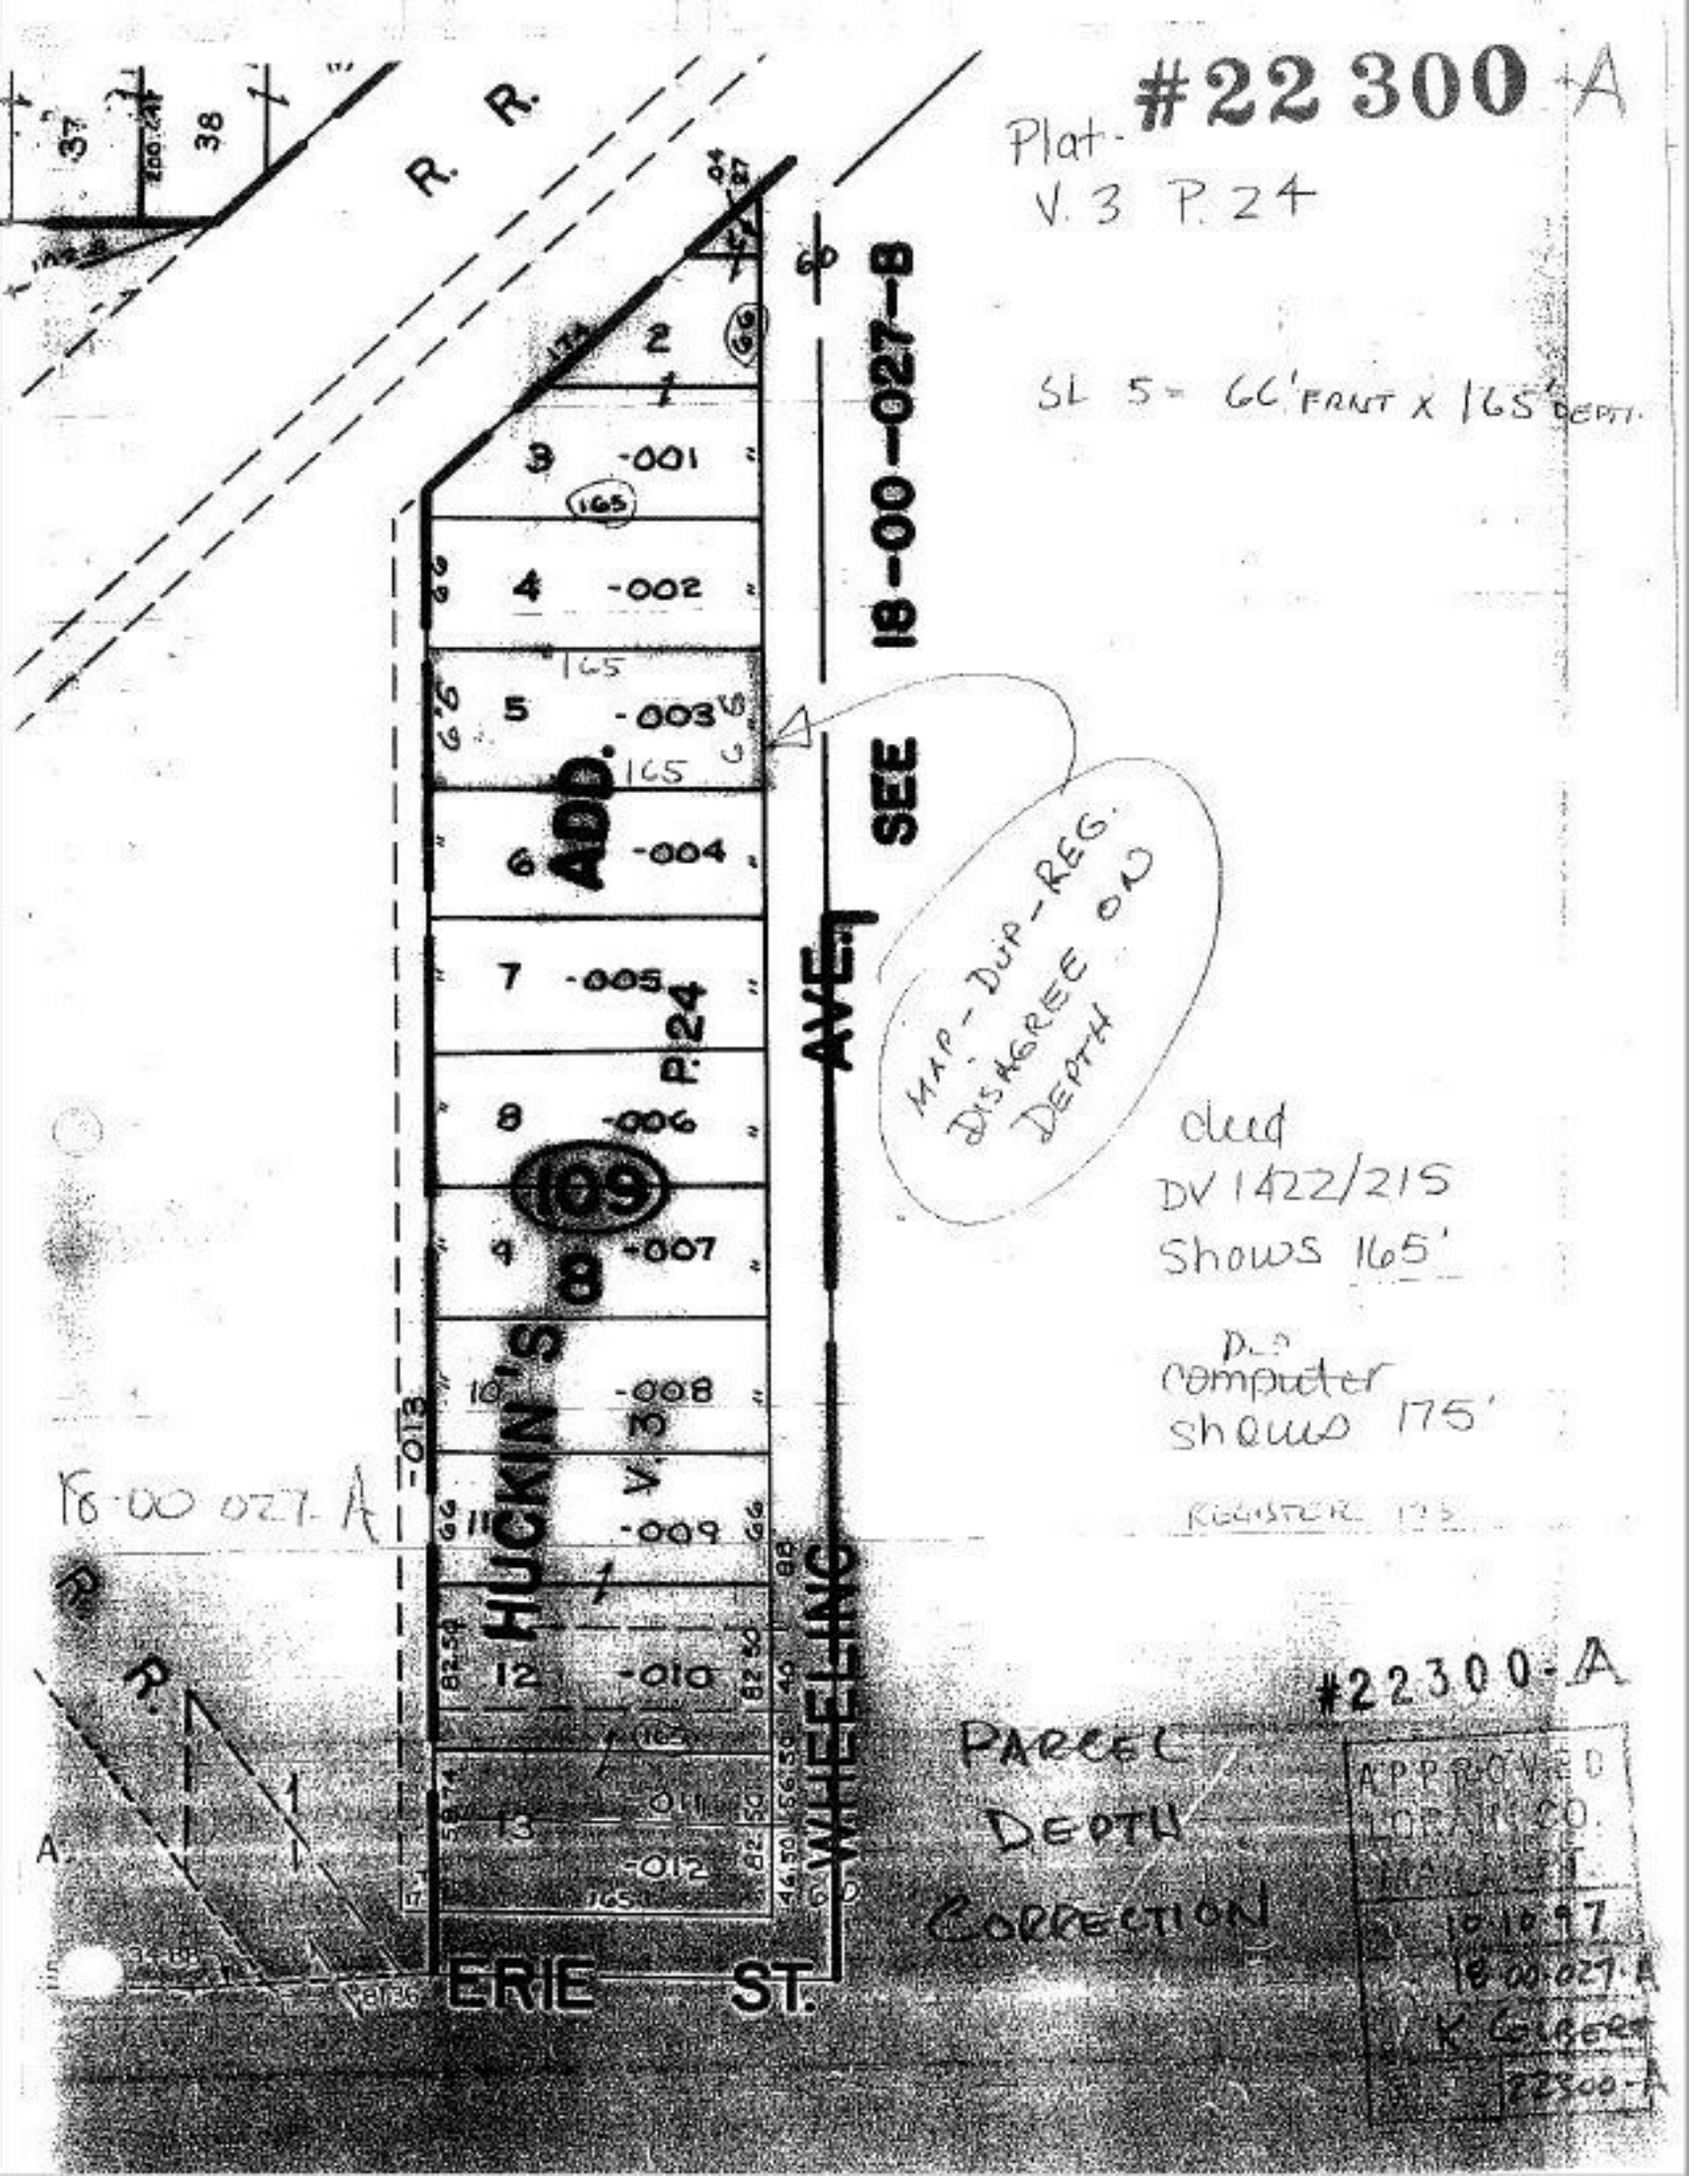
#22 300 A
Plat-
V. 3 P. 24
SL 5 = 66' FRNT x 165' DEPTH
R. R.
SEE 18-00-027-B
HUCKIN'S ADD.
V. 3 P. 24
109
8
WHEELING AVE.
ERIE ST.
MAP-DUP-REG. DISAGREE ON DEPTH
deed
DV 1422/215
Shows 165'
computer
shows 175'
REGISTER 175
18-00-027-A
#22300-A
PARCEL
DEPTH
CORRECTION
APPROVED
LORAIN CO.
10-10-97
18-00-027-A
K GILBERT
22300-A