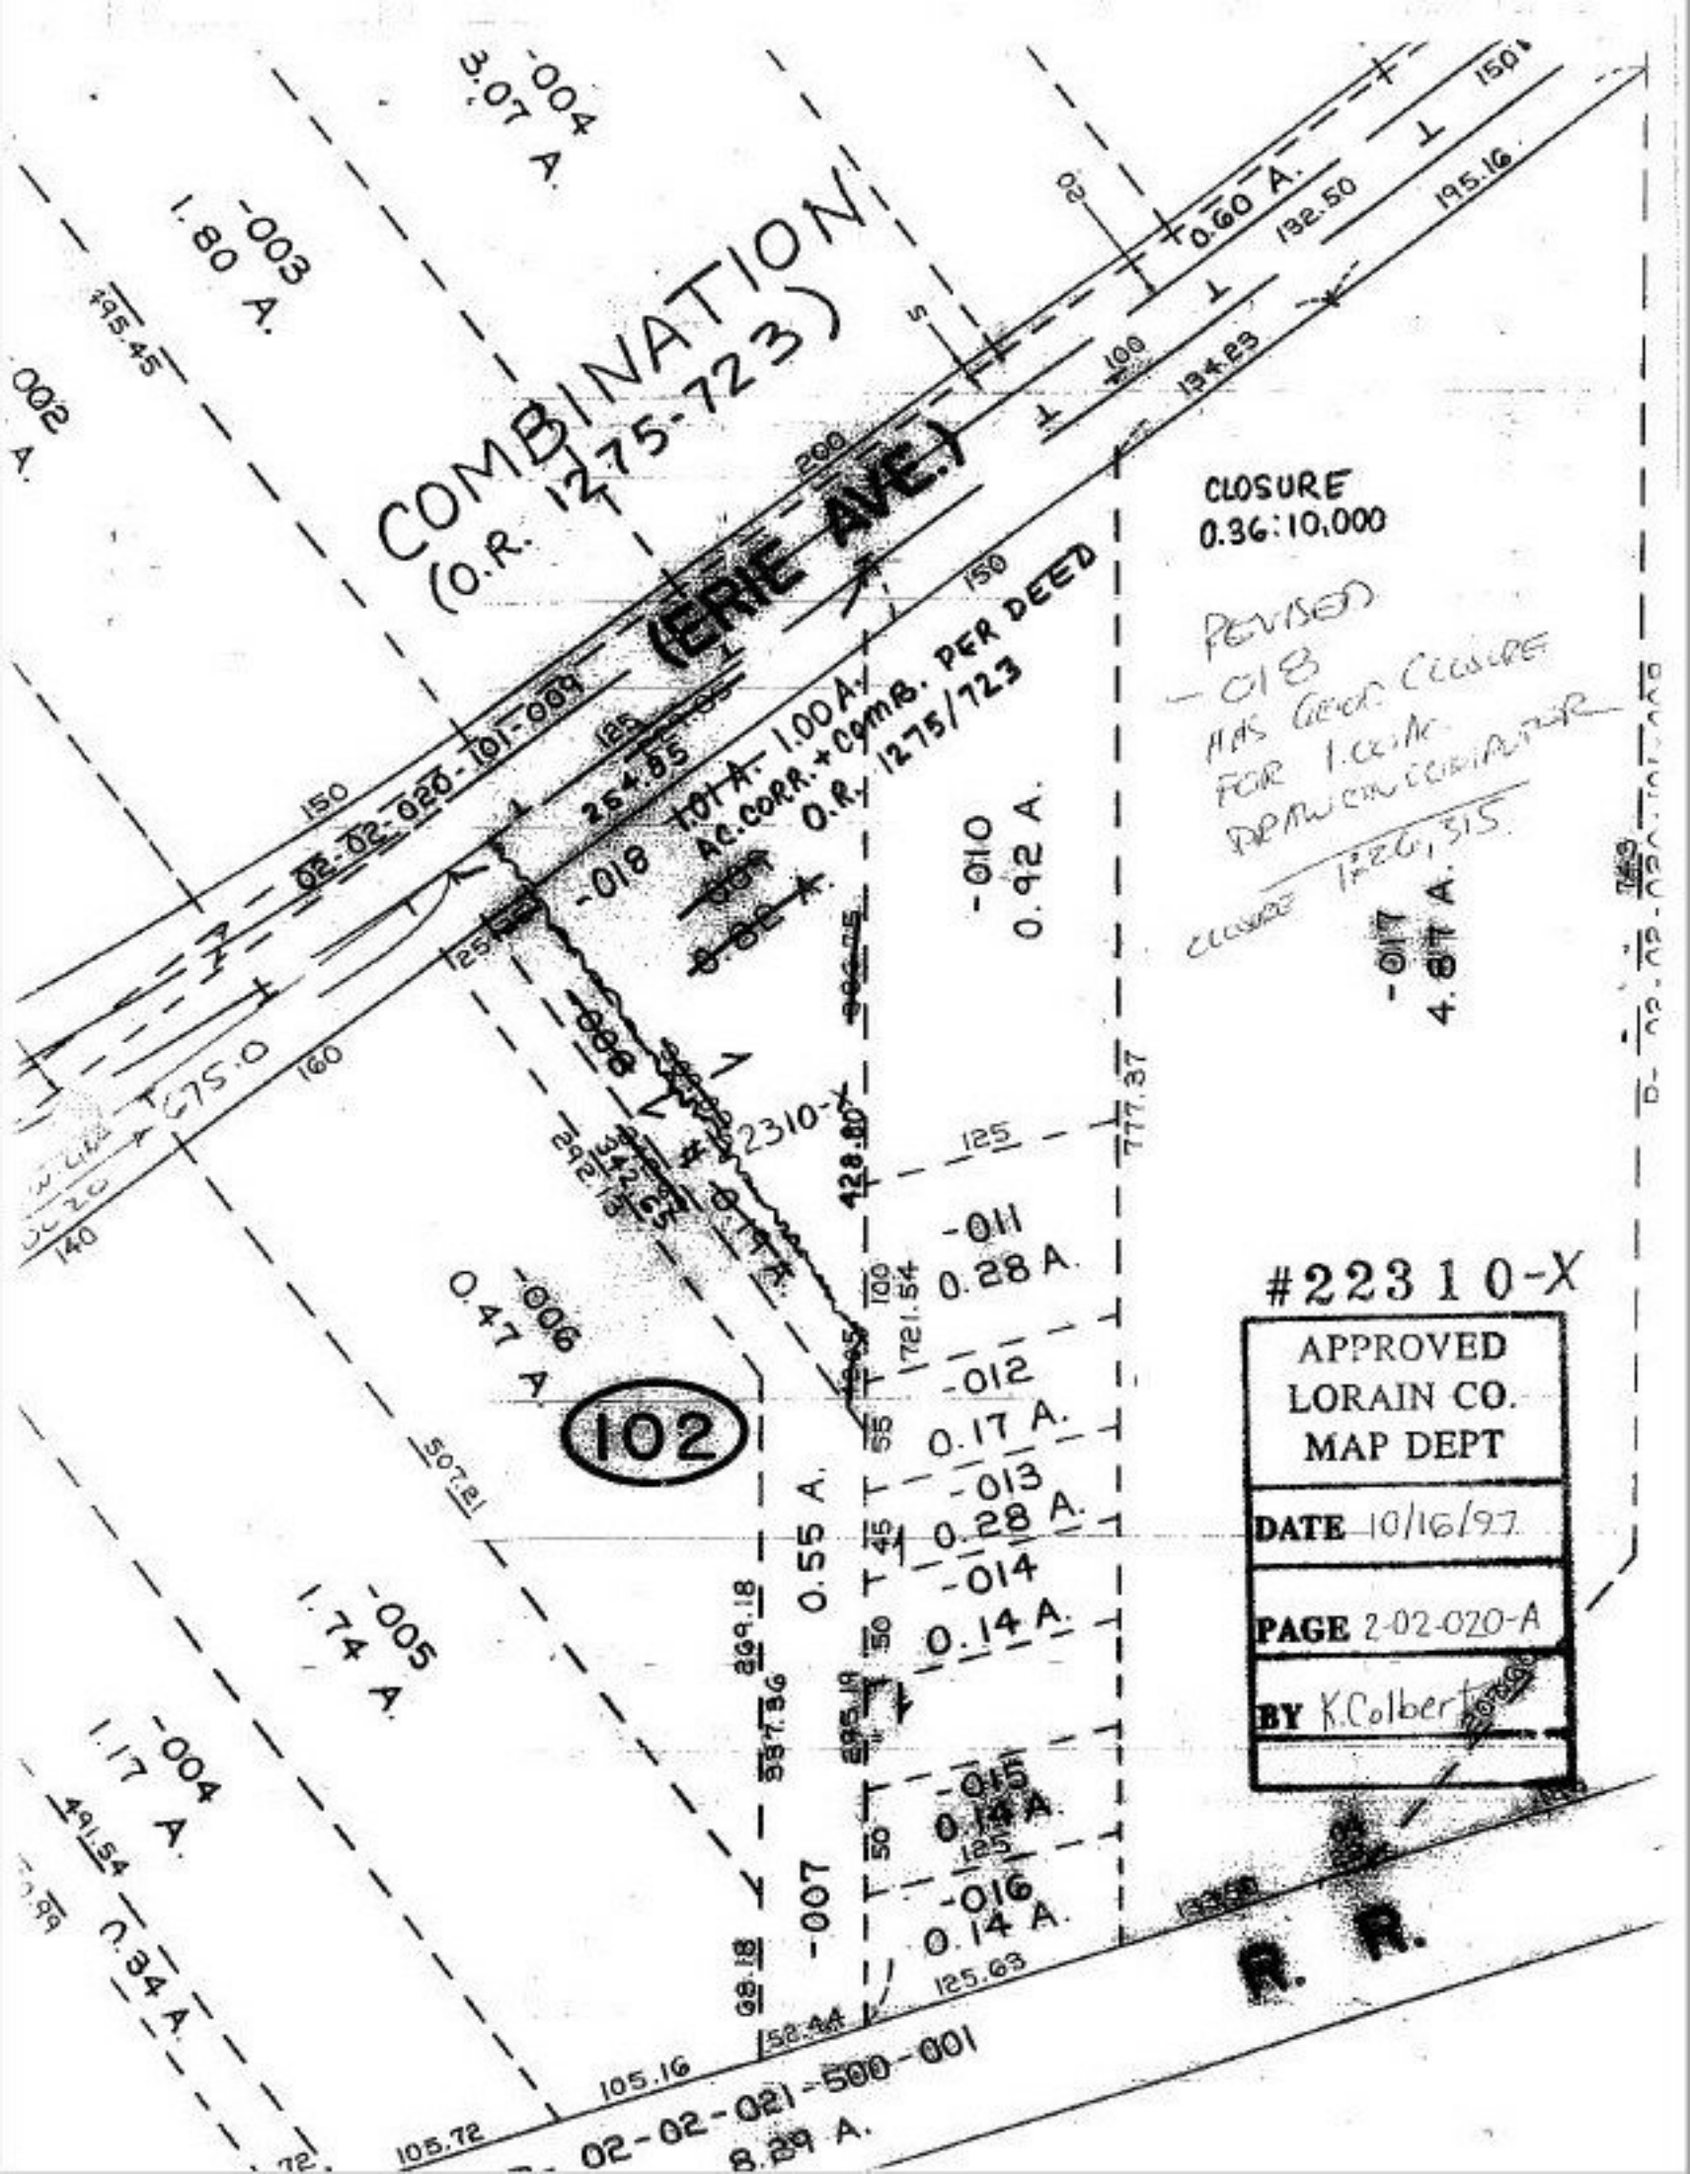
COMBINATION
(O.R. 1275-723)
(ERIE AVE.)
CLOSURE
0.36:10,000
REVISED
-018
HAS GOOD CLOSURE
FOR 1.00 AC.
DRAWN COMBINATION
#22310-X
APPROVED
LORAIN CO.
MAP DEPT
DATE 10/16/97
PAGE 2-02-020-A
BY K.Colbert
102
02-02-020-101-009
02-02-021-500-001
-018 1.01 A. 1.00 AC. CORR. + COMB. PER DEED O.R. 1275/723
-010 0.92 A.
-011 0.28 A.
-012 0.17 A.
-013 0.28 A.
-014 0.14 A.
-015 0.14 A.
-016 0.14 A.
-017 4.87 A.
-007 0.55 A.
-006 0.47 A.
-005 1.74 A.
-004 1.17 A.
-003 1.80 A.
-004 3.07 A.
0.60 A.
0.34 A.
8.29 A.
R. R.