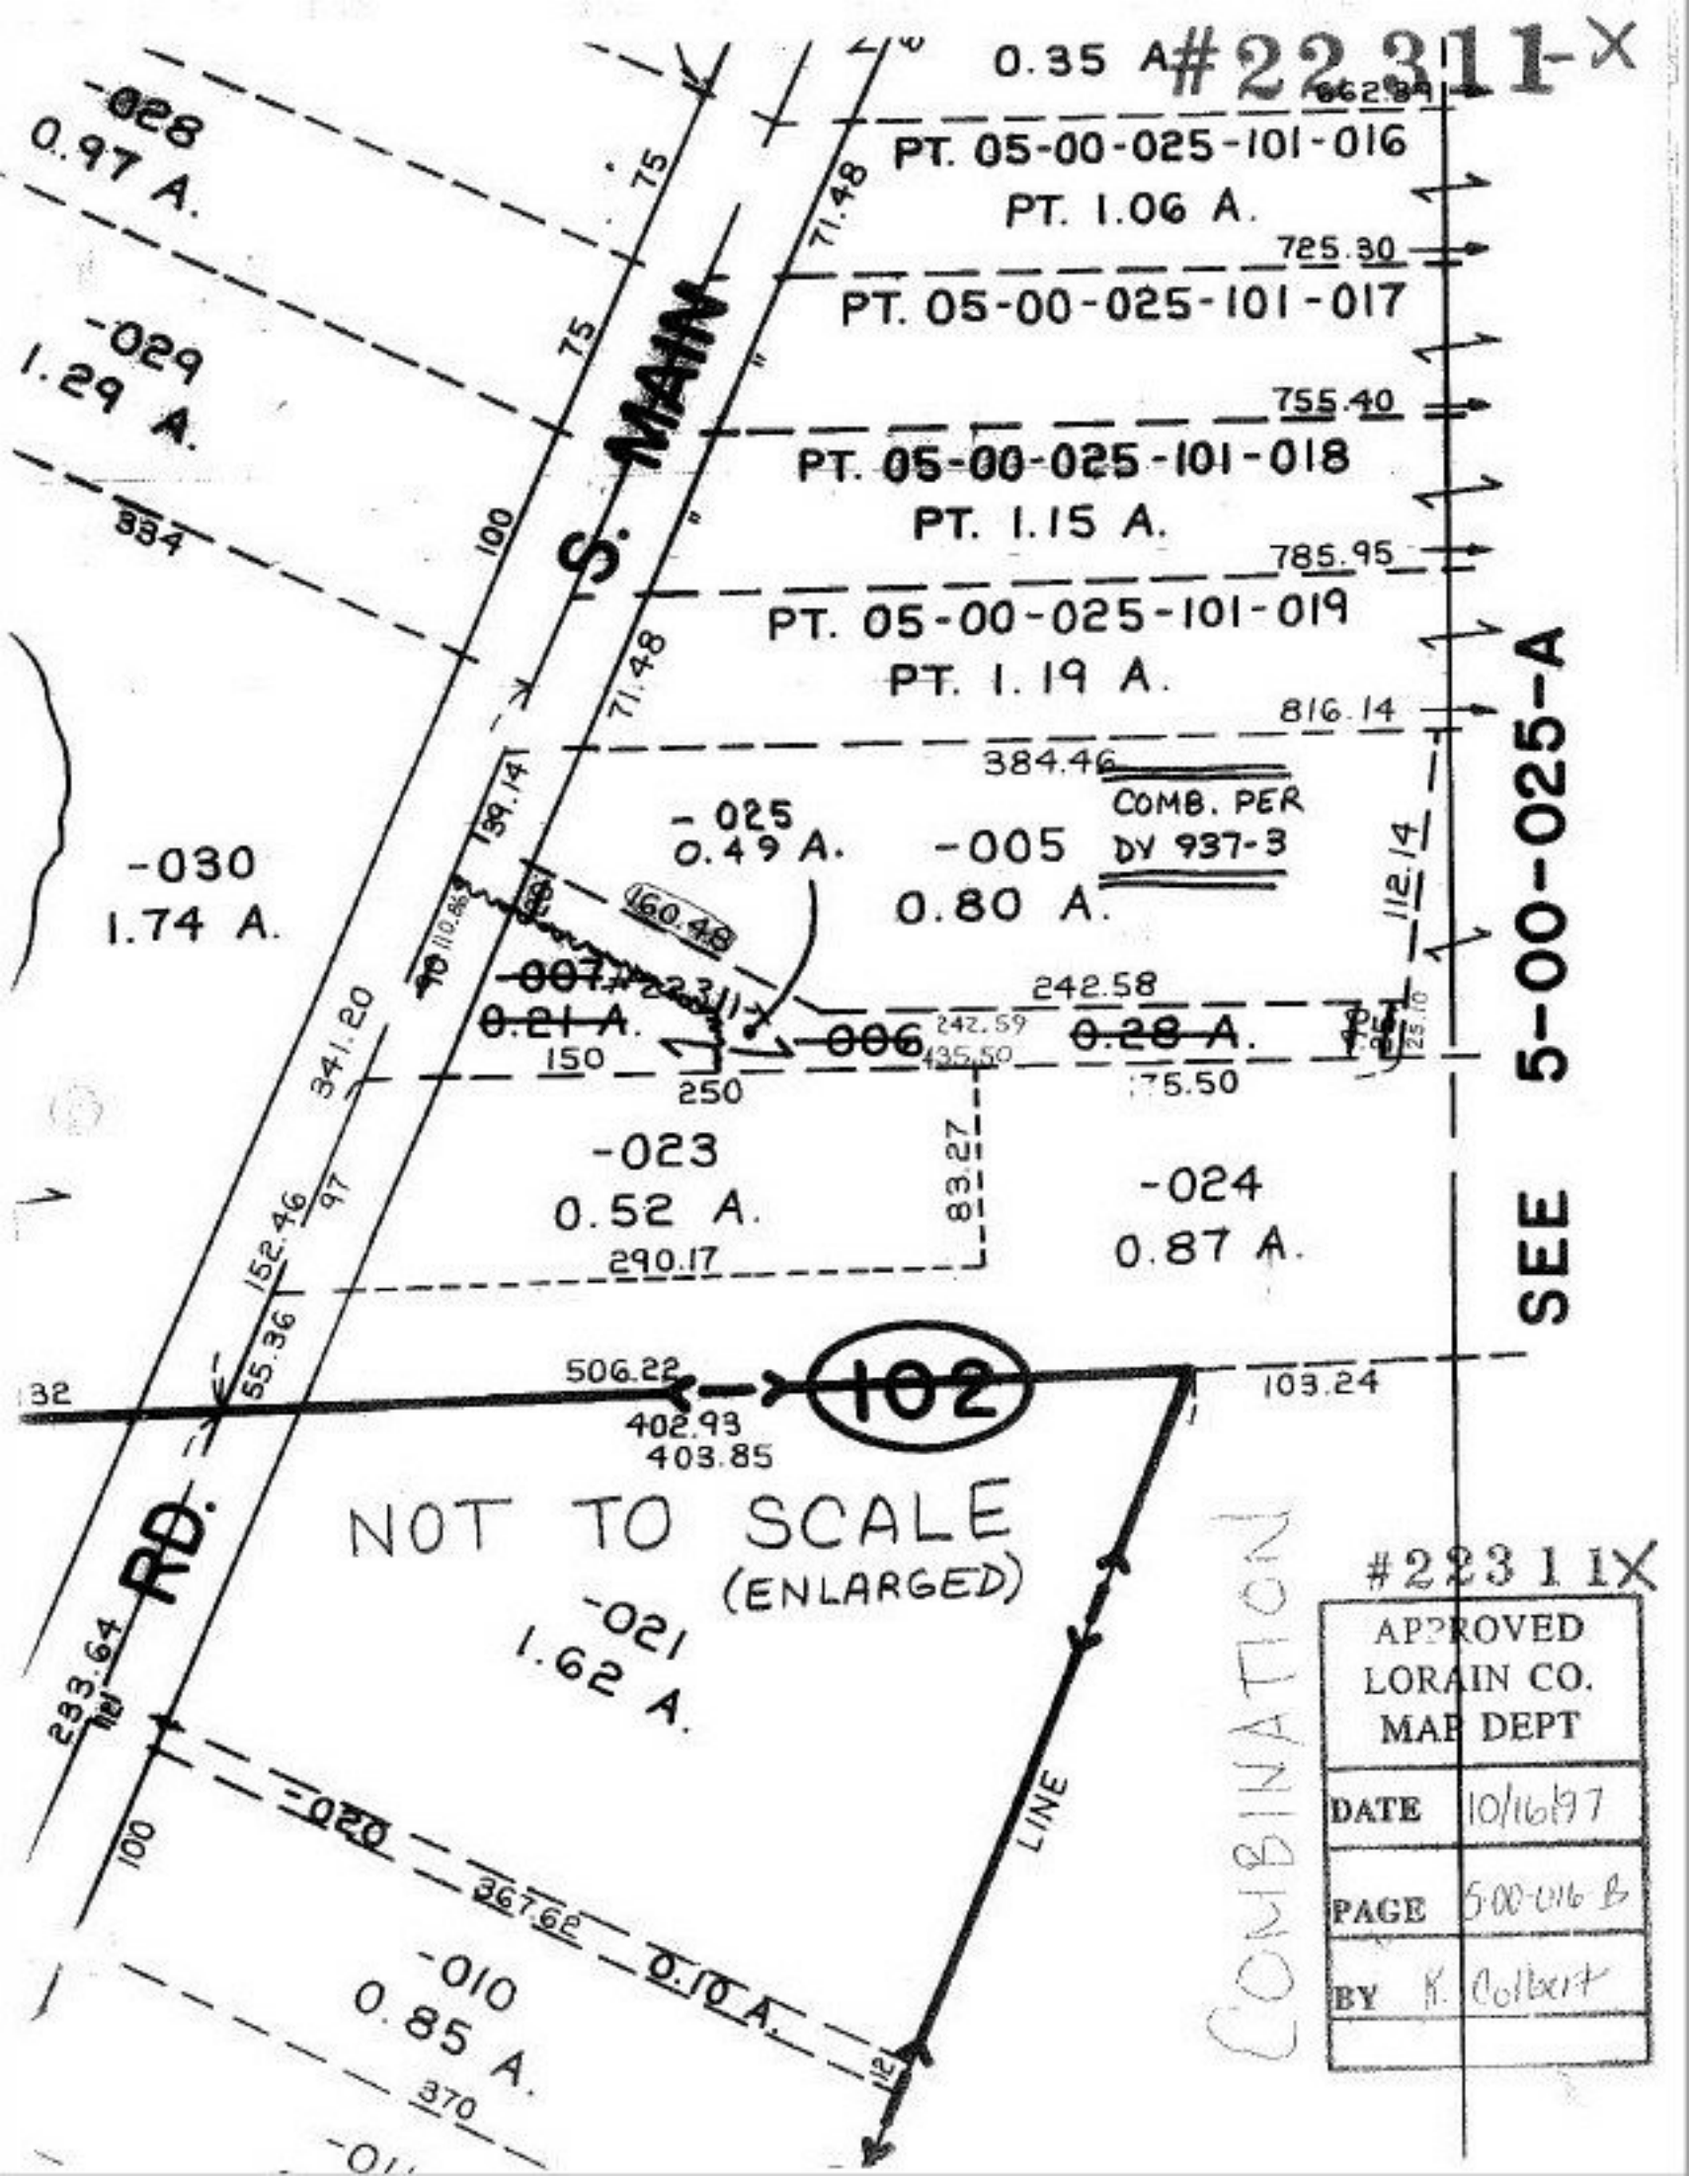
#22311-X
0.35 A
PT. 05-00-025-101-016
PT. 1.06 A.
PT. 05-00-025-101-017
PT. 05-00-025-101-018
PT. 1.15 A.
PT. 05-00-025-101-019
PT. 1.19 A.
-028
0.97 A.
-029
1.29 A.
-030
1.74 A.
-025
0.49 A.
-005
0.80 A.
COMB. PER DV 937-3
-007
0.21 A.
-006
0.28 A.
-023
0.52 A.
-024
0.87 A.
-021
1.62 A.
-020
0.10 A.
-010
0.85 A.
S. MAIN
RD.
102
SEE 5-00-025-A
NOT TO SCALE
(ENLARGED)
COMBINATION LINE
#22311X
APPROVED
LORAIN CO.
MAP DEPT
DATE 10/16/97
PAGE 5-00-016 B
BY K. Colbert