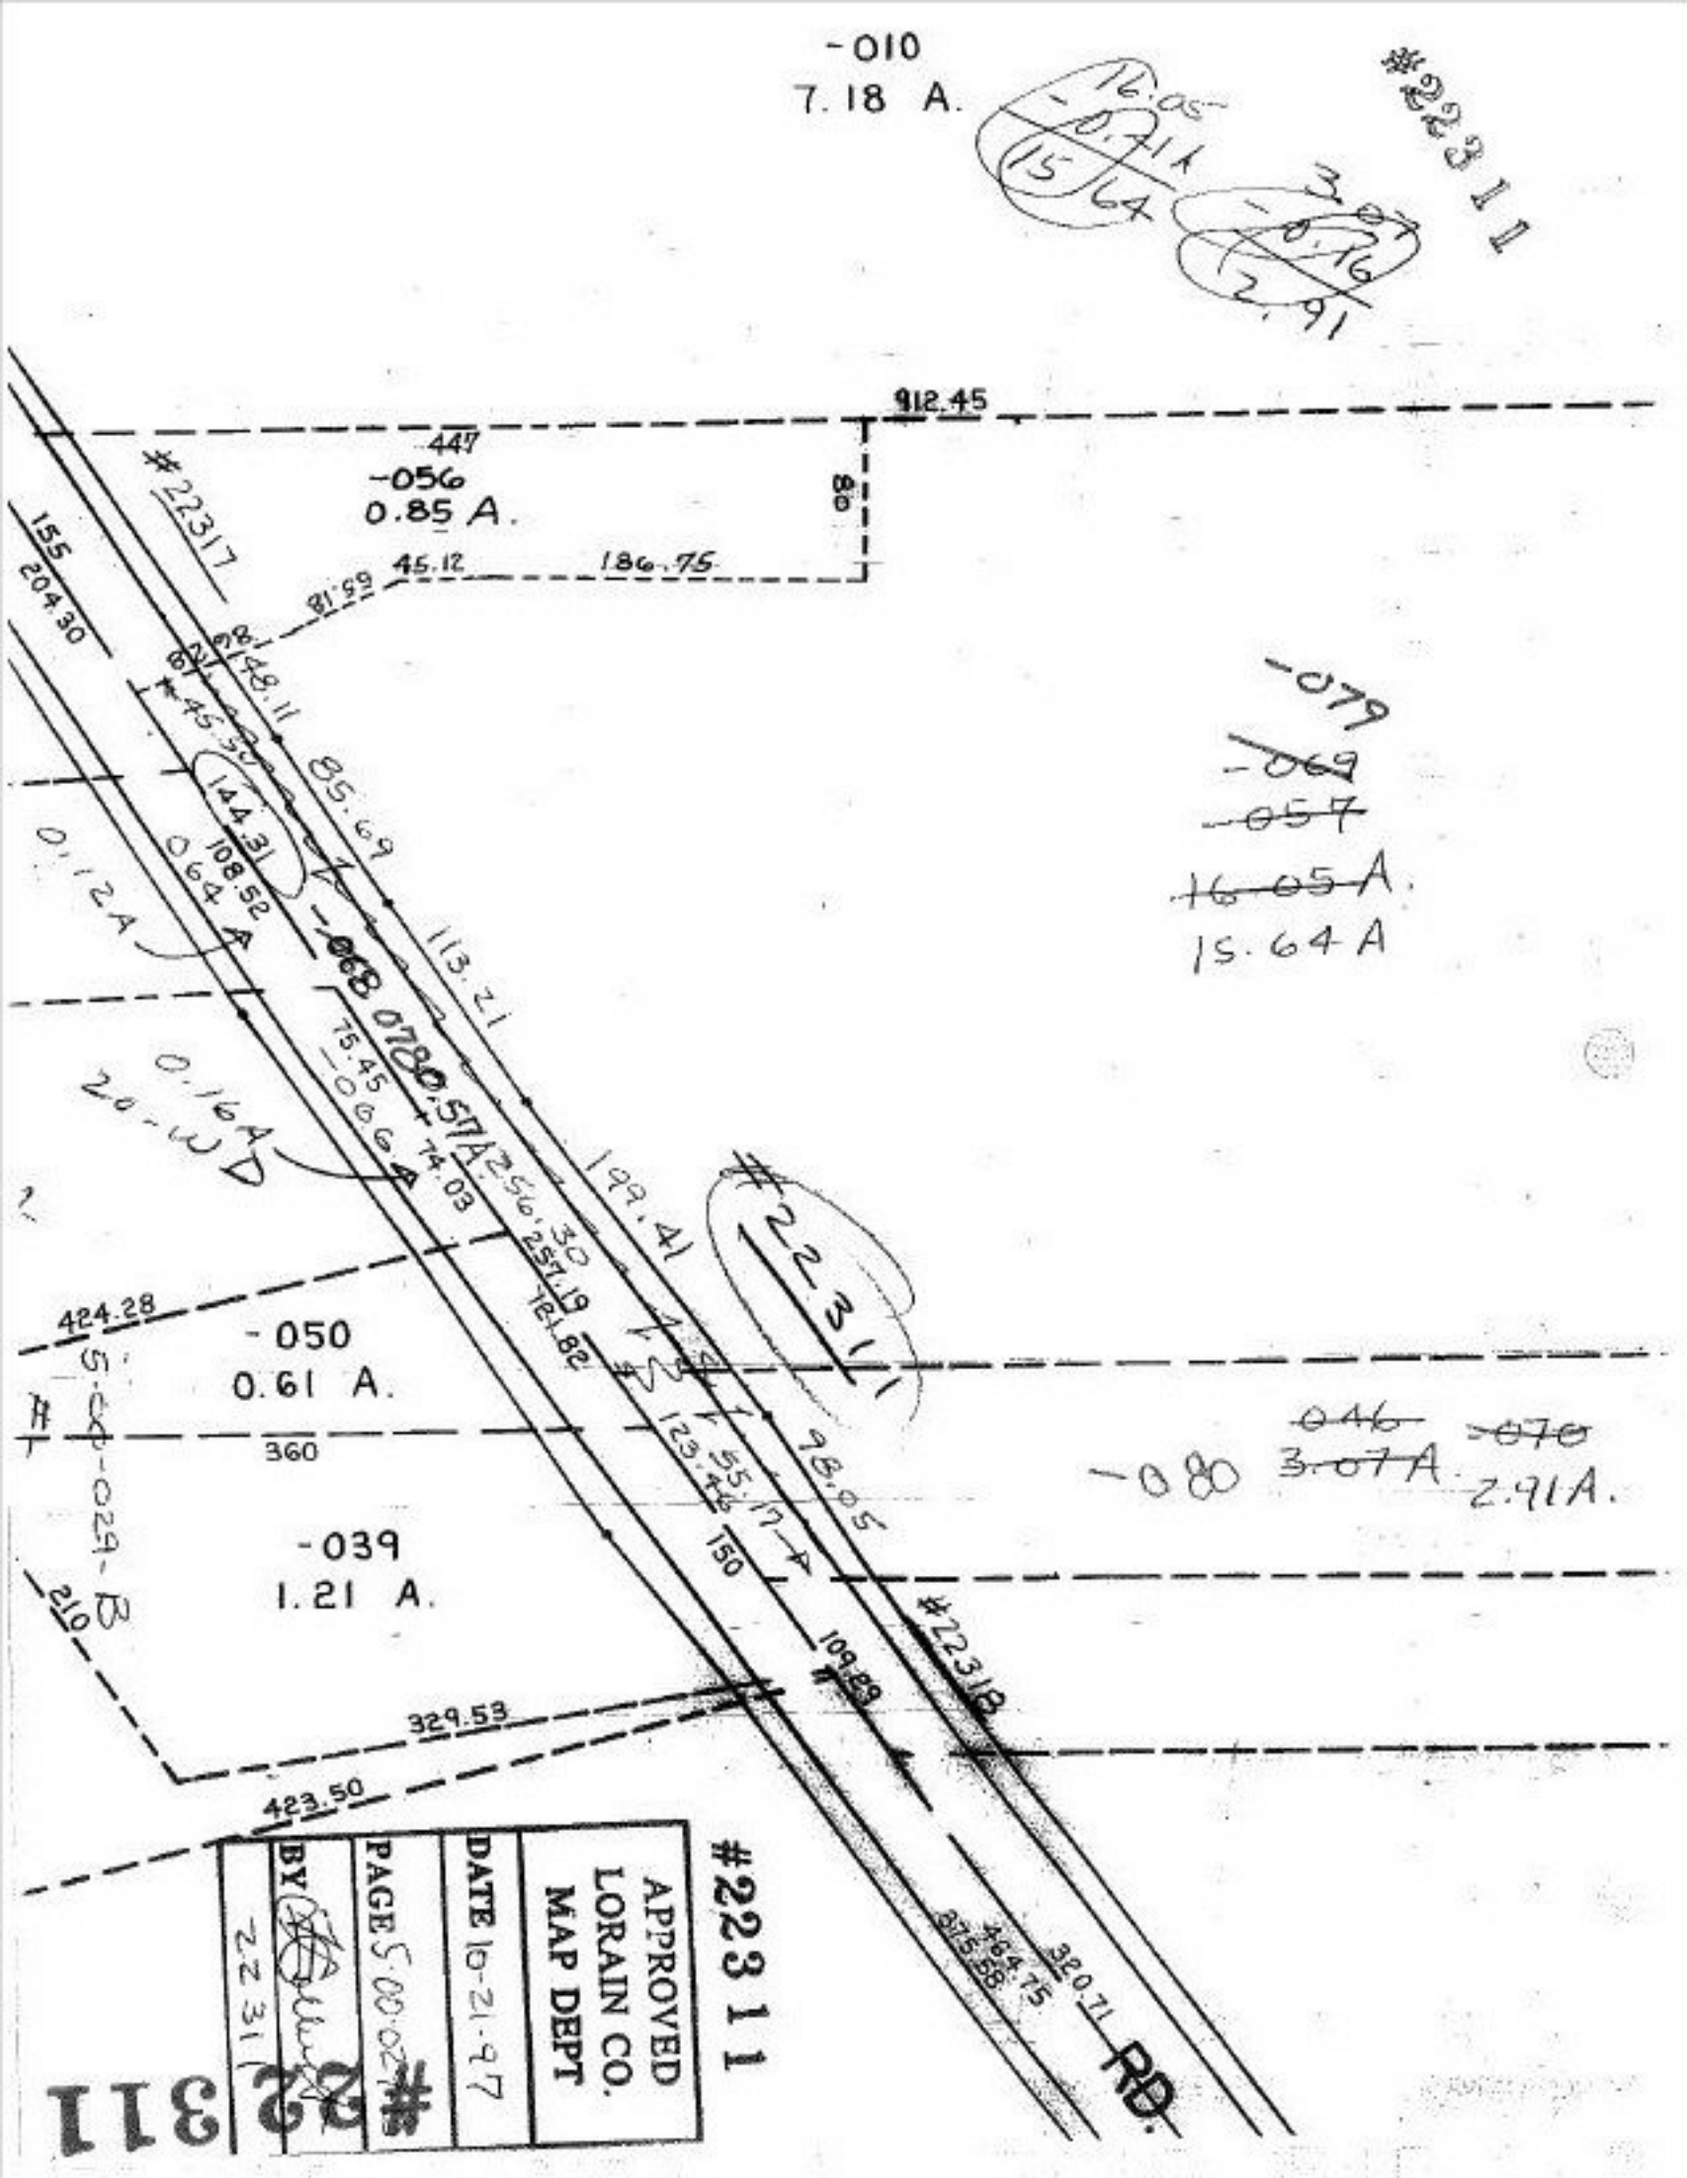
-010
7.18 A.
#22311
16.05
-071A
15.64
3.07
-076
2.91
912.45
447
-056
0.85 A.
80
#22317
155
204.30
45.12
186.75
81.99
81.48.11
85.69
144.31
108.52
0.64 A
0.12A
-068
0780.57A
256.30
257.19
121.82
113.21
199.41
75.45
74.03
0.64A
0.16A
20-JD
424.28
-050
0.61 A.
360
S-CK-029-B
210
-039
1.21 A.
#22311
98.05
55.17
123.46
150
109.89
#22318
329.53
423.50
-079
-069
-057
16.05A.
15.64A
-080
-046
3.07A
-070
2.91A.
464.75
875.58
320.71
RD.
APPROVED
LORAIN CO.
MAP DEPT
DATE 10-21-97
PAGE 5.00.02
BY
22311
#22311
22311