#22 312

#22312

5-00-033-A

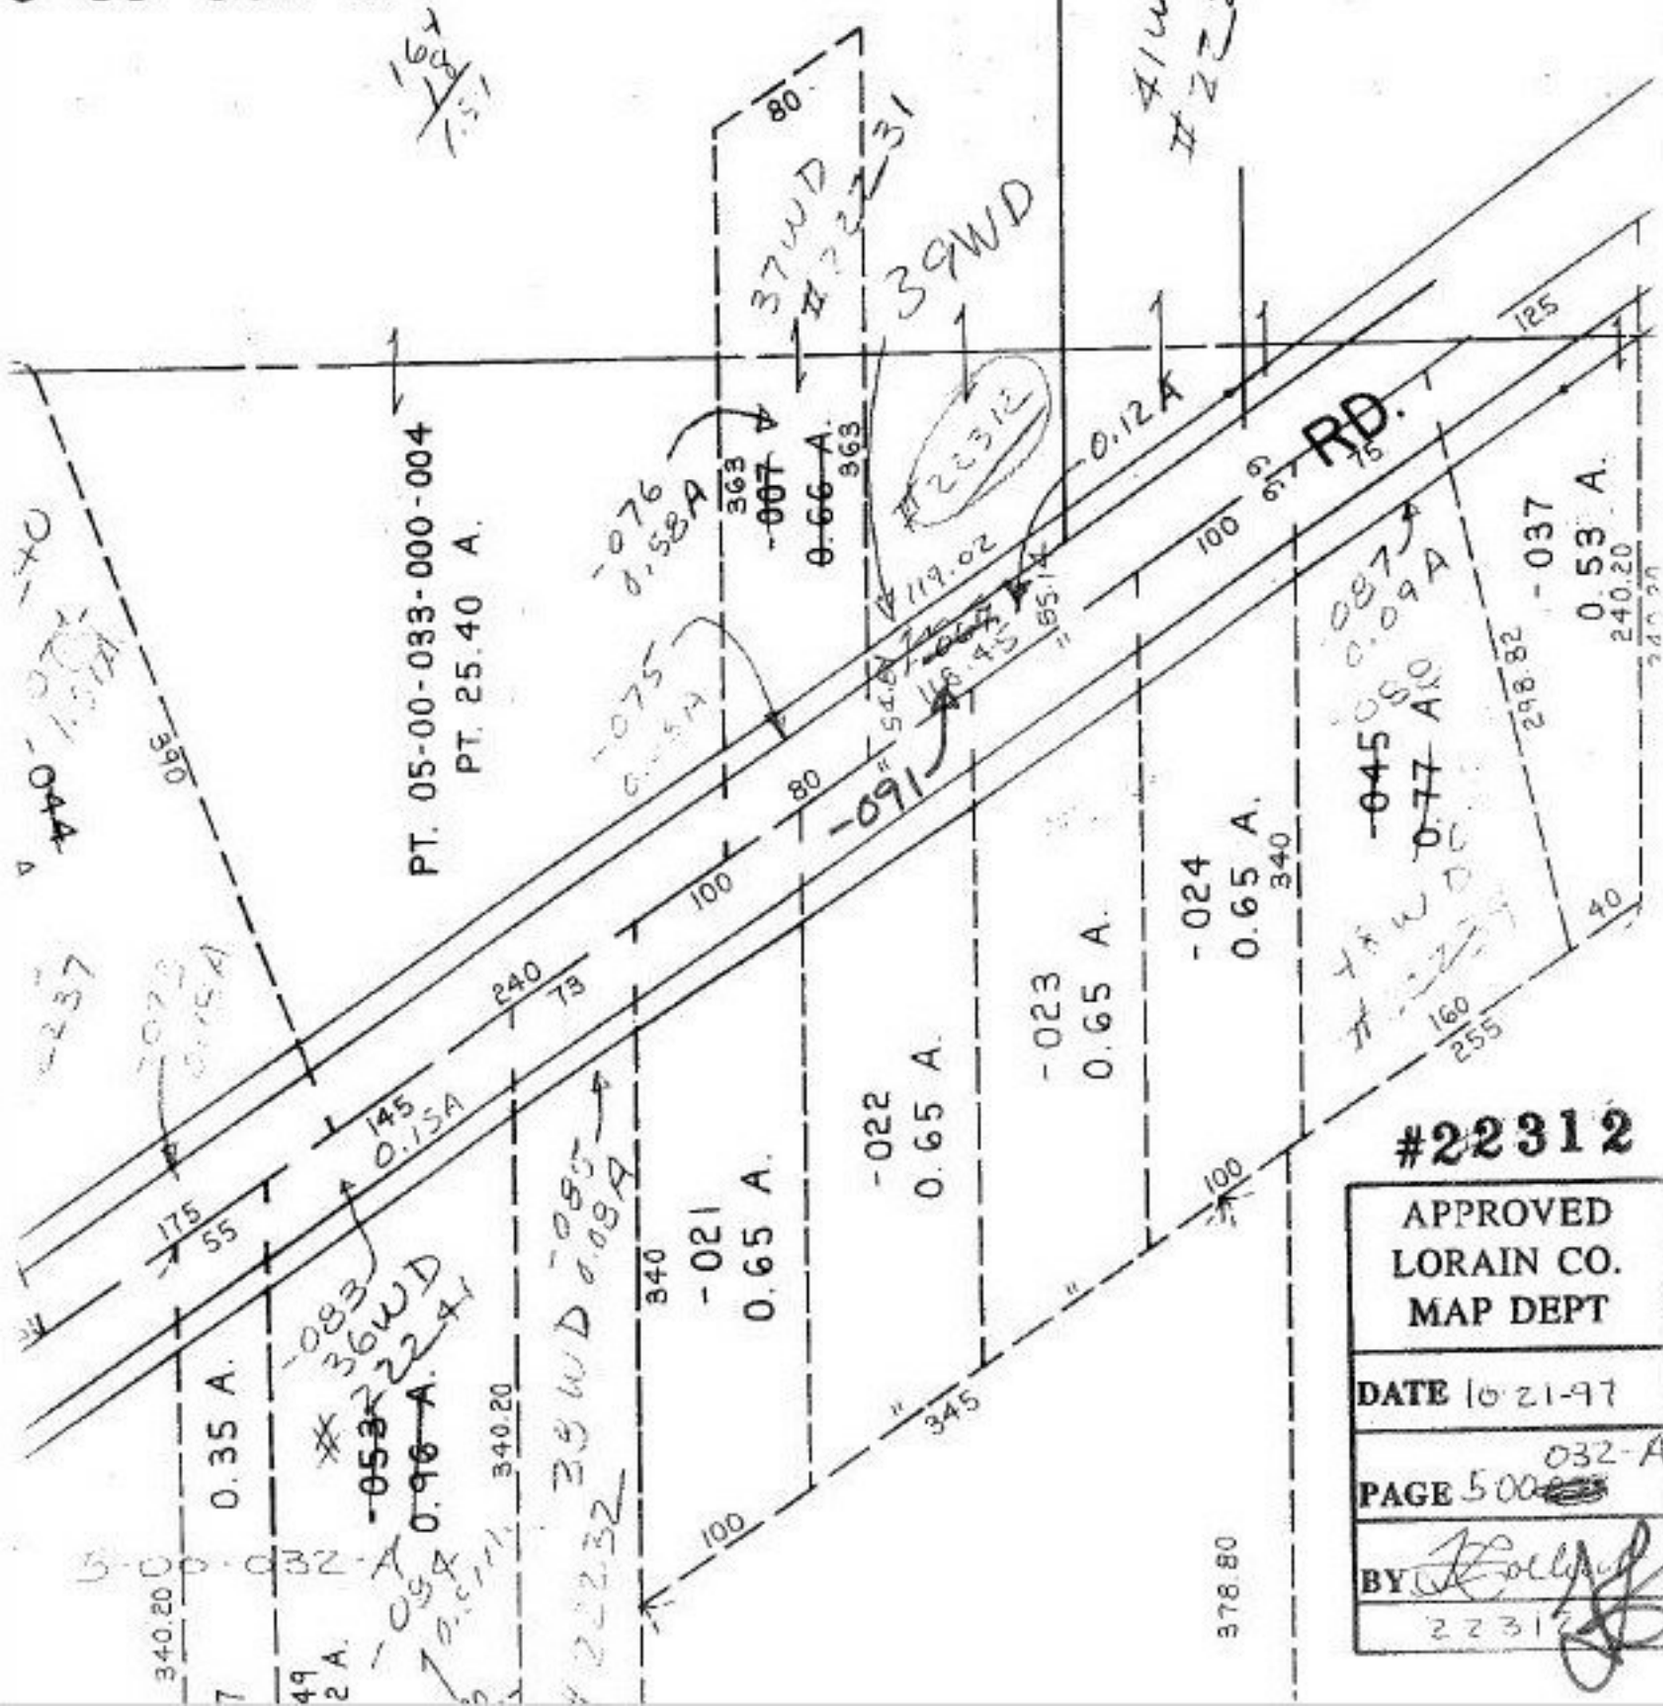

#22312

APPROVED
LORAIN CO.
MAP DEPT

DATE 10-21-97

PAGE 500 032-A

BY [signature]

22312