


#22312

#22312

2-A

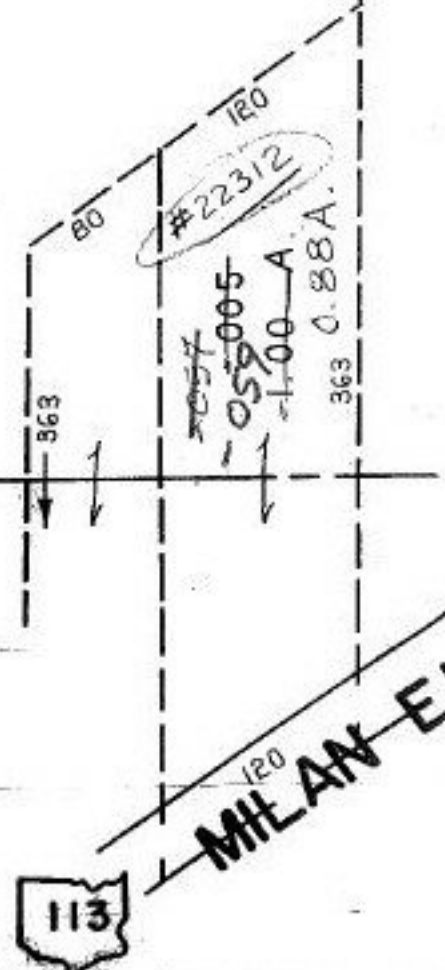

AMHERST TWP

SCALE 1"=100'

#22312

APPROVED ORAIN CO. MAP DEPT
DATE 10-2-97
PAGE 5-0-33 A
BY <i>[Signature]</i>
22312

5-00-033-A