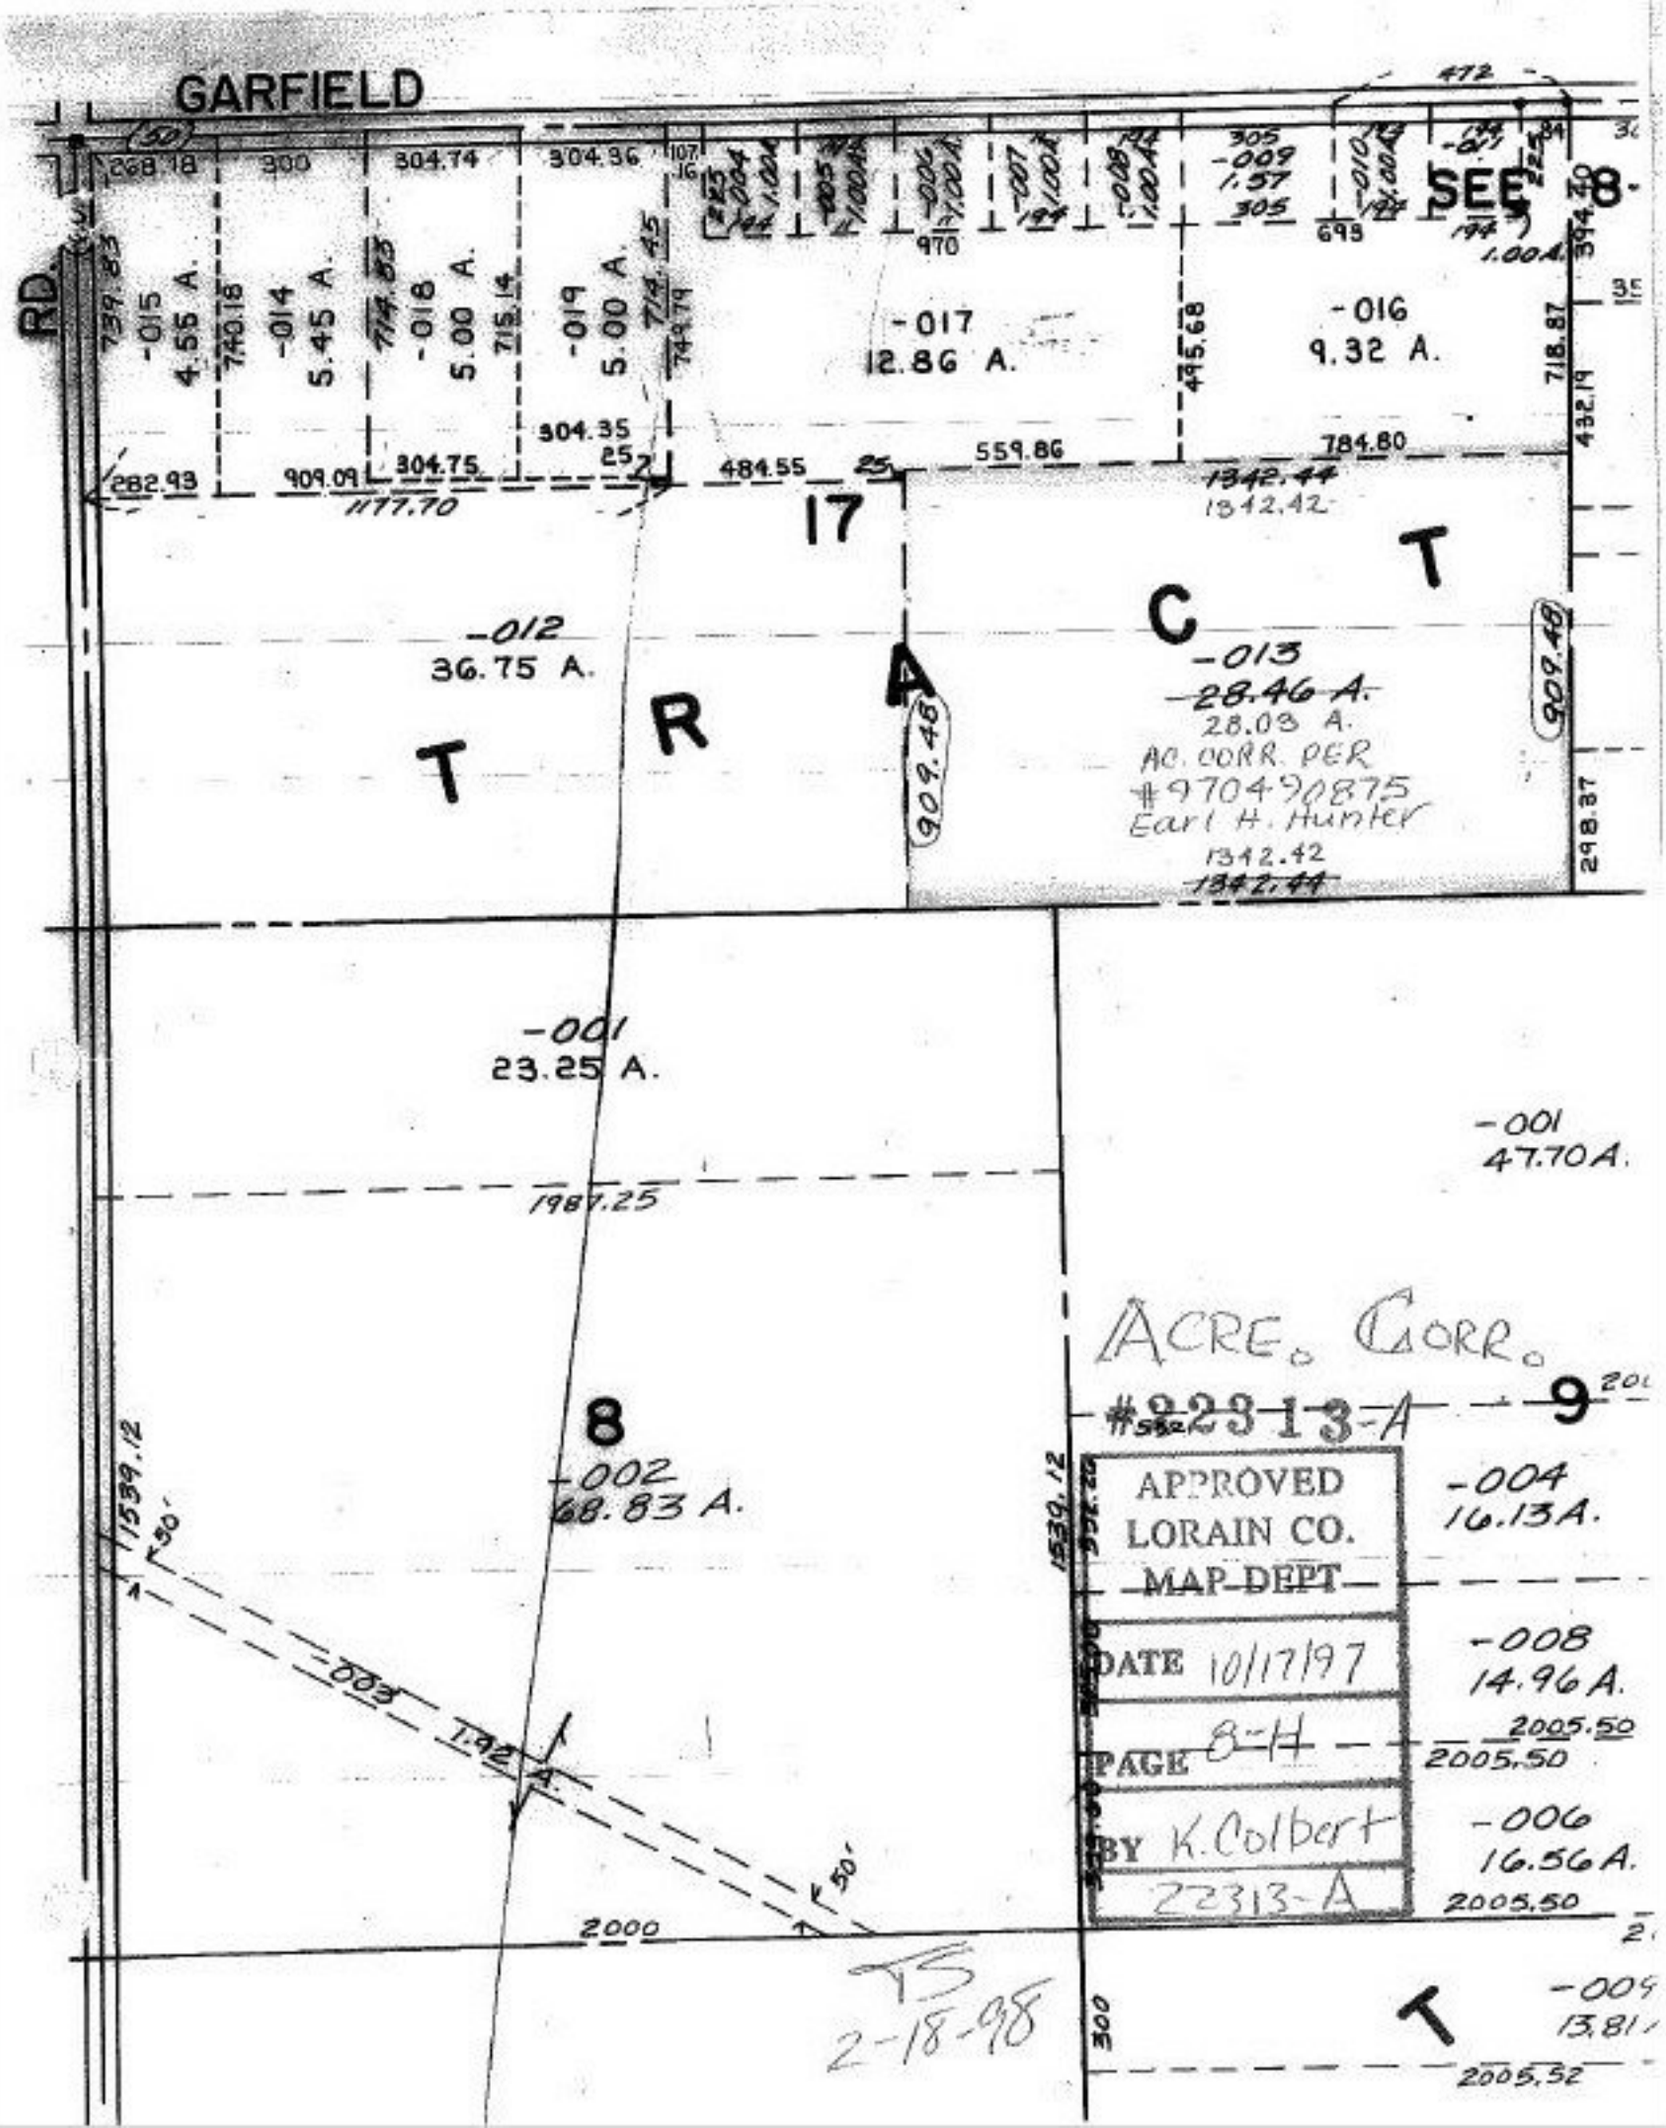
GARFIELD
RD.
SEE 8
-015
4.55 A.
-014
5.45 A.
-018
5.00 A.
-019
5.00 A.
-017
12.86 A.
-016
9.32 A.
-012
36.75 A.
-013
-28.46 A.
28.03 A.
AC. CORR. PER
#9704900875
Earl H. Hunter
-001
23.25 A.
-001
47.70A.
8
-002
68.83 A.
-003
1.92 A.
9
-004
16.13A.
-008
14.96 A.
-006
16.56A.
-009
13.81
APPROVED
LORAIN CO.
MAP DEPT
DATE 10/17/97
PAGE 8-H
BY K.Colbert
22313-A
ACRE. CORR.
#22313-A
2-18-98