#22 313

#22313

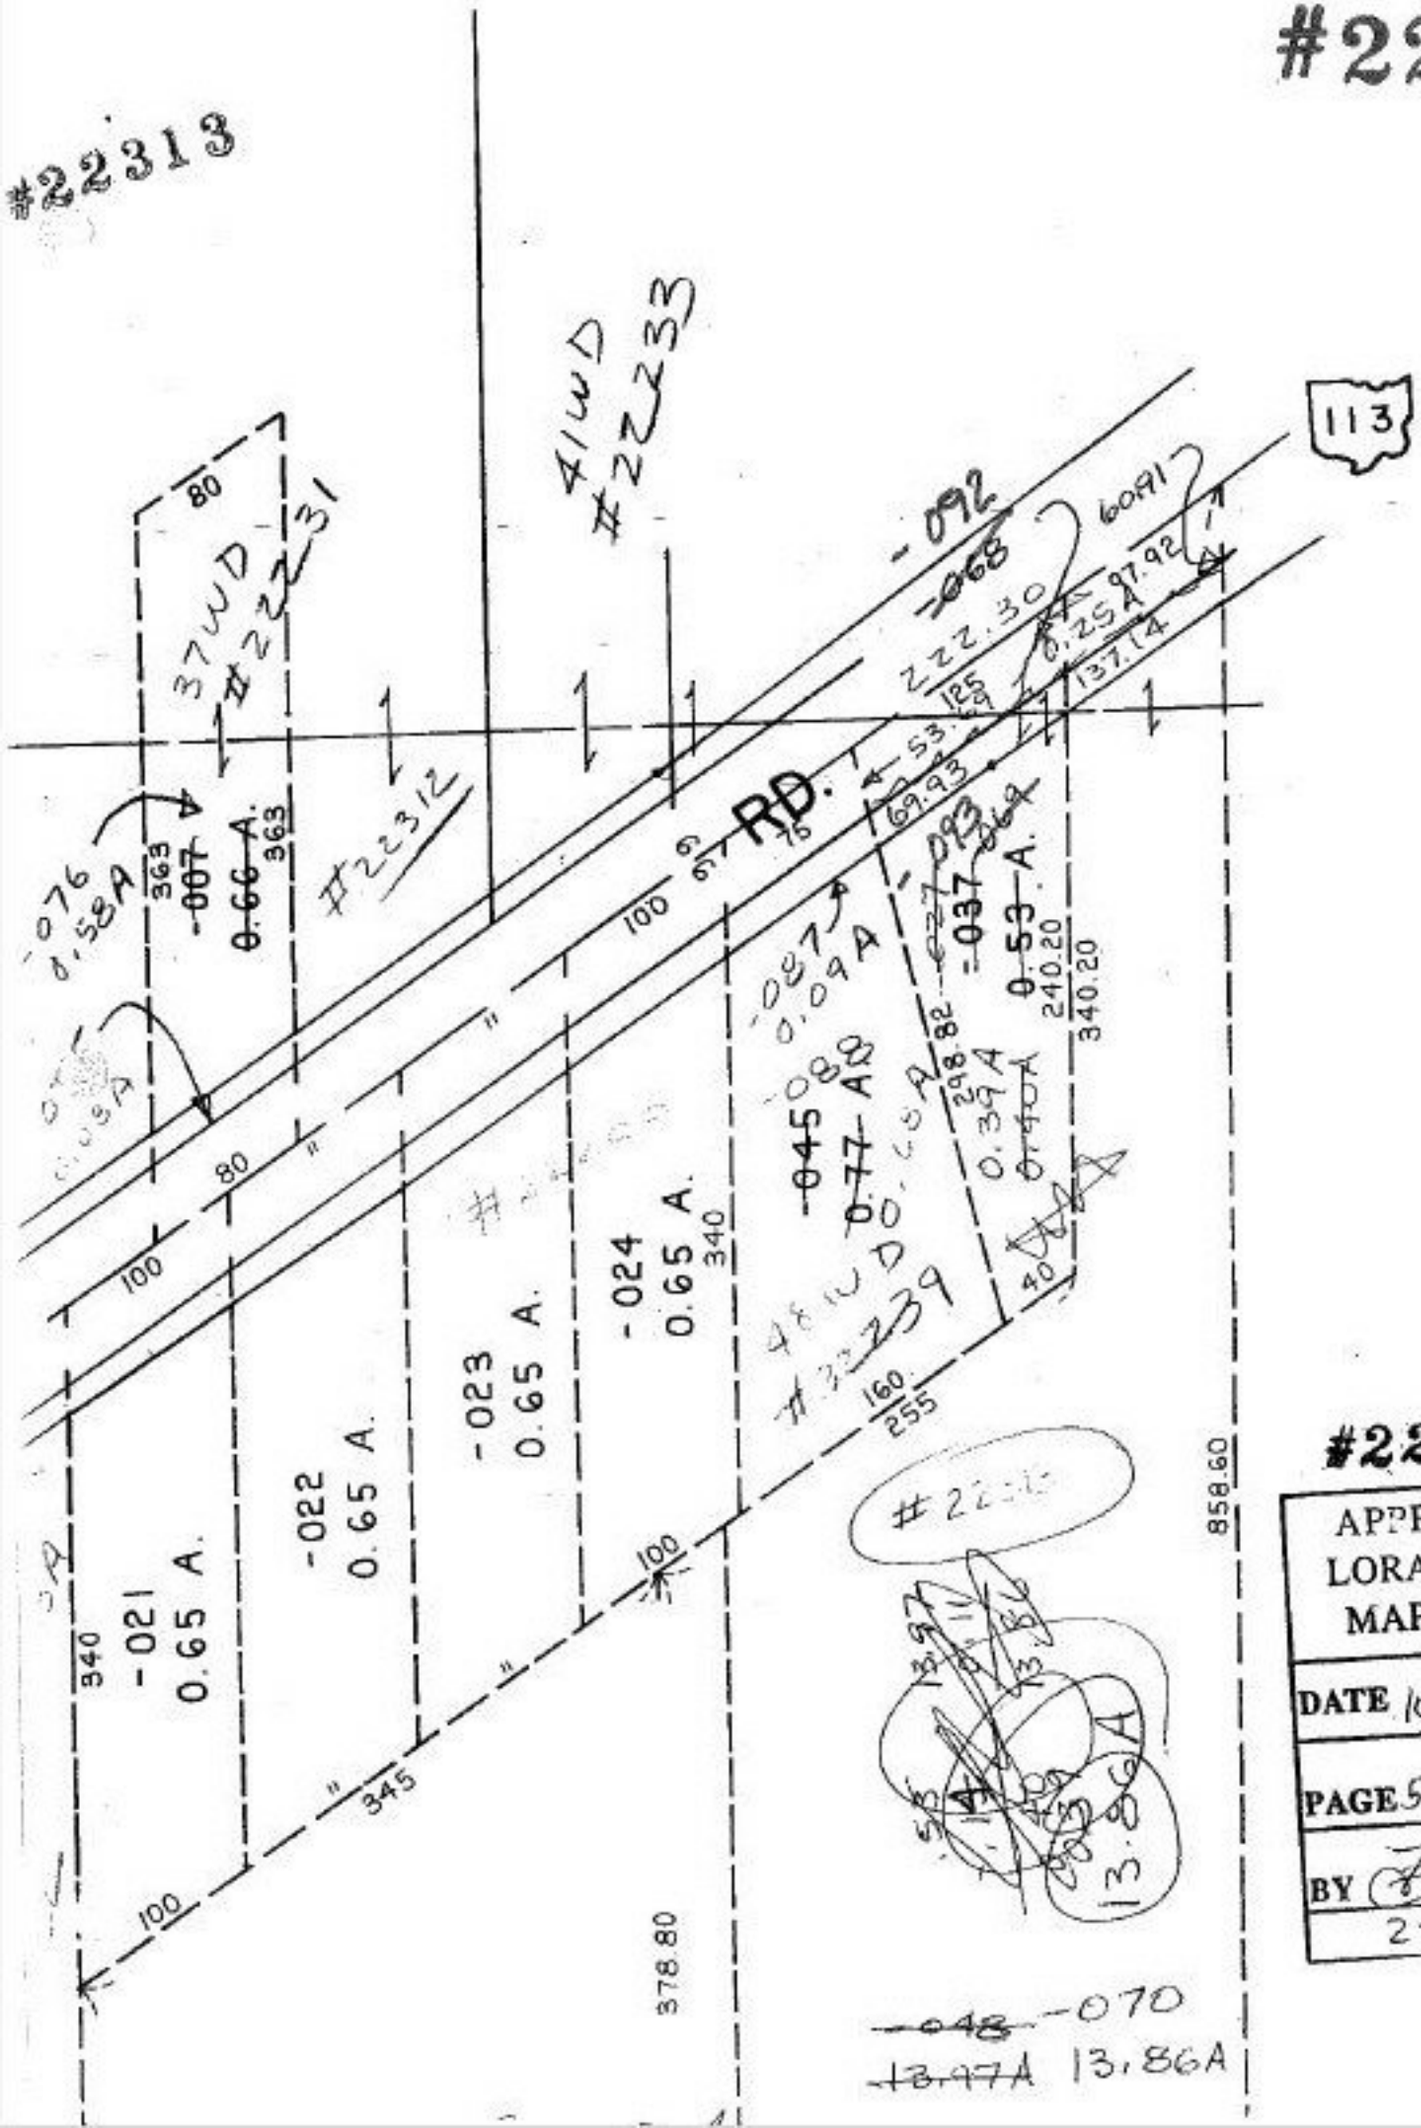

#22313

APPROVED
LORAIN CO.
MAP DEPT

DATE 10-21-97

PAGE 5006032-A

BY

22313