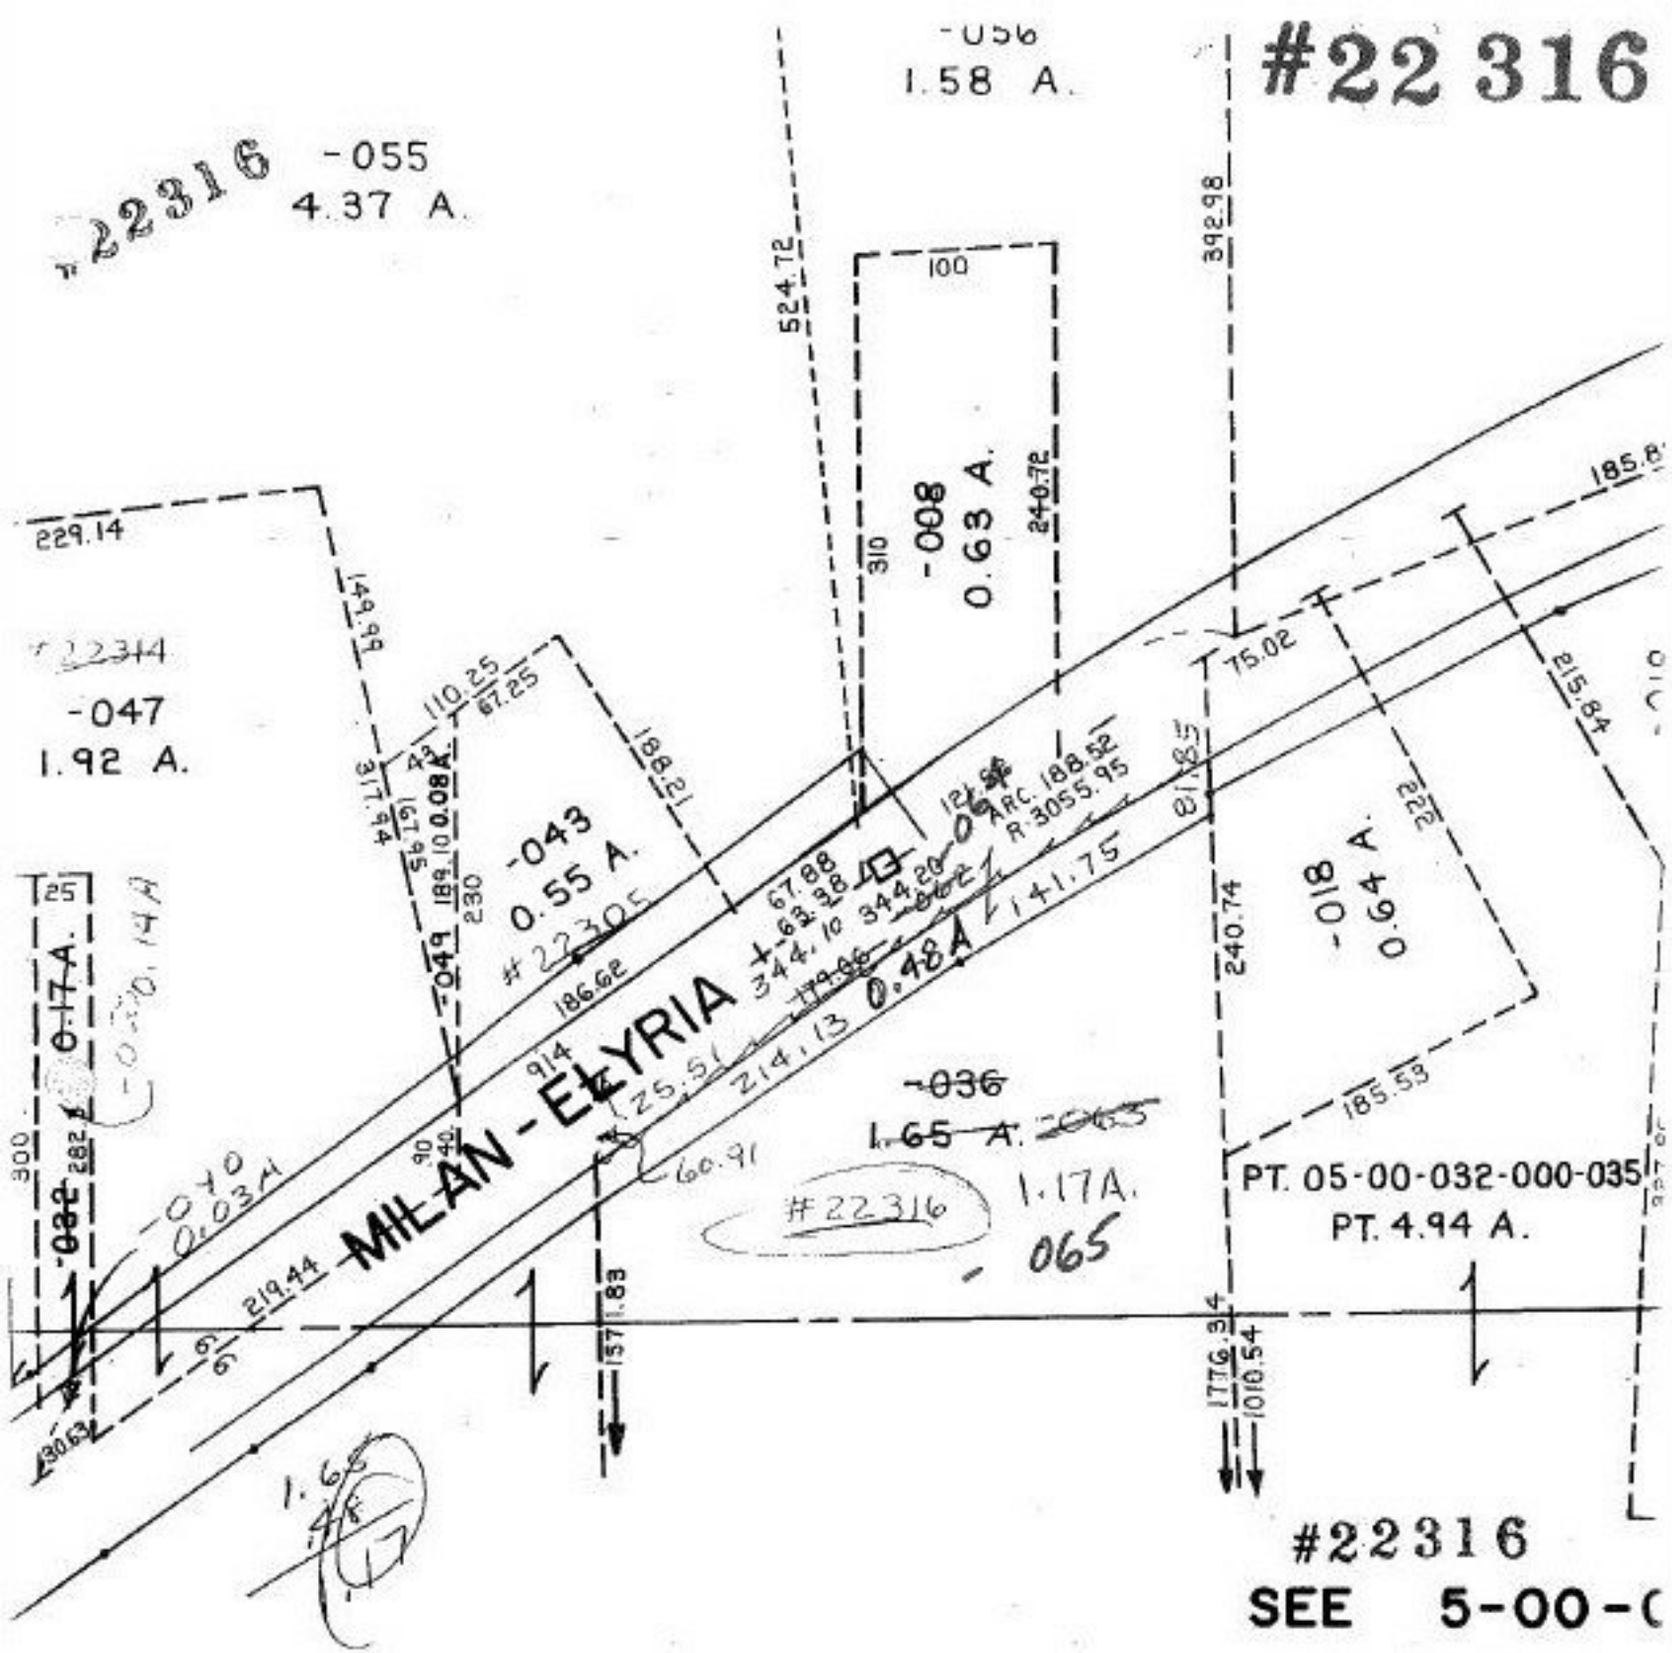

AMHERST TWP.

SCALE: 1" = 100'

APPROVED
LORAIN CO.
MAP DEPT

DATE 10-21-97

PAGE 5-00-033

BY

22316