#22343

NO. 22343

PARENT PARCEL: 04-00-007-150-007, 008, 009, 035 *** see below ***

CHILD PARCEL: 04-00-007-150-082, 083, 04-00-008-101-049

STARTING POINT: cL of Walker Rd. & cL of Moore Rd.

*** Parent par. cont. 04-00-008-101-005, 025, 026, 038, 04-00-008-102-001, 003, 004, 005, 007 thru 011, 04-00-008-103-001, 002

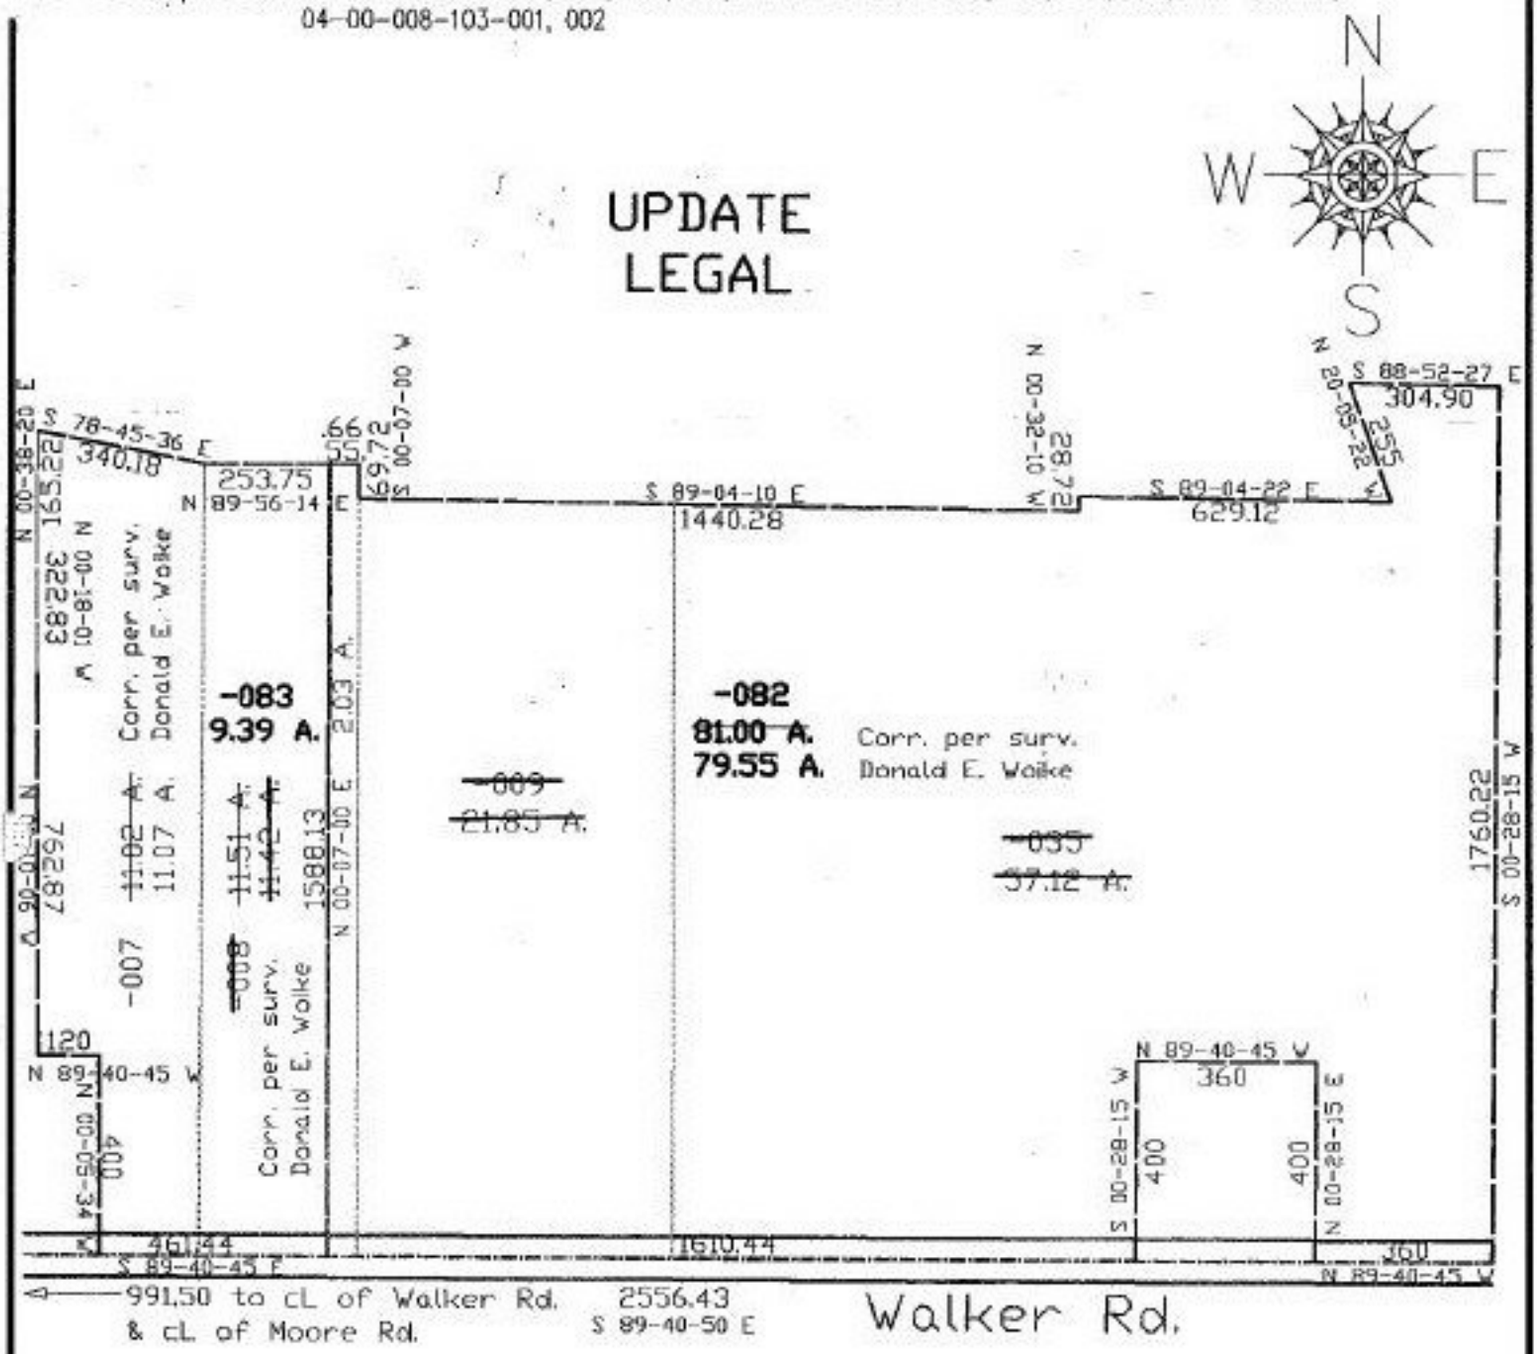

Prior Instruments:
970485733
970493583

MAP (1) OF (3)

SPLITS/DEEDS PROCESSED
LORAIN COUNTY TAX MAP DEPARTMENT
226 MIDDLE AVE. ELYRIA, OHIO

SURVEYED BY: Donald E. Waike
CLOSURE: 0.01:10,000
MAP PAGE(S): 4-8, 04-00-007-E,F,G, 04-00-008-A,B
APPROVED BY: kac DATE: 11/6/97
SCALE: 1" = 400 PRIOR INSTRUMENT: